


#2018  
12-28-99  
C.C.

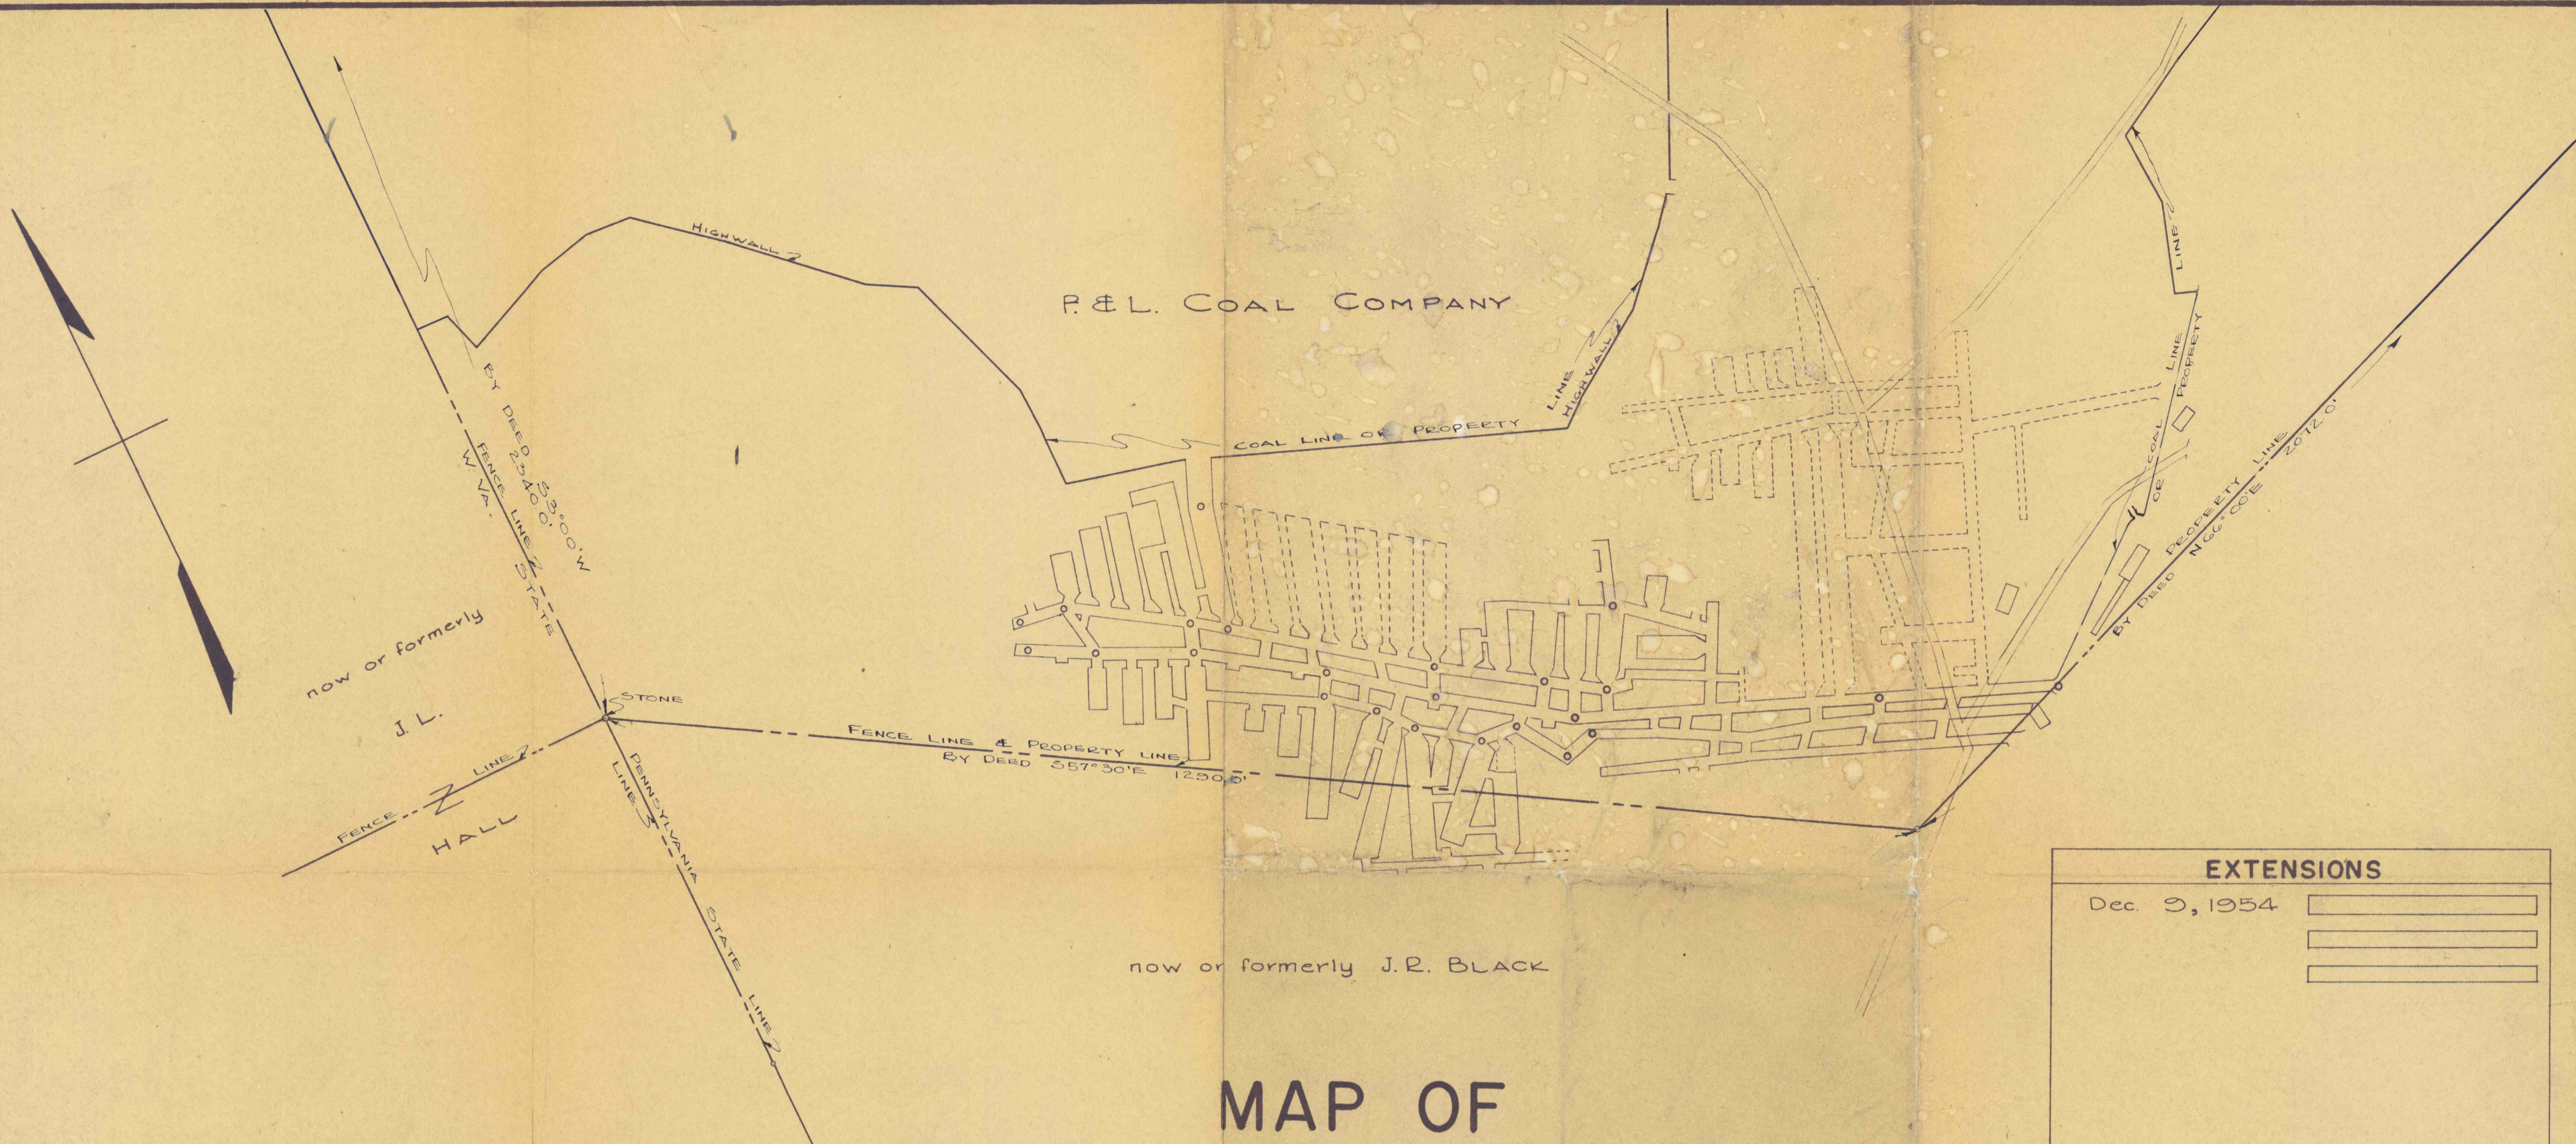

MAP OF  
**P. & L. COAL COMPANY'S MINE**  
 JEFFERSON TOWNSHIP, WASHINGTON COUNTY, PA.



EXTENSIONS	
Dec. 9, 1954	<input type="text"/>
	<input type="text"/>
	<input type="text"/>

*Pittsburgh Seam*

I hereby certify that this map is true and correct to the best of my knowledge and belief.

*J. James Schellhase* W. Va. Reg. Engr. No. 1673

Acknowledged before me a Notary Public this 9th day of September, 1957.

My commission expires: Oct. 18, 1958

*James T. Chircumber*  
 Notary Public of, in and for  
 Ohio County, West Virginia