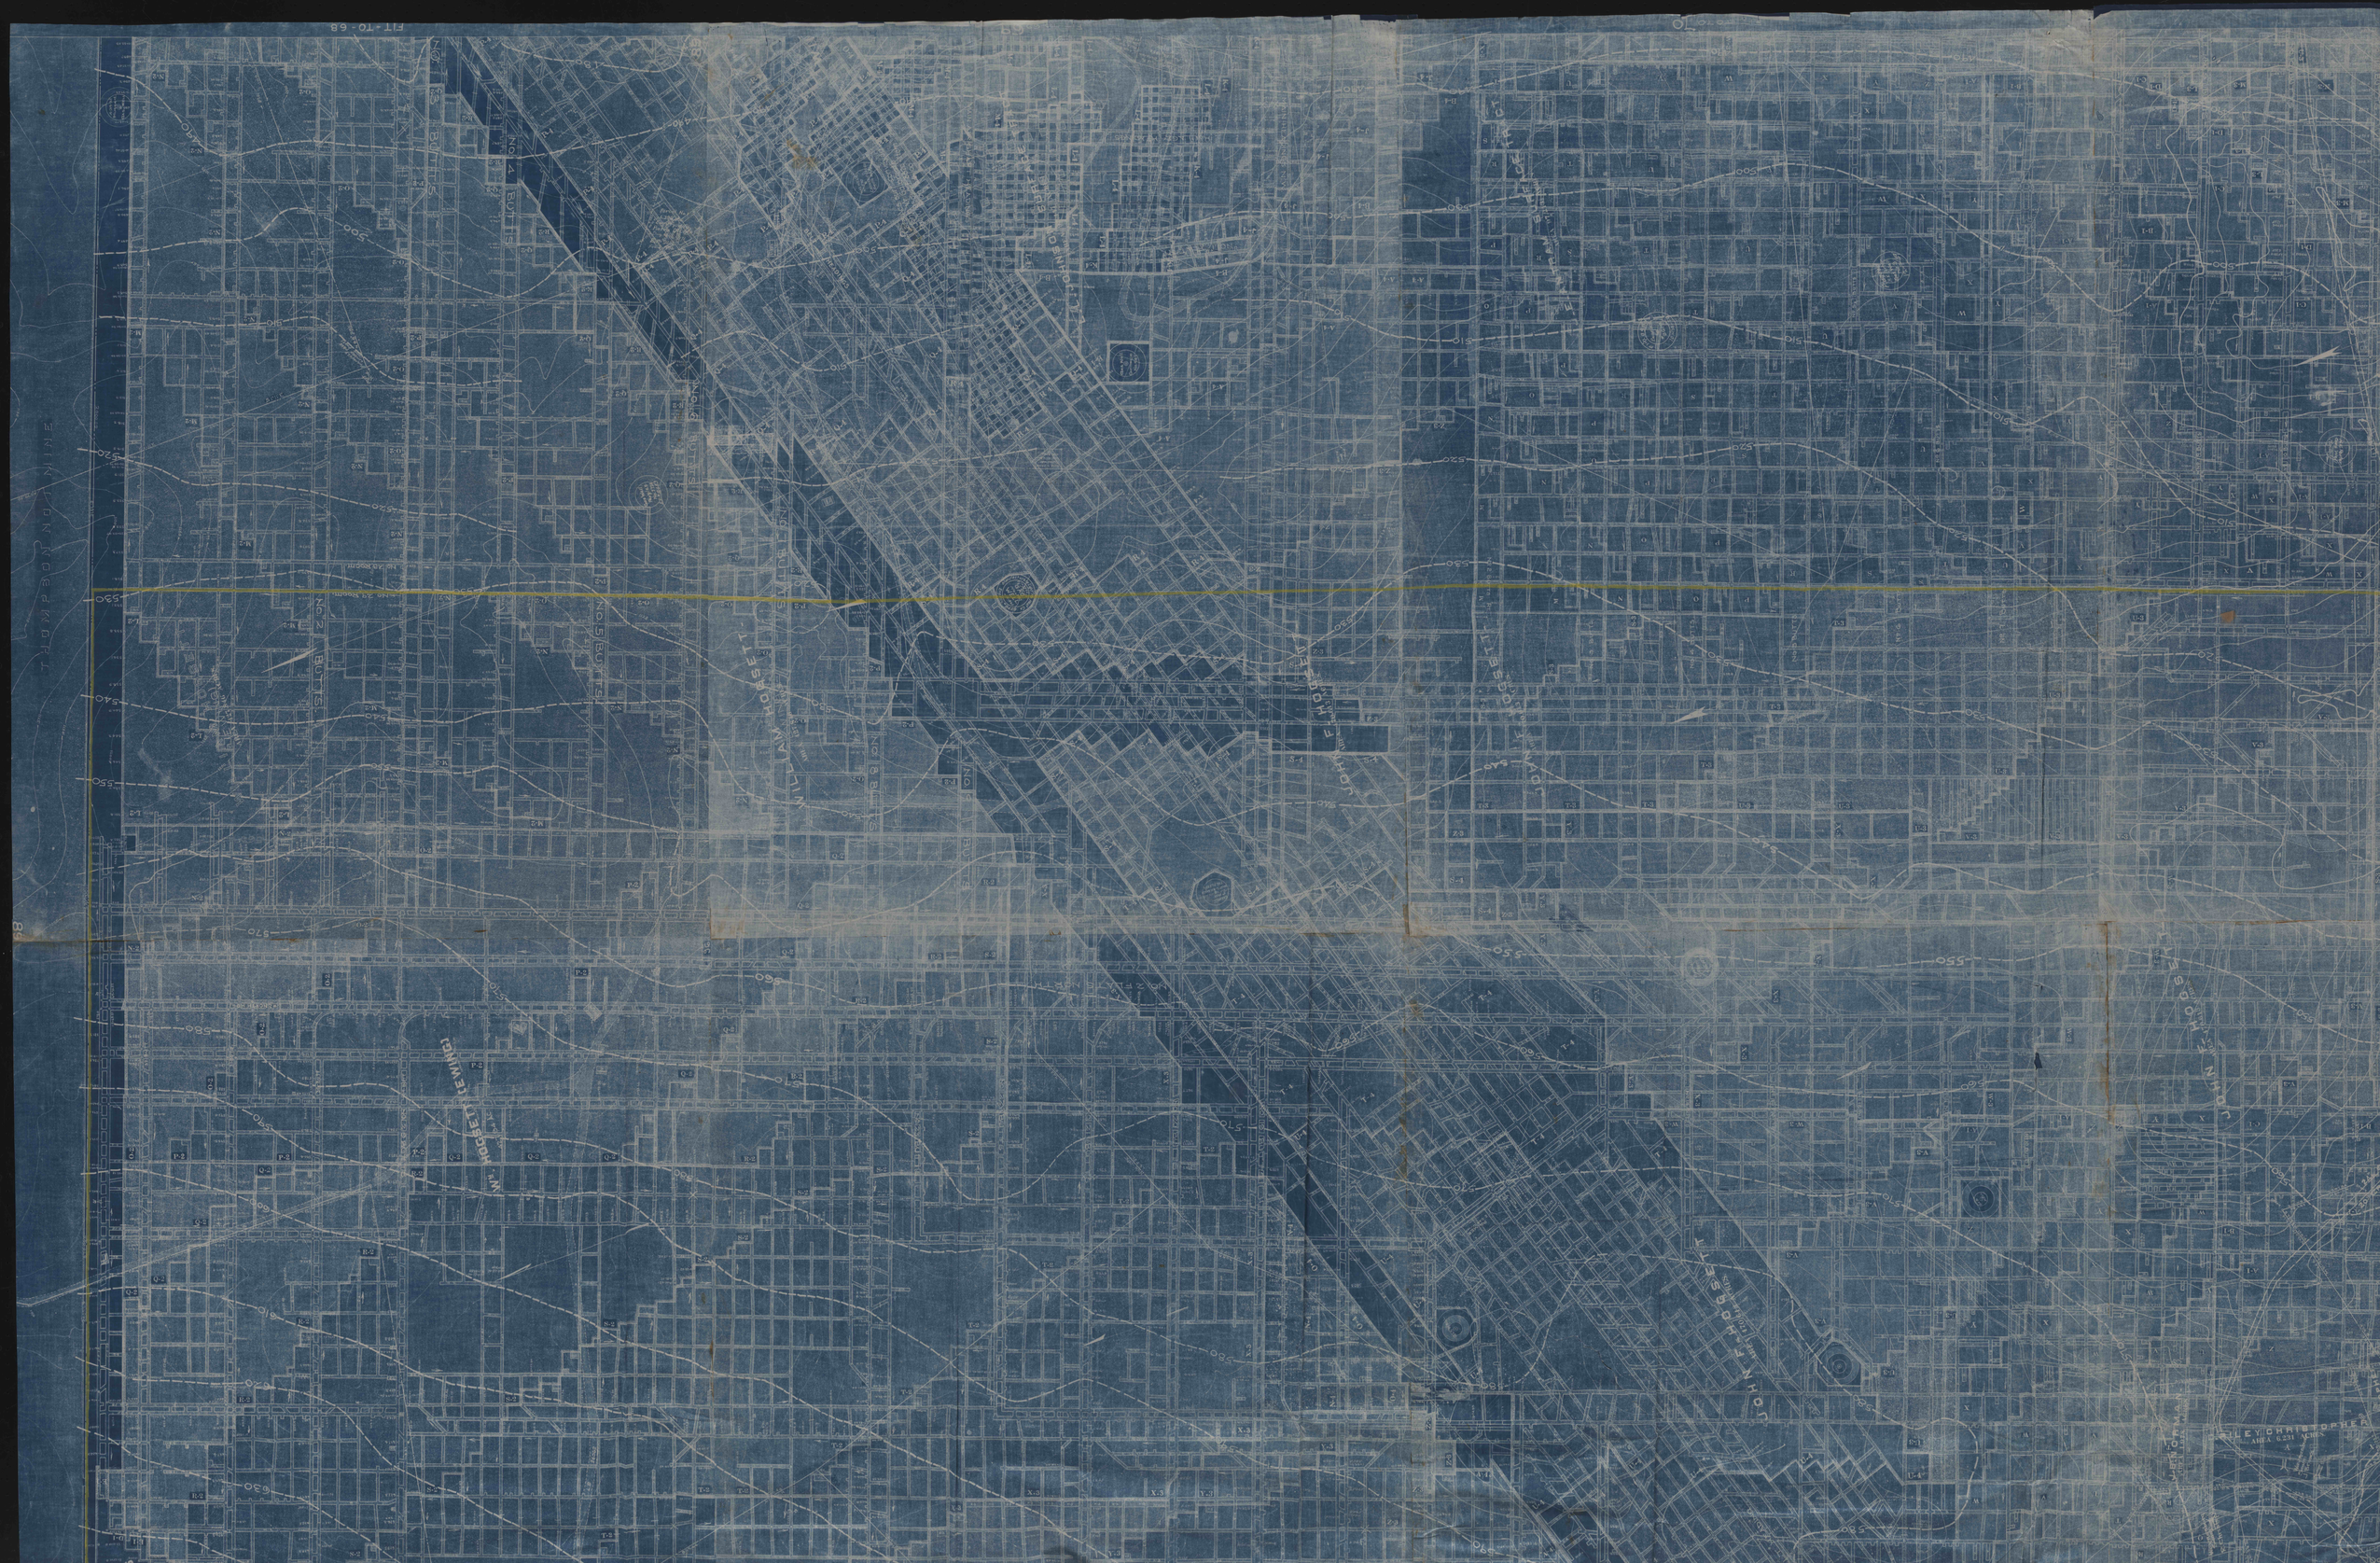
FIT-TO-68
No. 4 BUTTS
No. 2 BUTTS
No. 5 BUTTS
WILLIAM HOGSETT
JOHN F. HOGSETT
W. HOGSETT (EWING)
JOHN F. HOGSETT
BILEY CHRISTOPHER
AREA 6.231 ACRES