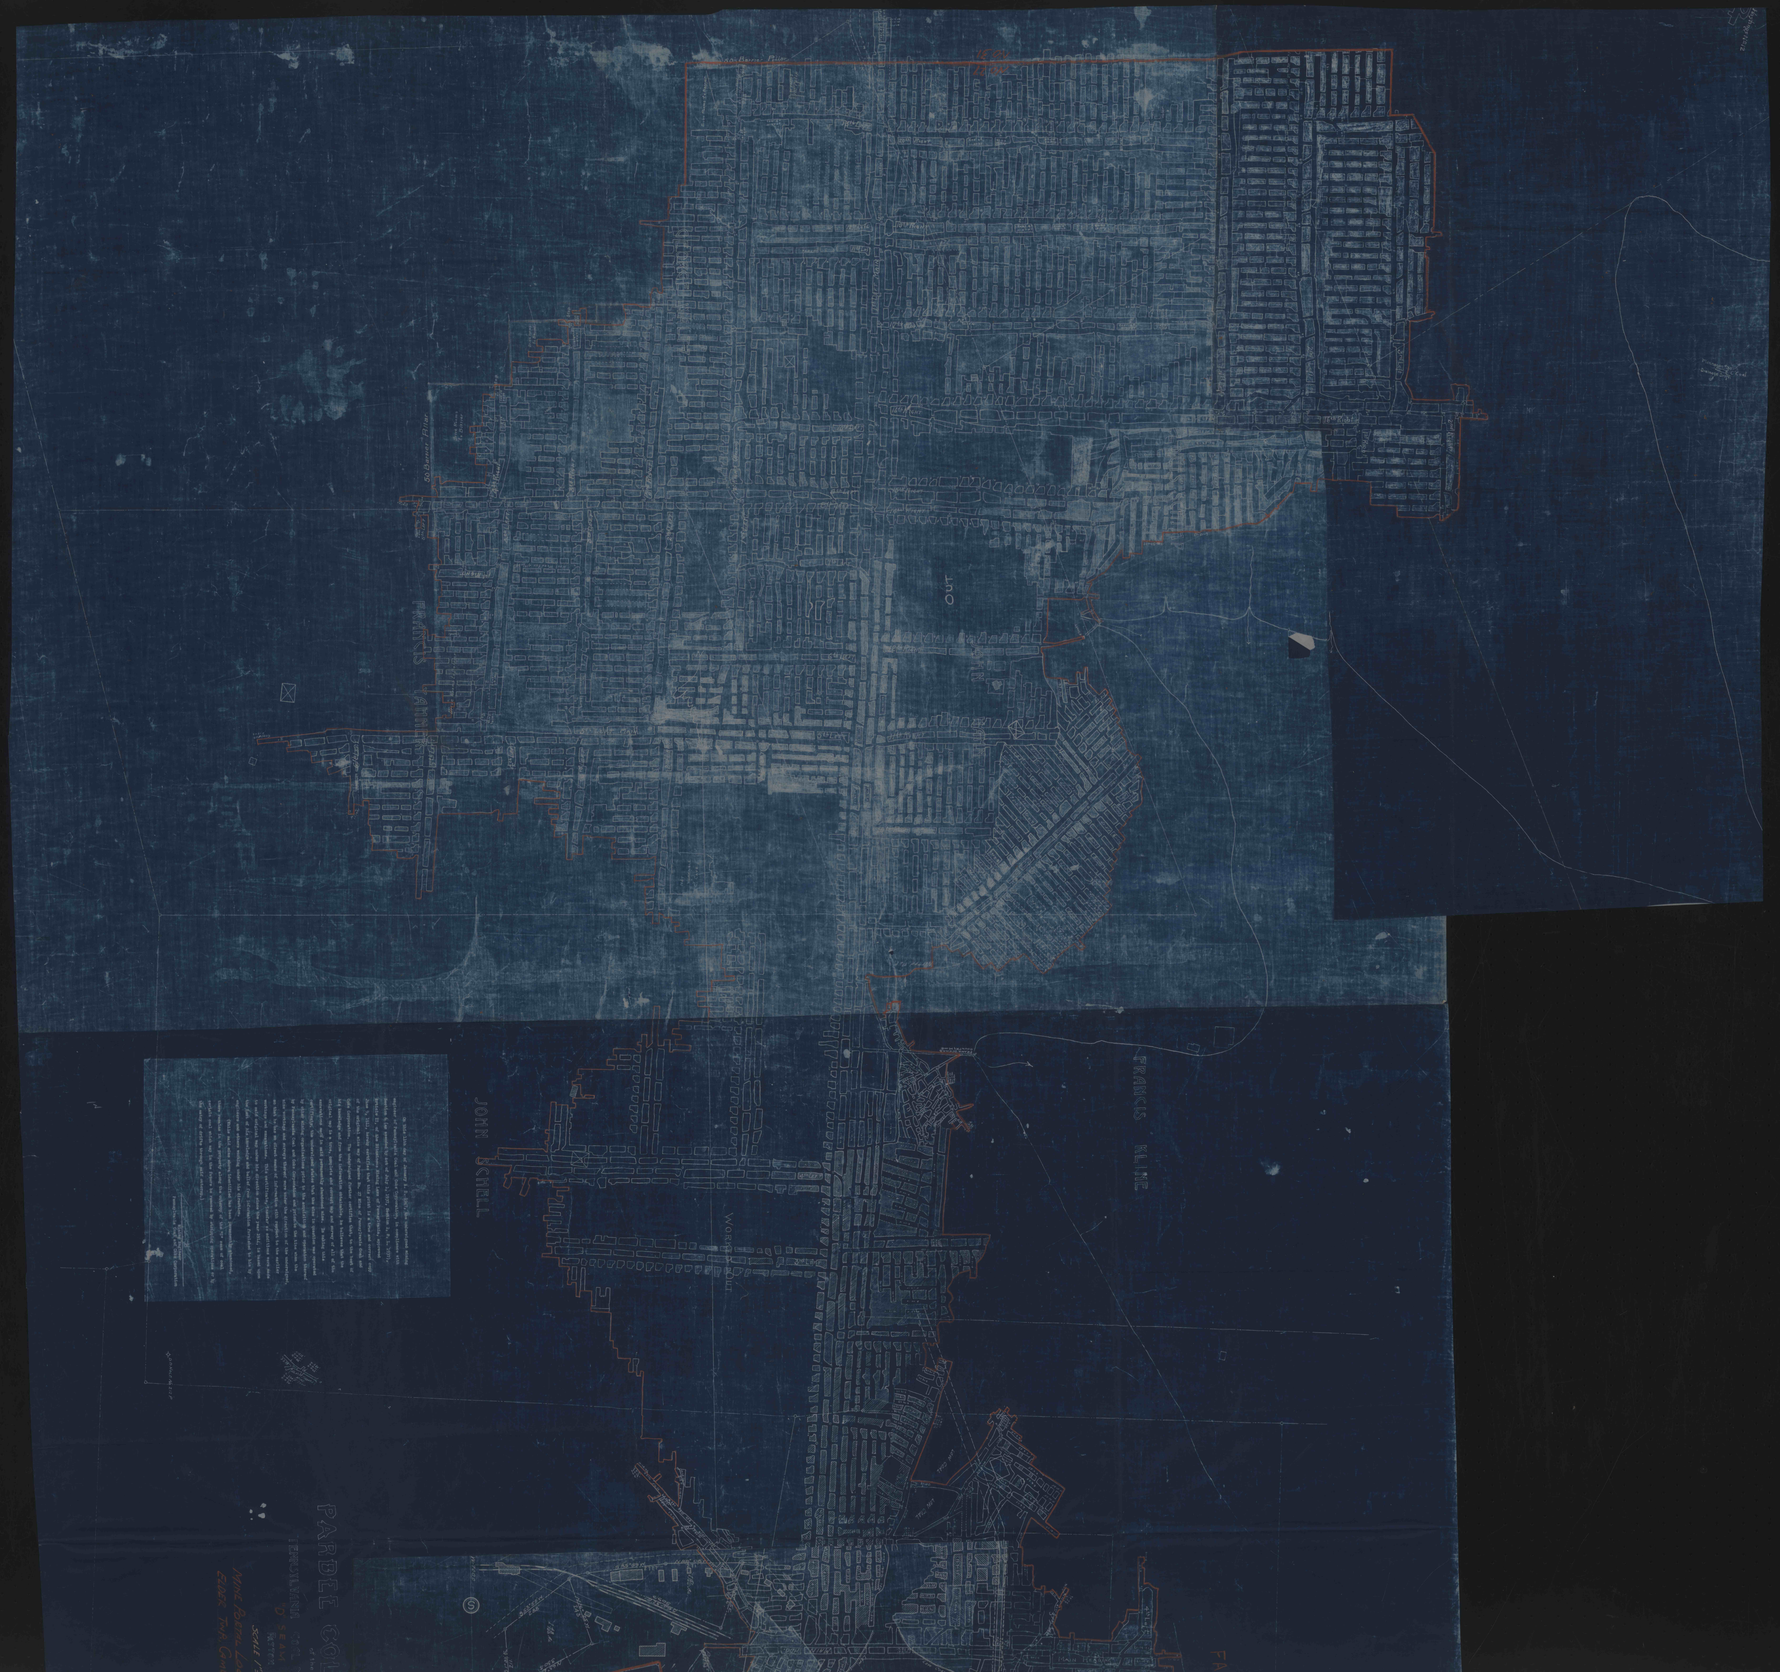
JOHN SCHELL
FRANCIS KLINE
PARDEE