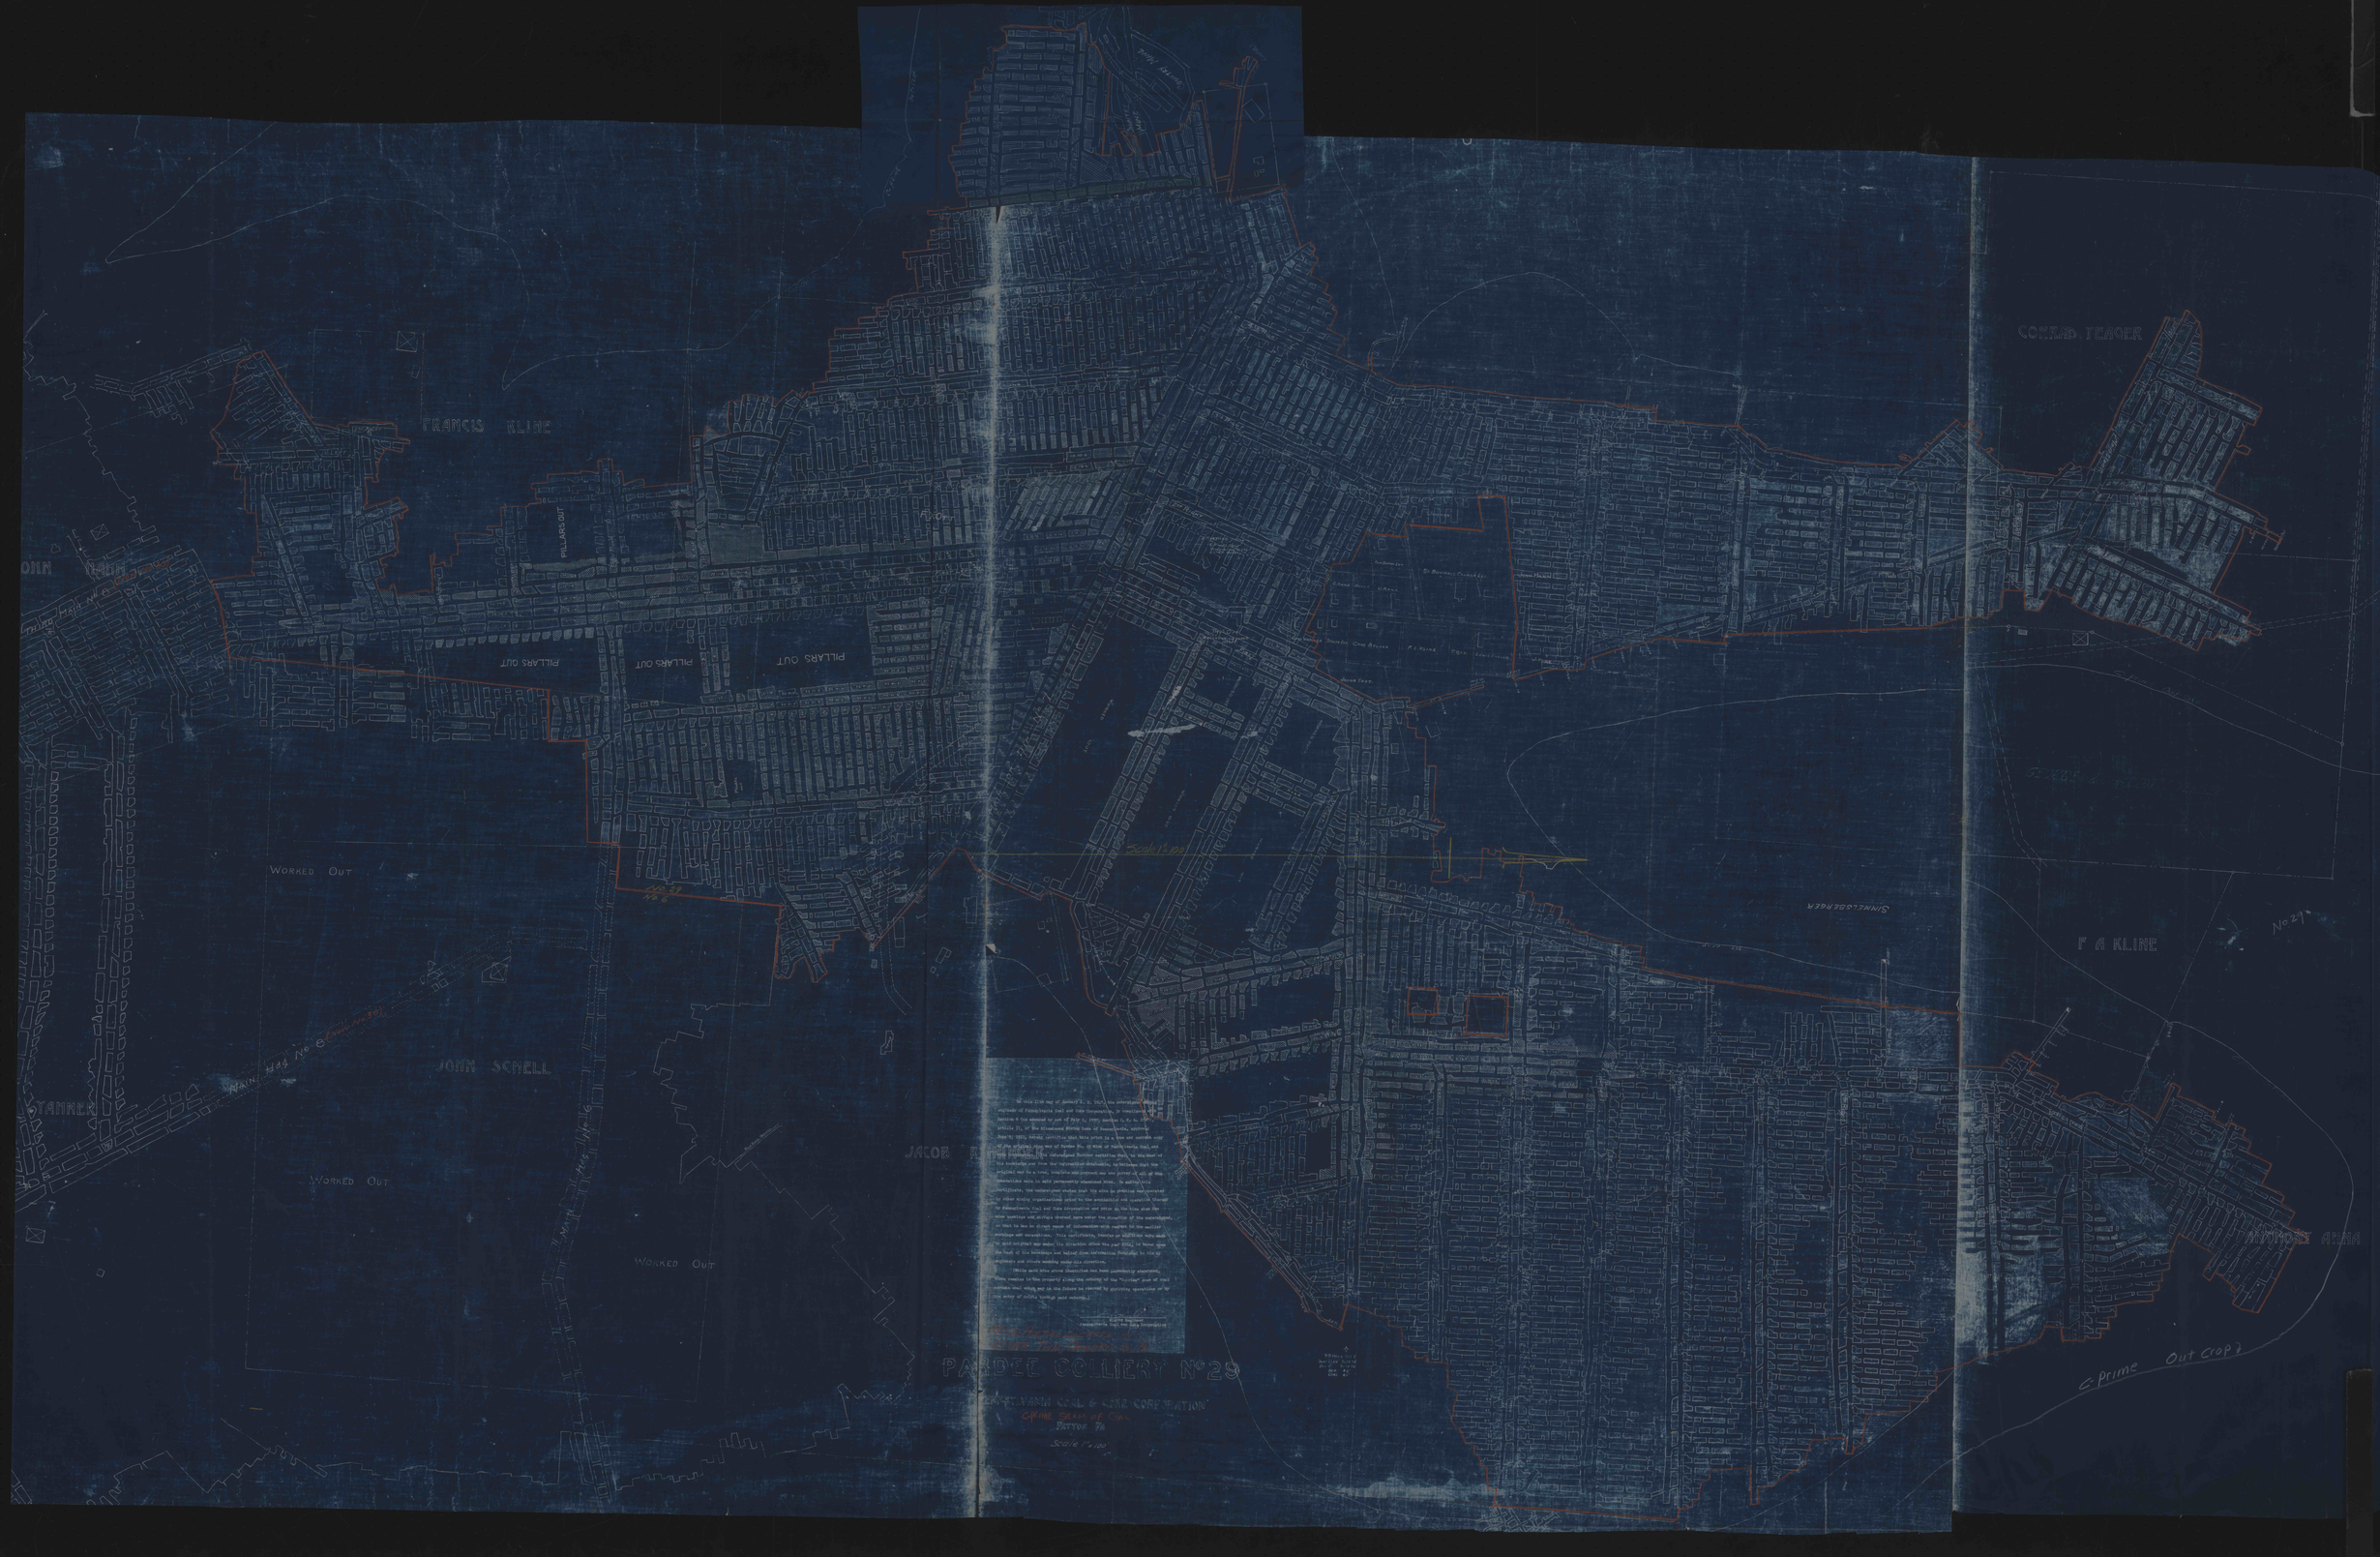
FRANCIS KLINE
PILLARS OUT
PILLARS OUT
PILLARS OUT
PILLARS OUT
WORKED OUT
WORKED OUT
WORKED OUT
JOHN SCHELL
JACOB
STANNER
CONRAD TEAGER
F A KLINE
No 29
Prime Out Crop
PARDEE COLLIERY No 29
Scale 1"=100'