




BURNSIDE

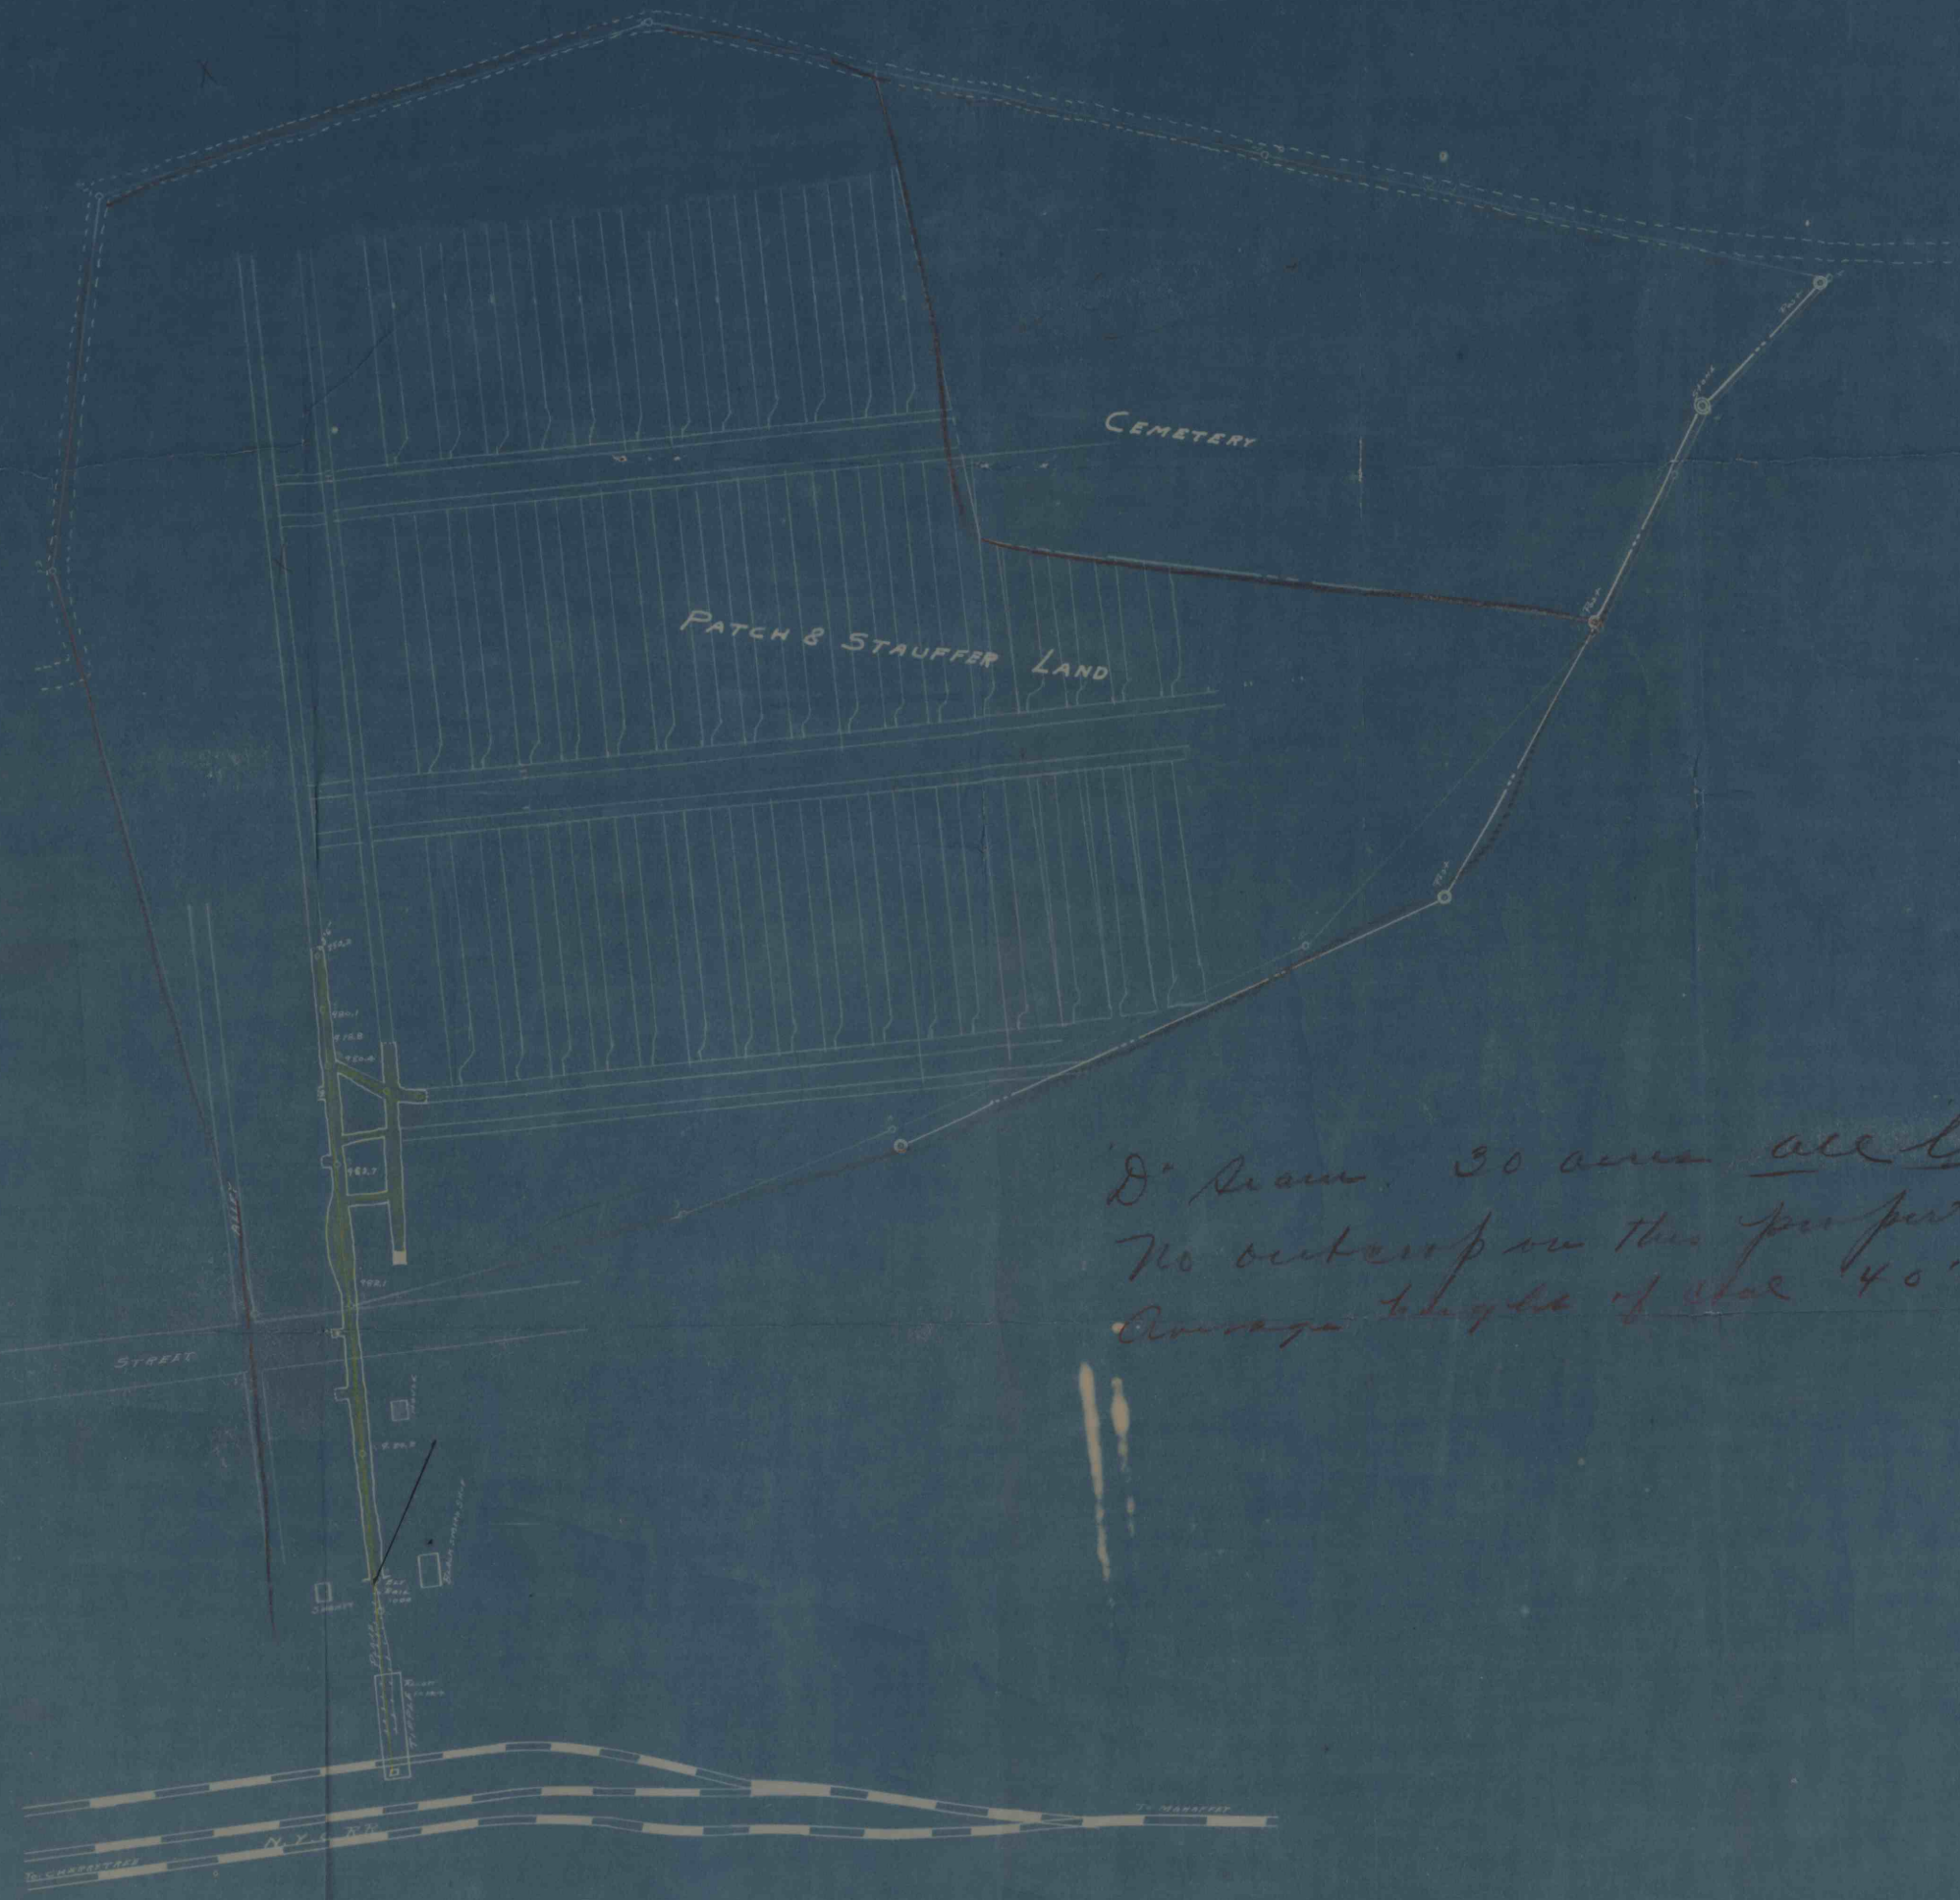

D. Shaw, 30 acres all leased.
No outcrop on this property.
Average depth of coal 40"

MAP OF NO. 2 MINE
PATCH IN COAL COMPANY
BURNSIDE, CLEARFIELD CO., PA.

Scale 1" = 100'
Office of
Patch In Coal Co.
Clearfield, Pa.
Map No. 101