


*Paul R. Toth Coal Smithston, Pa.*

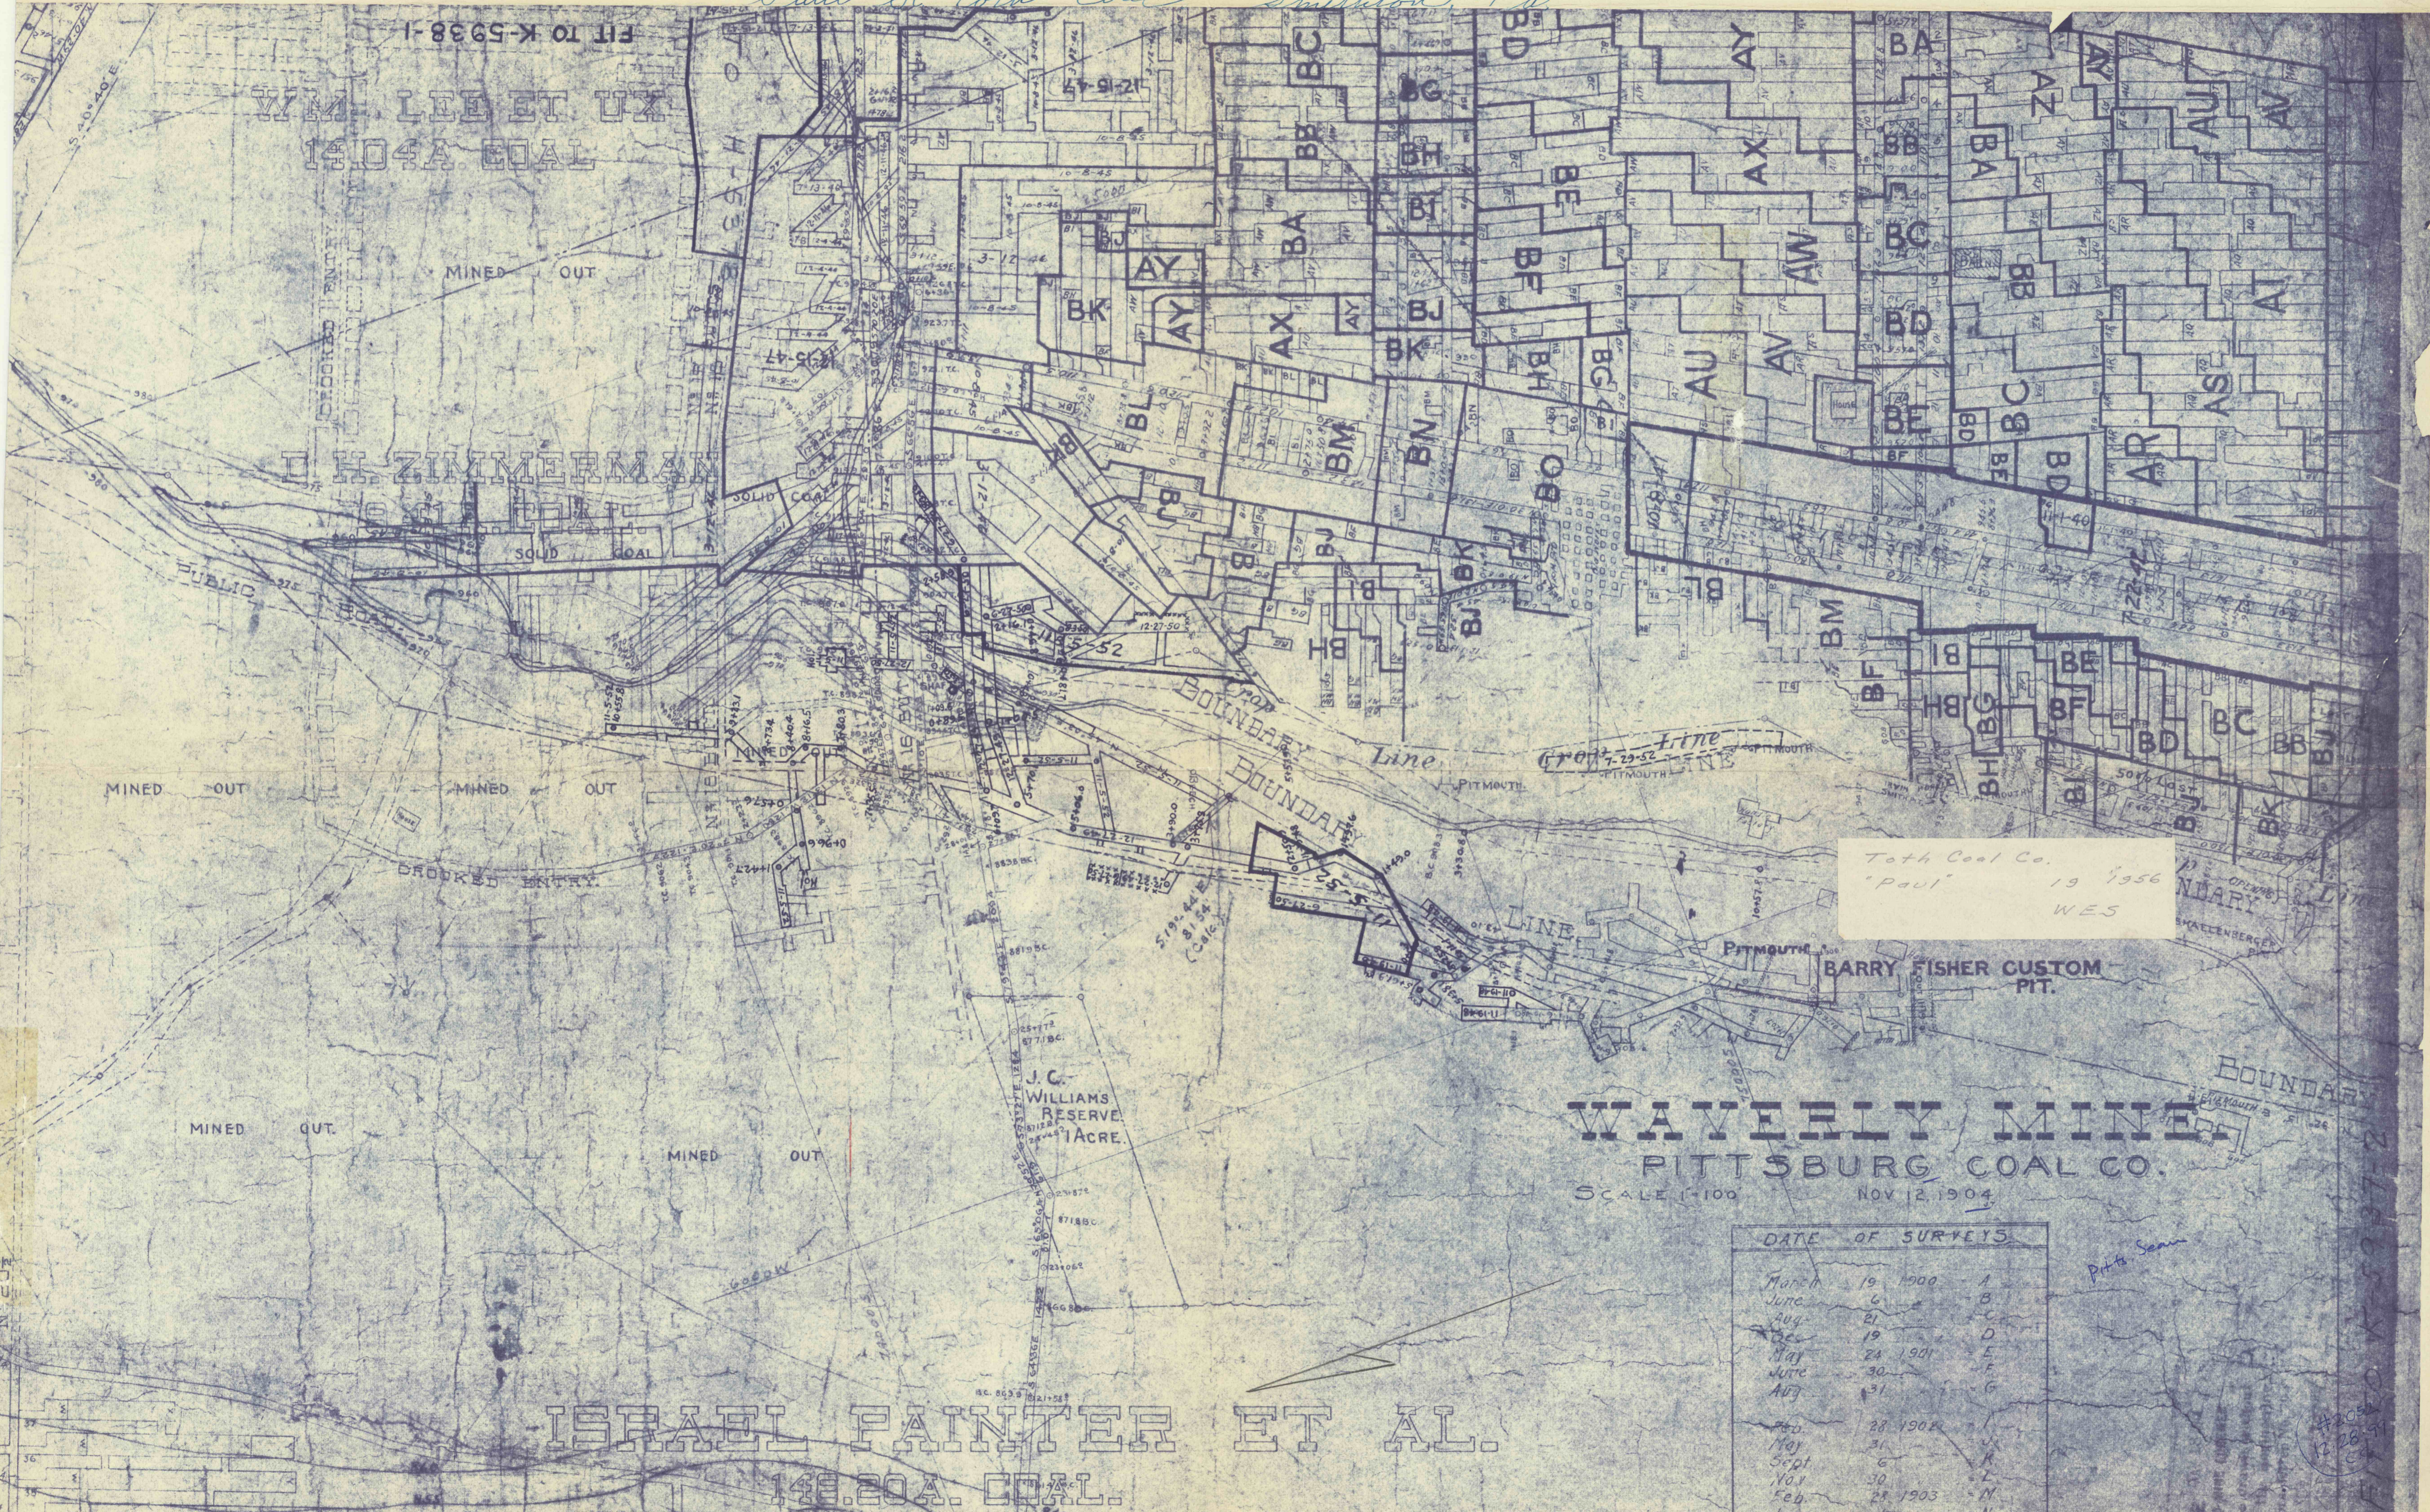

Toth Coal Co.  
"Paul" 19 1956  
WES

**WAVEIRLY MINE**  
**PITTSBURG COAL CO.**  
SCALE 1-100 NOV 12 1904

DATE OF SURVEYS

March	19 1900	A
June	6	B
Aug	21	C
Dec	19	D
May	24 1901	E
June	30	F
Aug	31	G
Feb	28 1902	H
May	31	I
Sept	6	J
Nov	30	K
Feb	28 1903	L
July		M

*Pitts Sewer*

**ISRAEL PAINTER ET AL.**  
**148.20A. COAL.**

#305  
12-28-91  
CC