

T-462

1.81 AC

OUTCROP  
ELEVATION 938 FT

T. LOKOMSKI  
29 AC.

T-385

GREENE TWP.  
RACCOON TWP.

3 AC.

HUGHES  
5.49 AC.

FAULT

NEWTON  
88 AC.

8.66 AC.

6 MONTHS PROJECTION

6 MONTHS PROJECTION

SAM MOORE  
62.3 AC.

T-386

FOR COMPLETE MINE  
SEE SK. 661001-2

GUY MOORE  
104.9 AC.


PEGGS RUN COAL CO  
DEEP MINING OPERATIONS  
MINED AREA AND SIX MONTHS PROJECTION  
MINE SITUATE IN  
GREENE AND RACCOON TOWNSHIP  
BEAVER COUNTY, PENNSYLVANIA  
SCALE 1" = 100' OCT 1, 1967  
THOMAS L. O'NEILL  
MONACA, PA, REG. SURV.

SK 671001

CHEMEL  
2 AC.

- LEGEND
- PROPERTY OUTLINE & BOUNDARY LINE OF PERMIT
  - 6 MONTHS PROJECTION TO 1-1-68
  - STRUCTURES

*Thomas L. O'Neill*

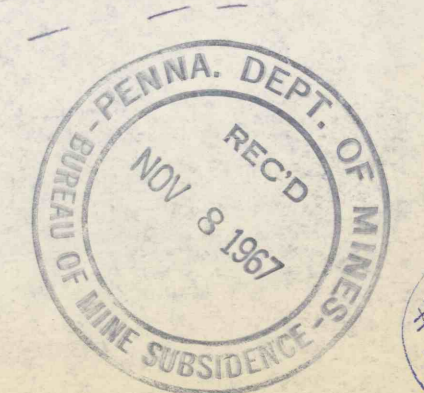

#2068  
12-29-69  
C.C.