


1700

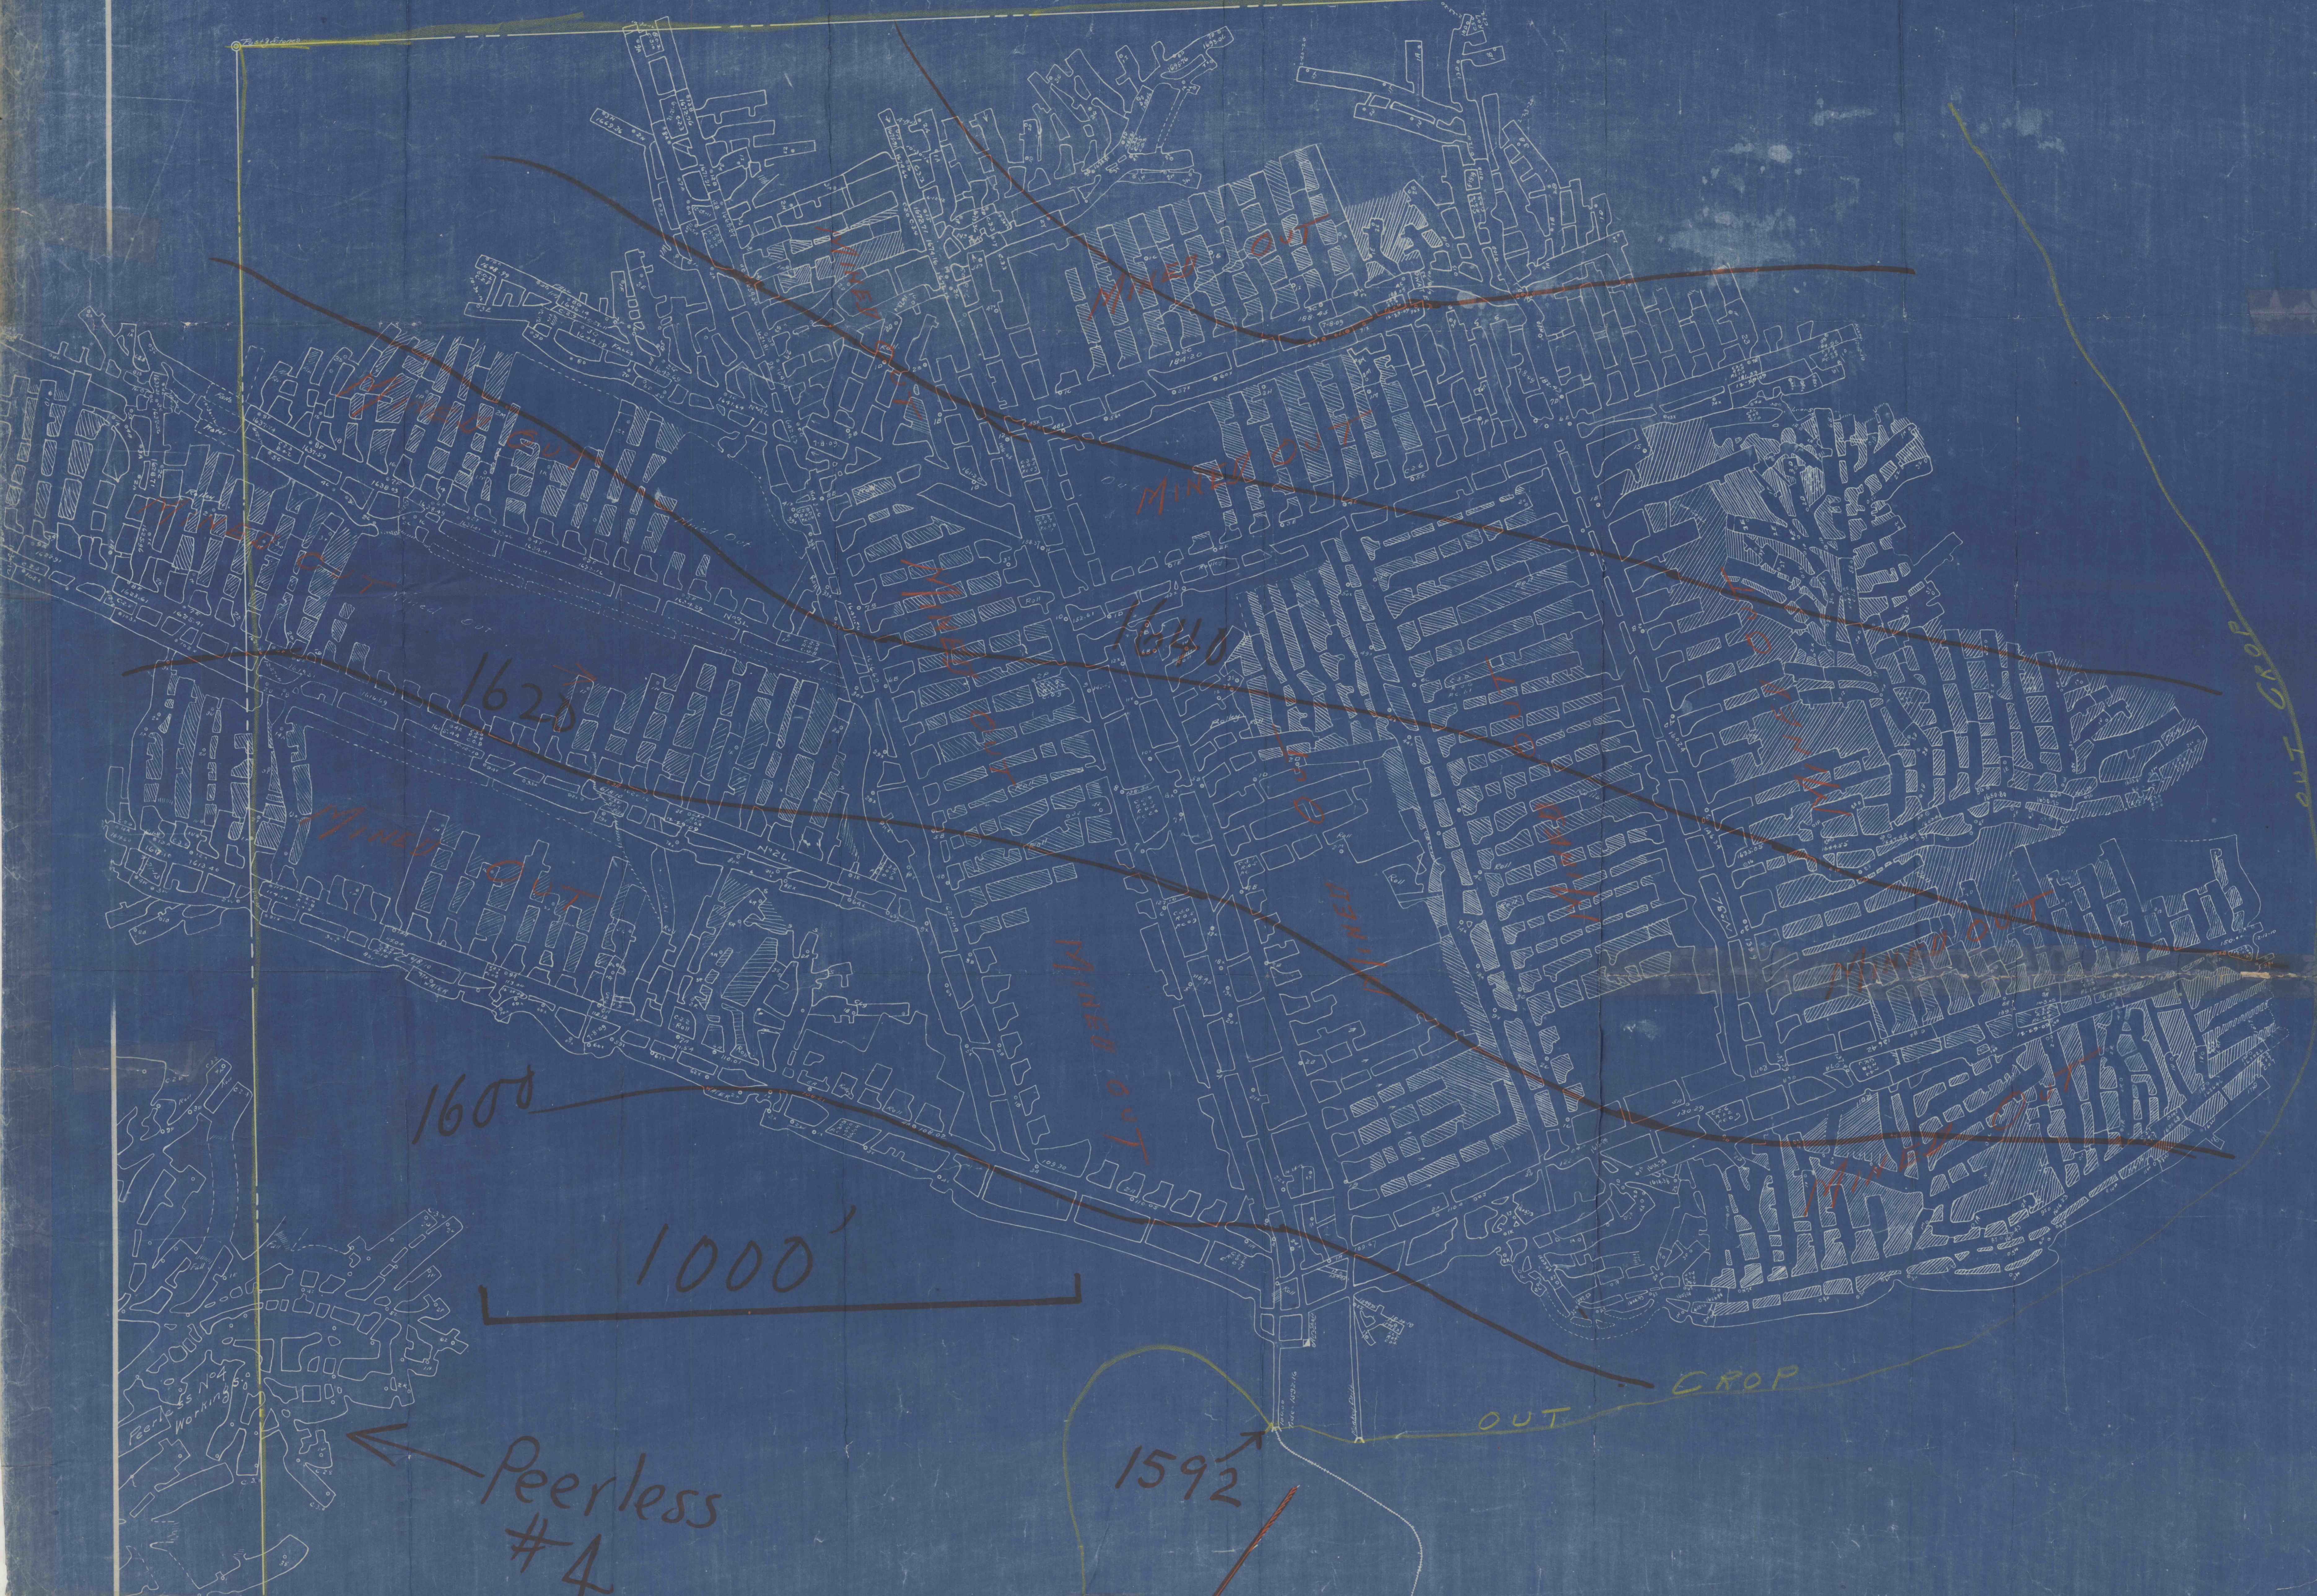

1625

1625

1600

1000'

1592

Peerless #4

MAP  
of  
**PENN MINE No. 4**

OPERATED BY THE  
CLEARFIELD & GRAMPAN COAL CO  
ON LANDS OF  
**P. C. & L. CO.**

Scale: 1 inch = 100 Feet  
F. E. WOMERSLEY, M.E.  
Geologist, P. C. & L. CO.

1909

