



LEASURE

WILMOUTH

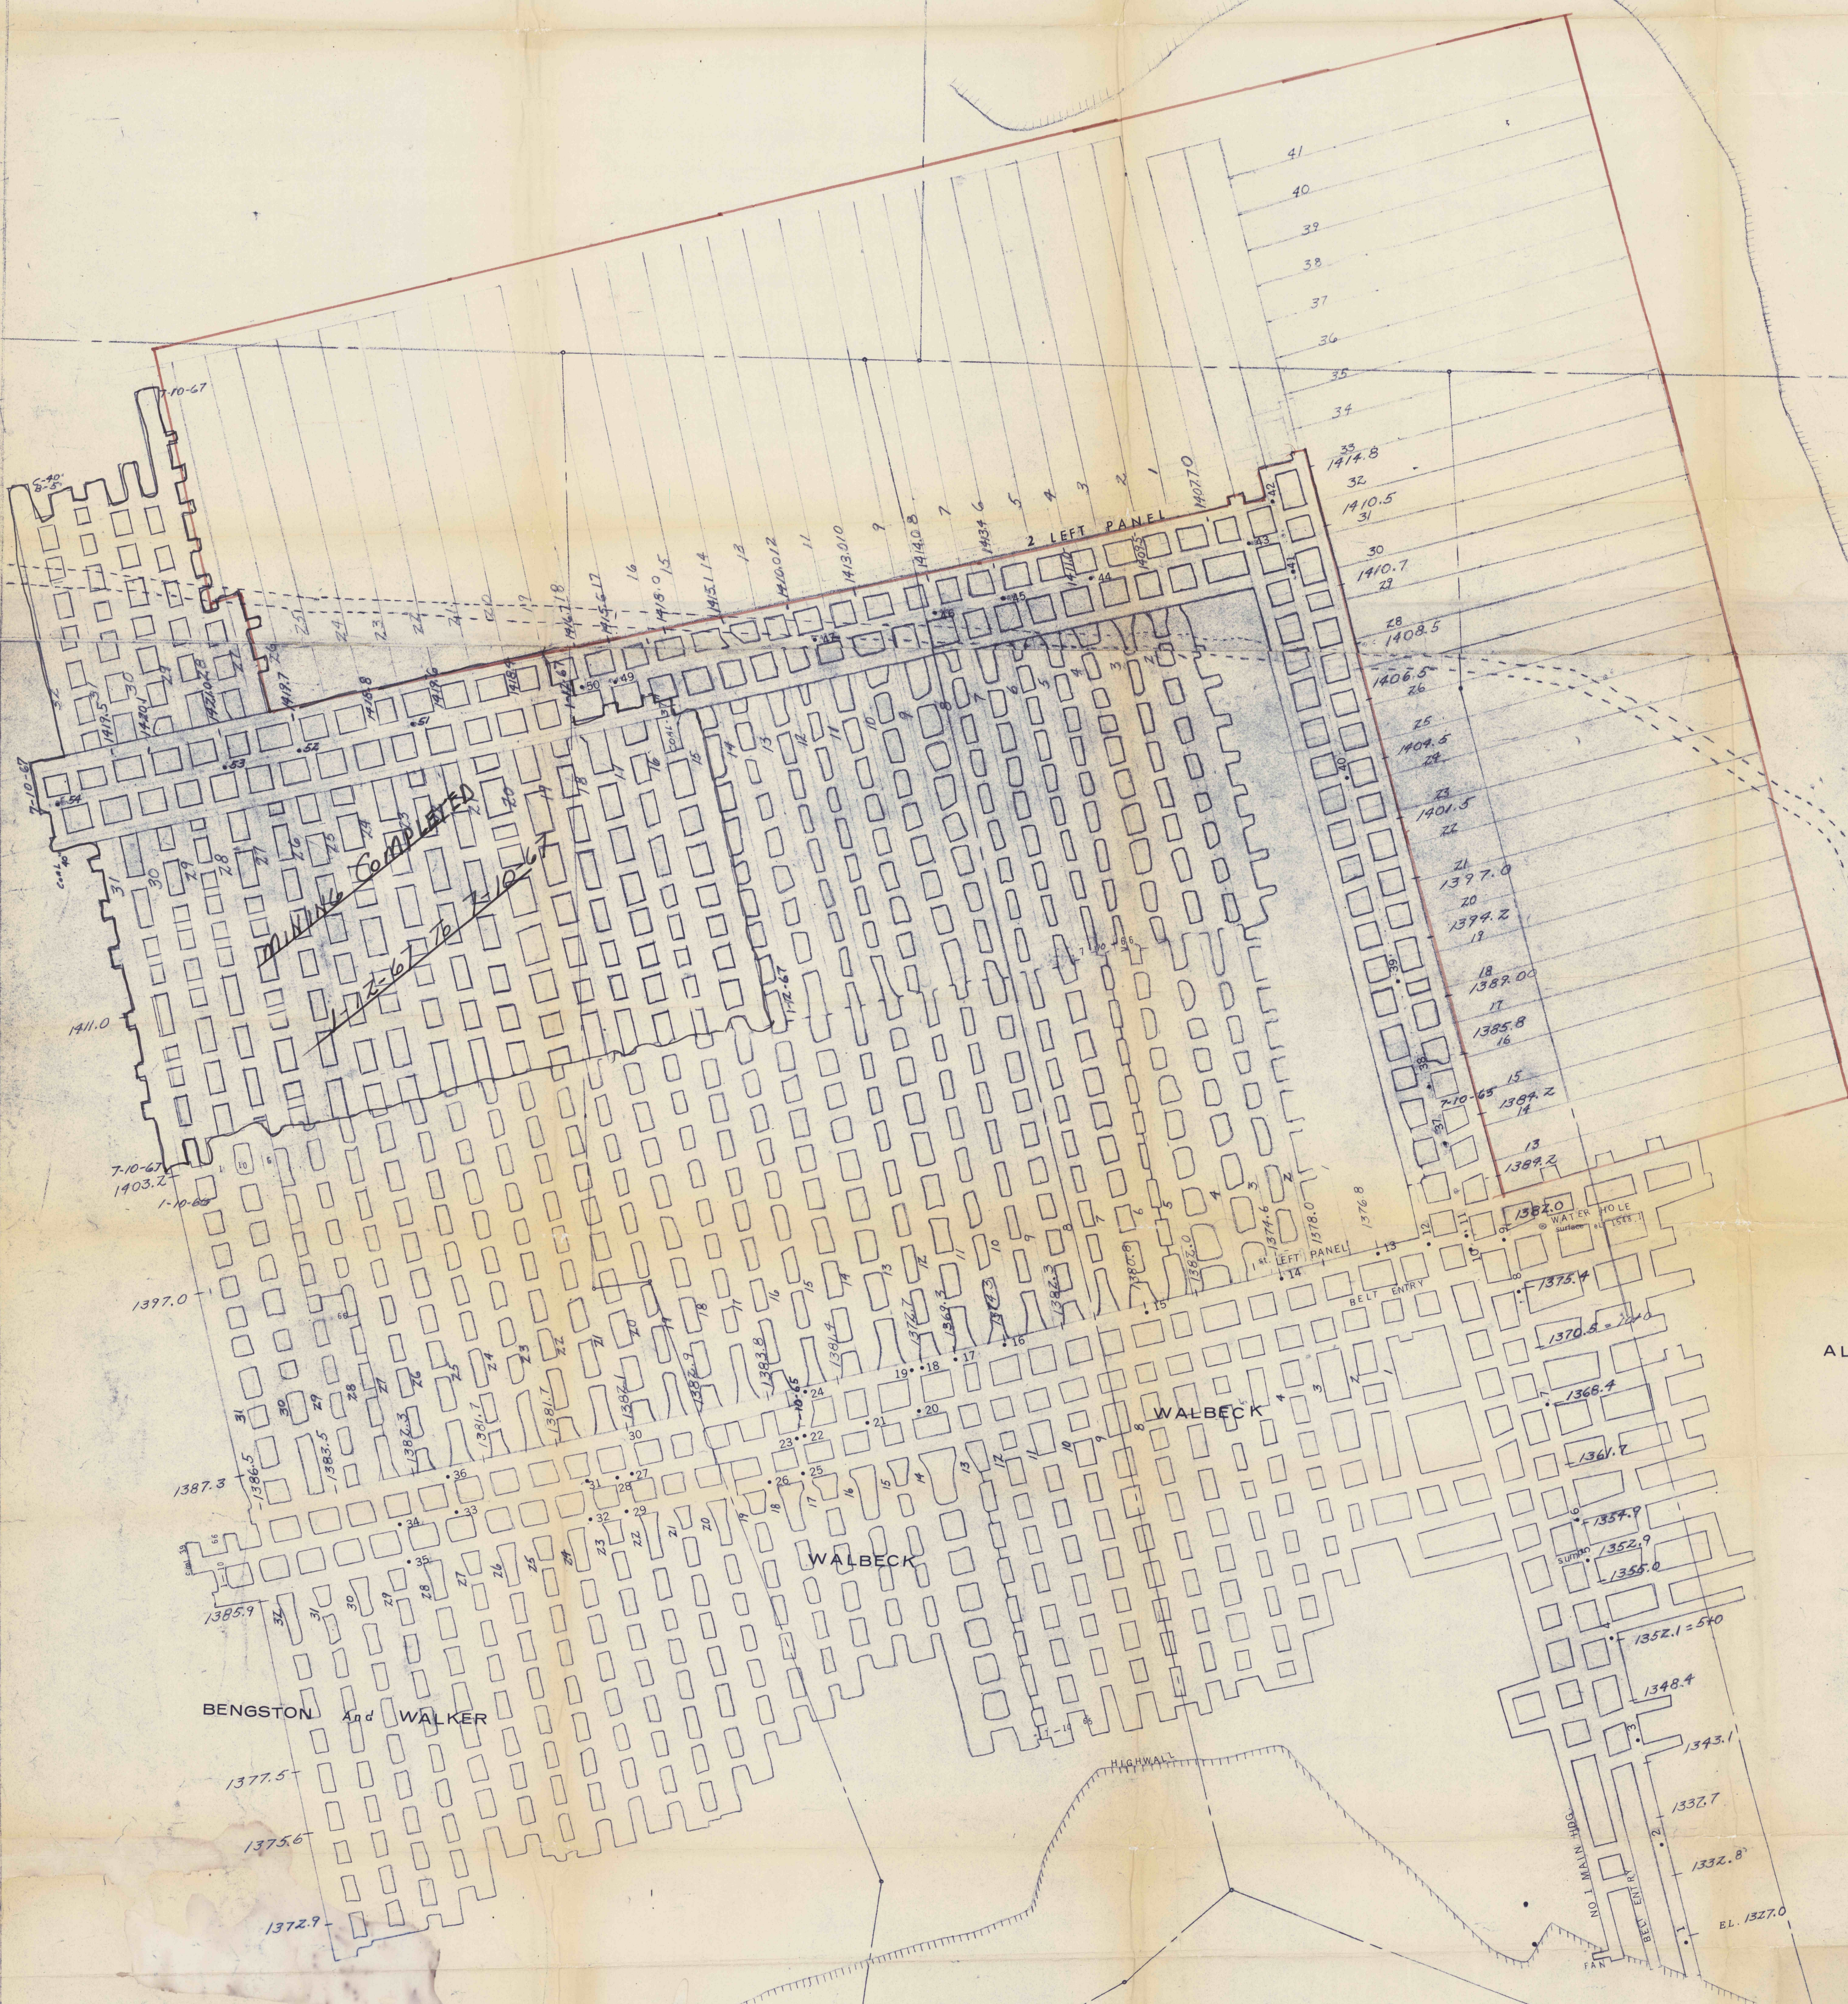

— 6 MONTH EXTENSION BOUNDARY
 JULY 10, 1967 TO JAN. 10, 1968
 No BLDGS.

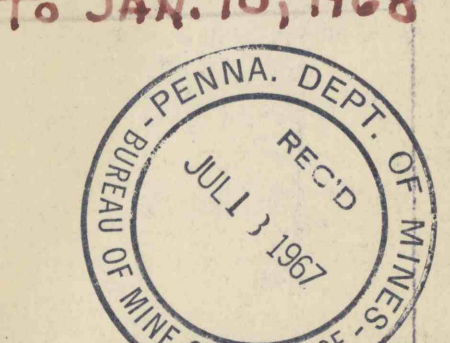

Deep Mine Property Map
 Penn Hill Coal Corp.
 Cherry Hill Twp, Indiana Co.
 Scale 1" = 100' B-SEAM
 Drawn By - John C. Passmore
 JULY 10, 1967