


PENNA. No 17 E. MINE  
E. SEAM  
BARNESBORO  
CAMBRIA CO. PA.

JANUARY  
Wm. A. R. Lister  
Superintendent



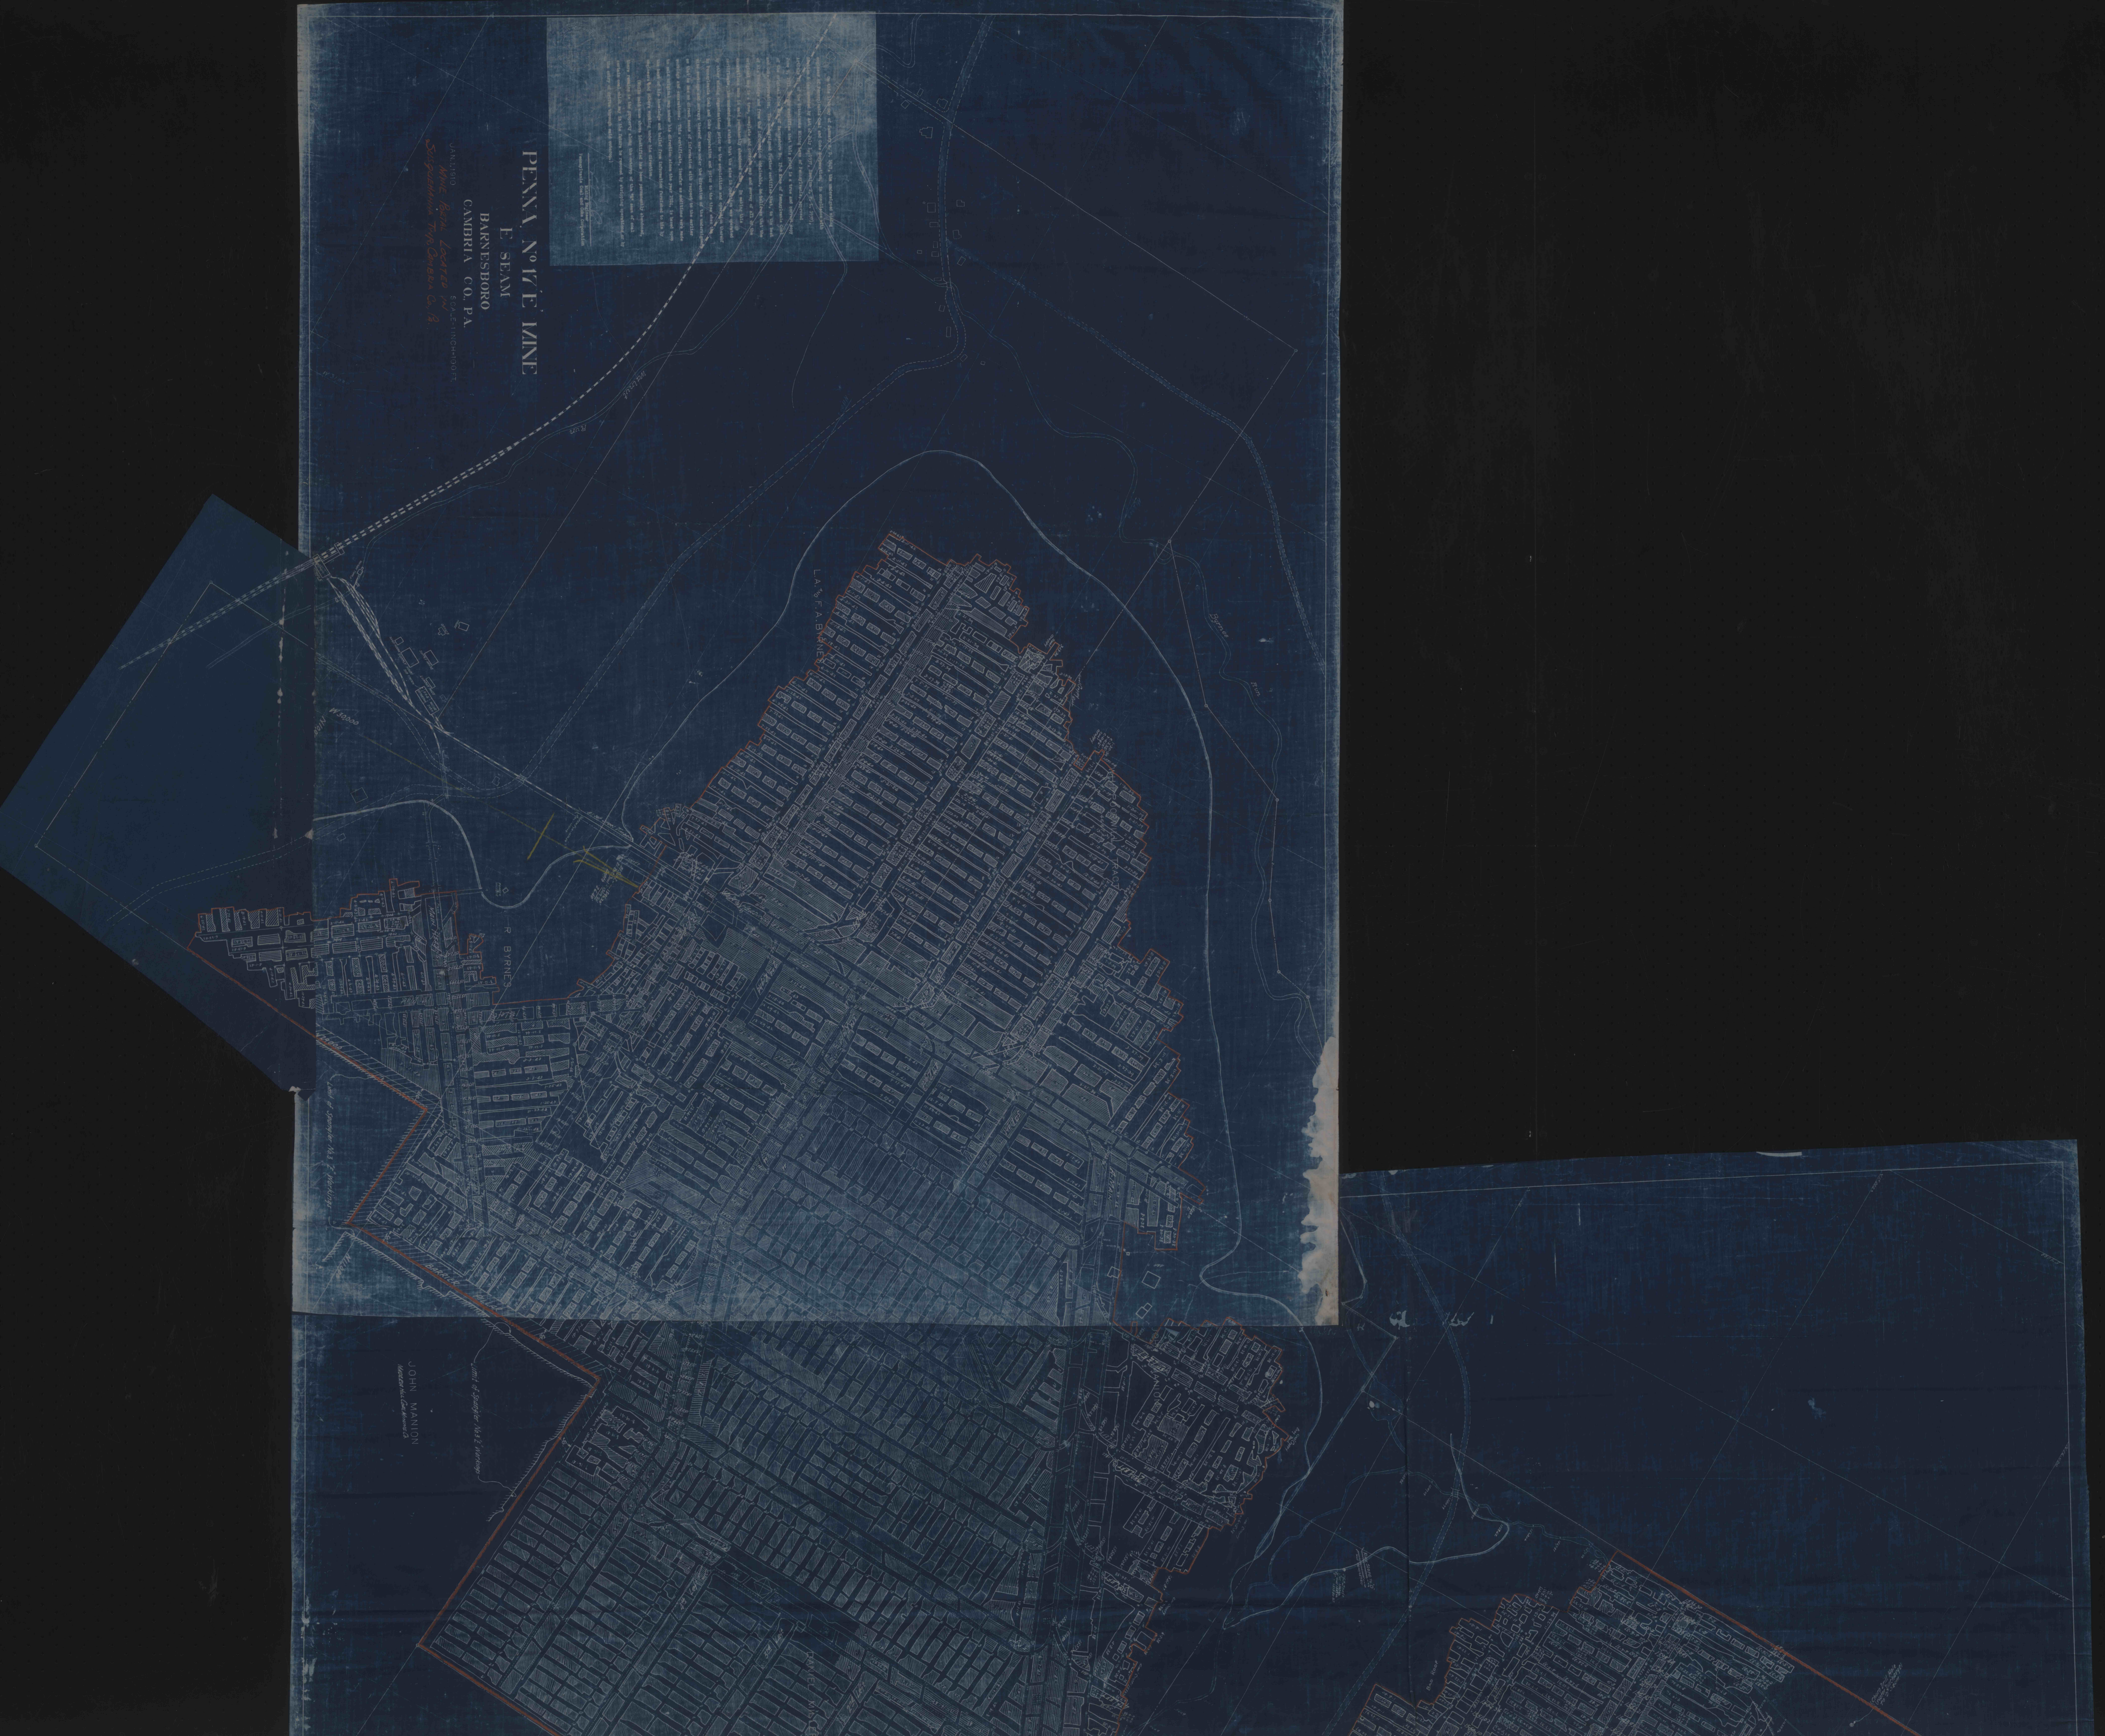

JOHN H. MANNING  
Mapmaker