




PENNA. N^o 17 E. MINE
E SEAM
BARNESBORO
CAMBRIA CO. PA.

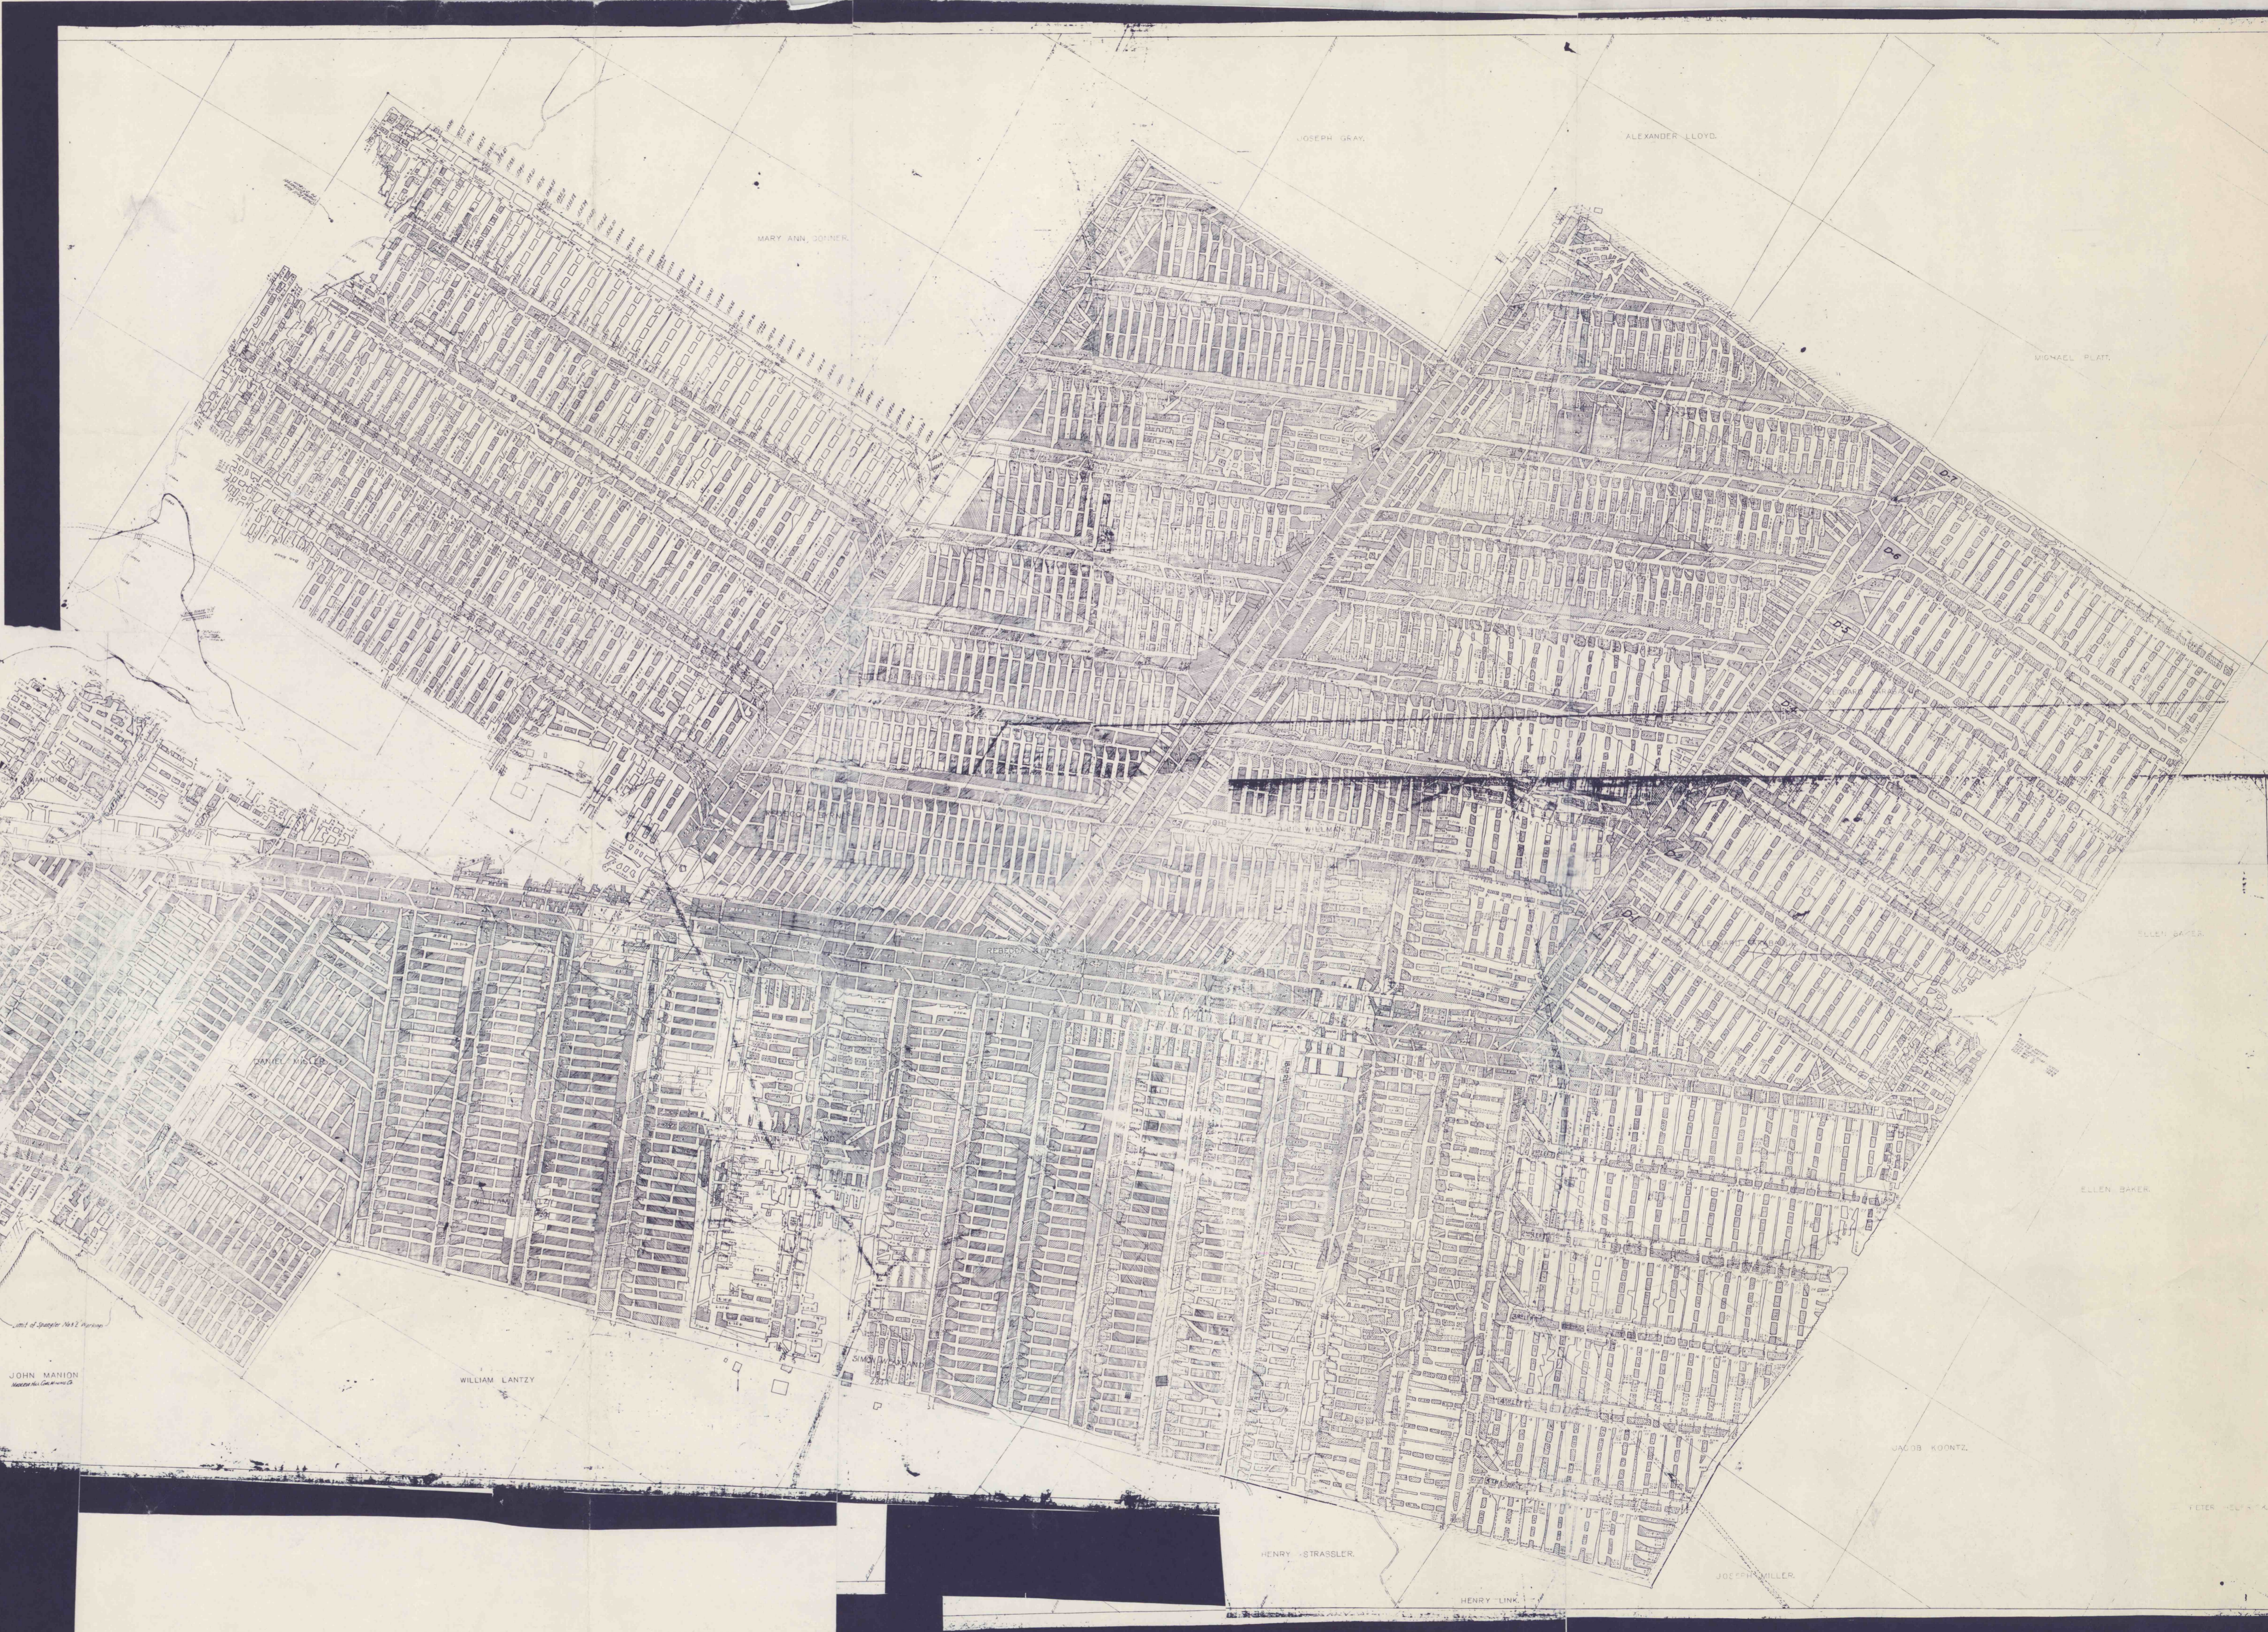

JOHN MASHON

WILLIAM LANTZY

HENRY STRASSLER

HENRY LINK

JOSEPH MILLER

PETER ...