


No. 2 MINE COAL WORKINGS.

P. S. M. Co. 1904

Scale 1in=100ft


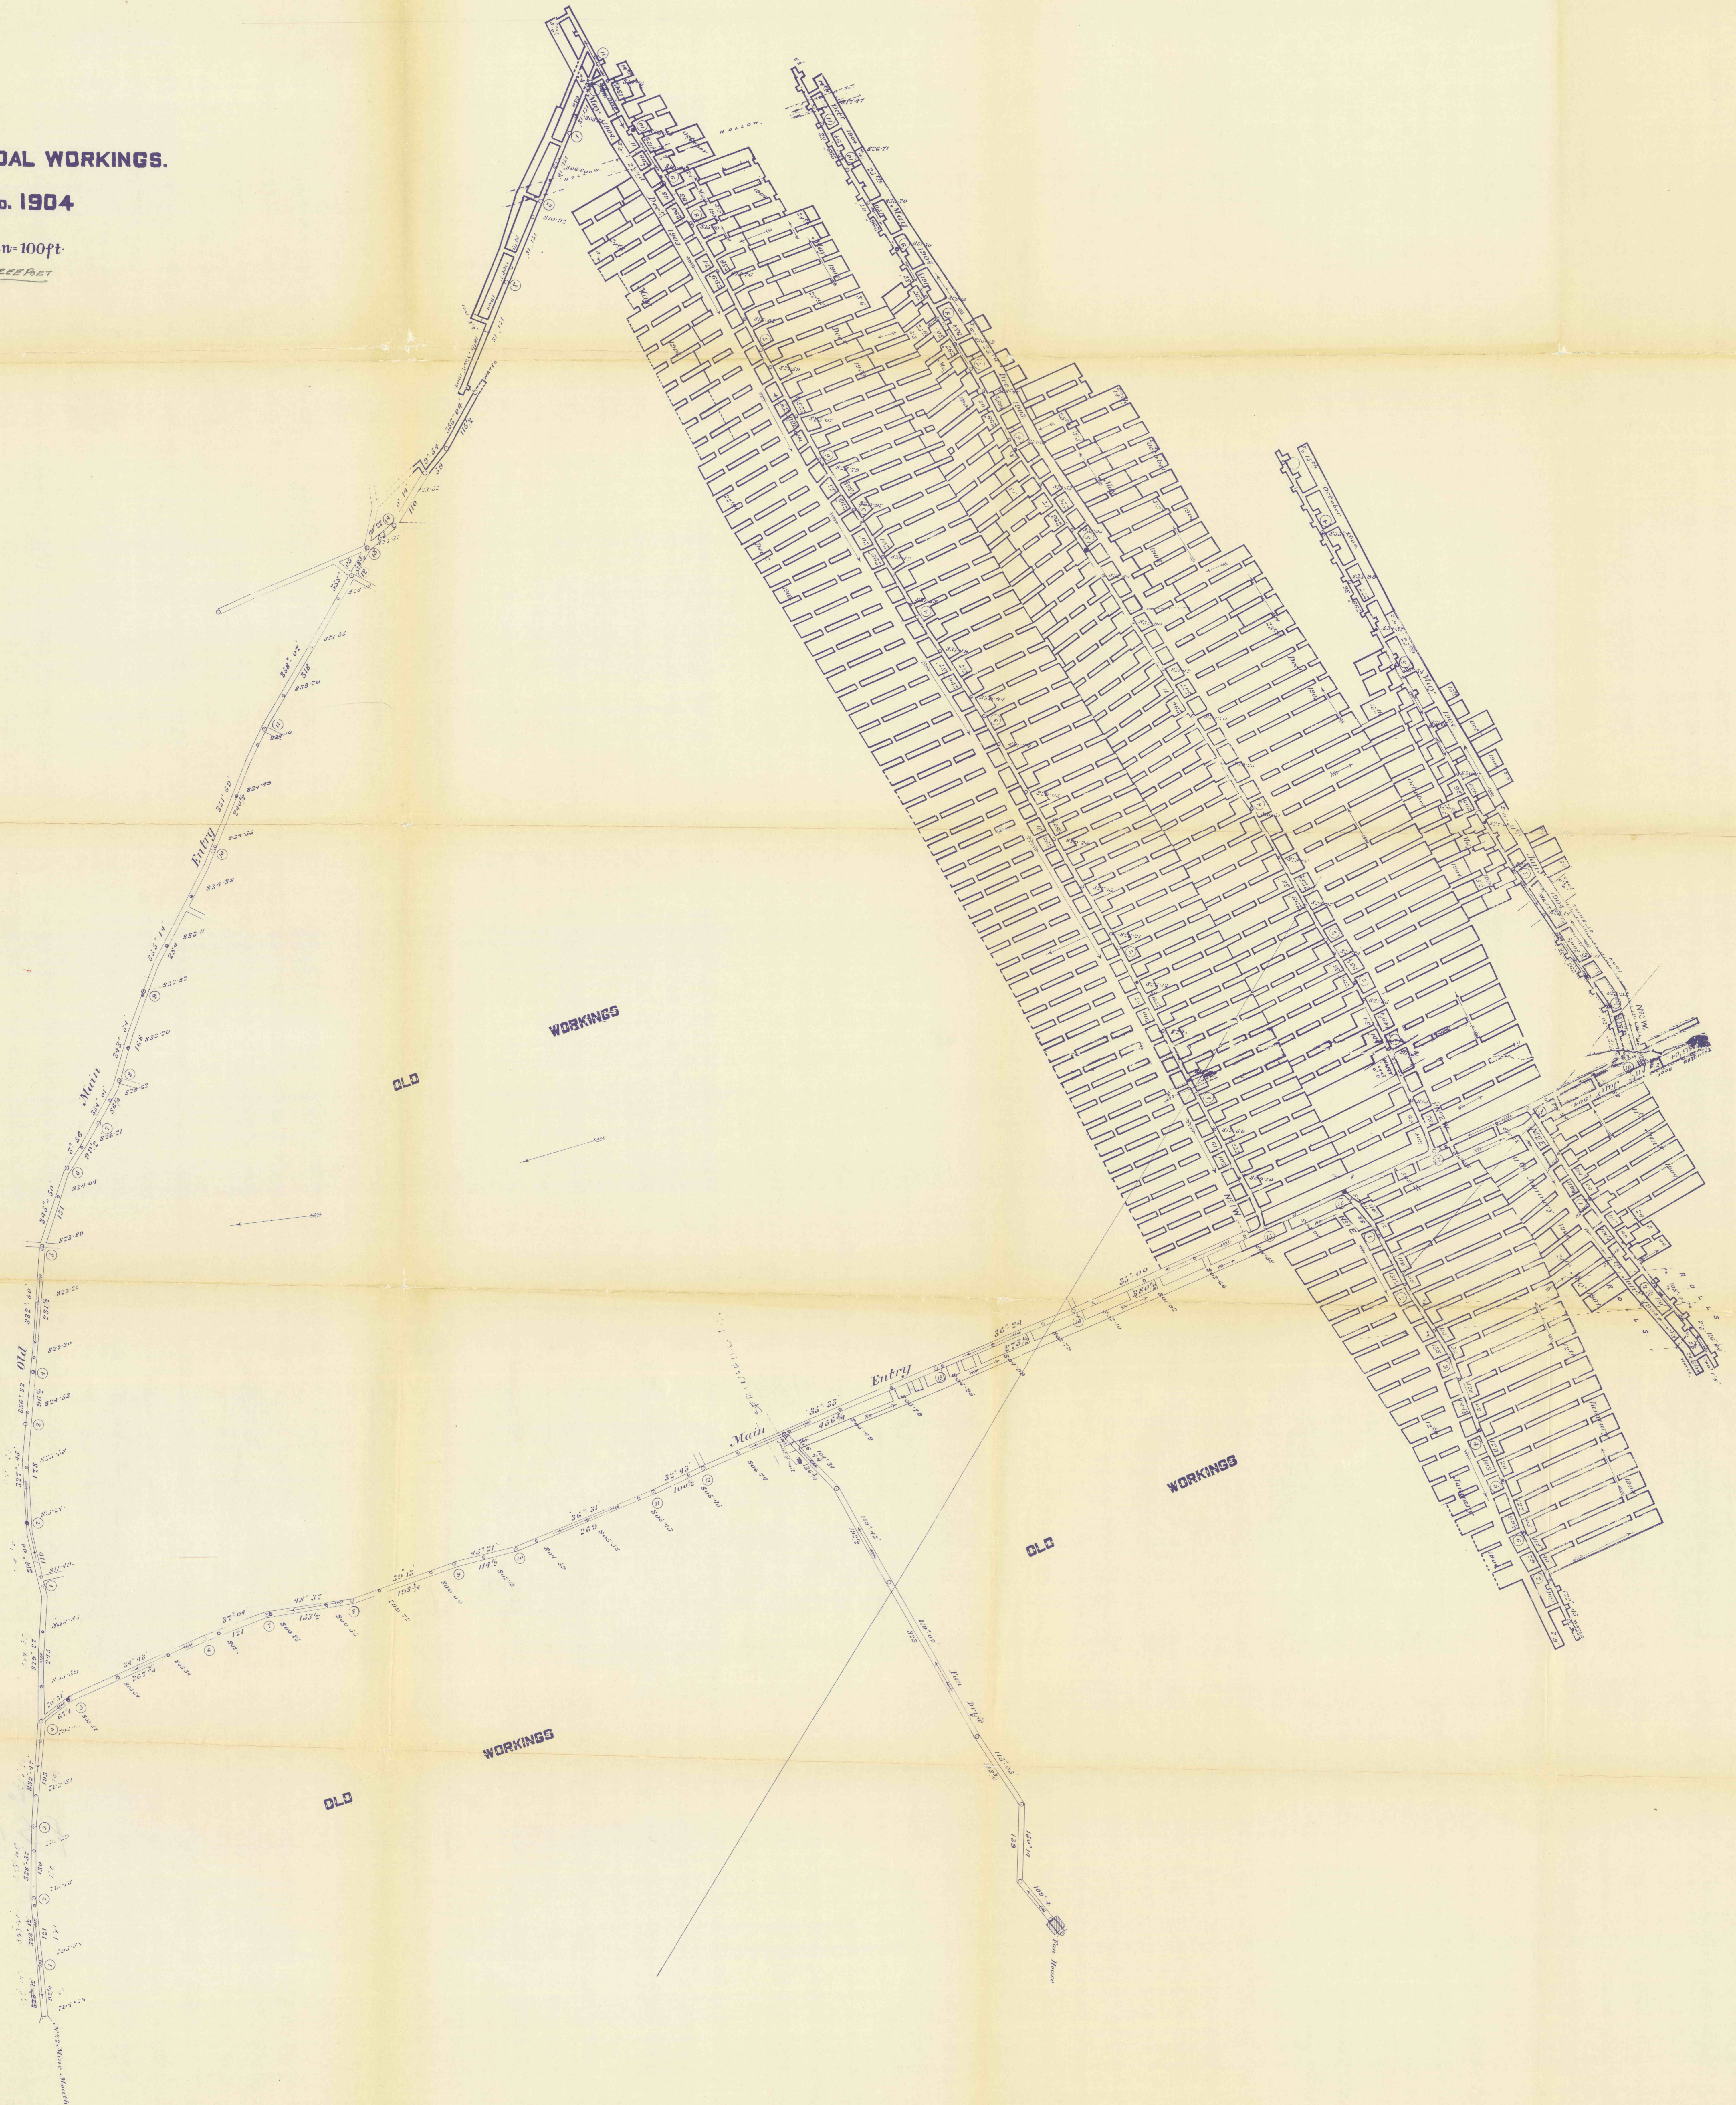

#211  
12-30-99  
C-2