



NOTE: UNDER PUNCH METHODS, ALL WORKING PLACES WILL BE AN OPENING IN THE OPEN CUT ALONG THE HIGH WALL.

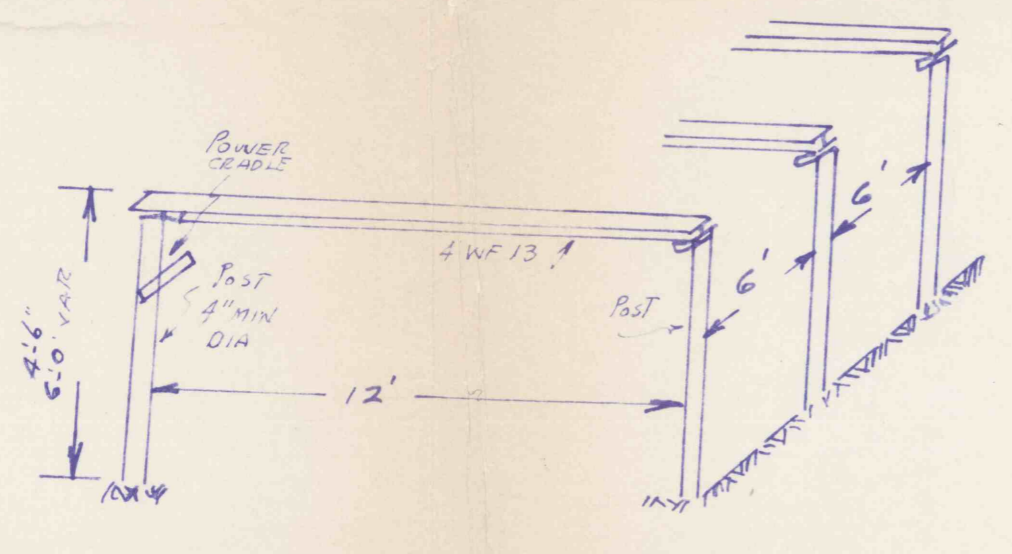

BRACING ARRANGEMENT SCALE 1/2"

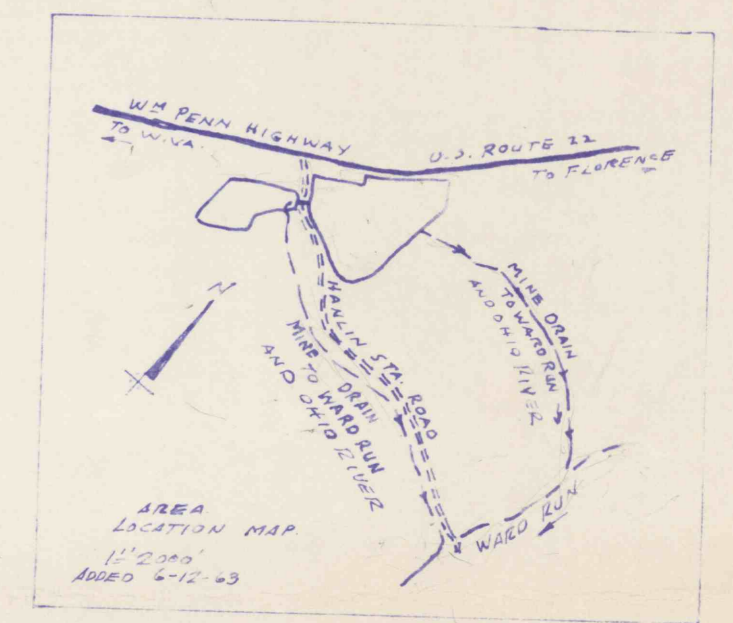

**COAL EXHAUSTED,
HIGHWALL
DEEP
MINING** Nept 1965
24/5

PLAN SHOWING COAL AREA TO BE MINED BY PENN-WEIR CONST. CO. LOCATED HANOVER TWP. WASHINGTON CO. PENNA.

1" = 100'

MAY 1963
GEN'L. ENG. CO. WEIRTON, W. VA.
PENNWEIR N°3 MINE

#2114
12-30-99
CC

ALVIN M. BLUMERT
REG. PROF. SURVEYOR, PENNA. 3301-E

NEEDED