



MINED OUT

MINED OUT


MINED OUT

MINED OUT

LAST SURVEY

- NOV. - 19 - 1928
- APR. - 19 - 1929
- JULY - 19 - 1929
- NOV. - 26 - 1929
- MAY - 27 - 1930
- NOV. - 27 - 1930

Worked Out Apr. - 27 - 1931

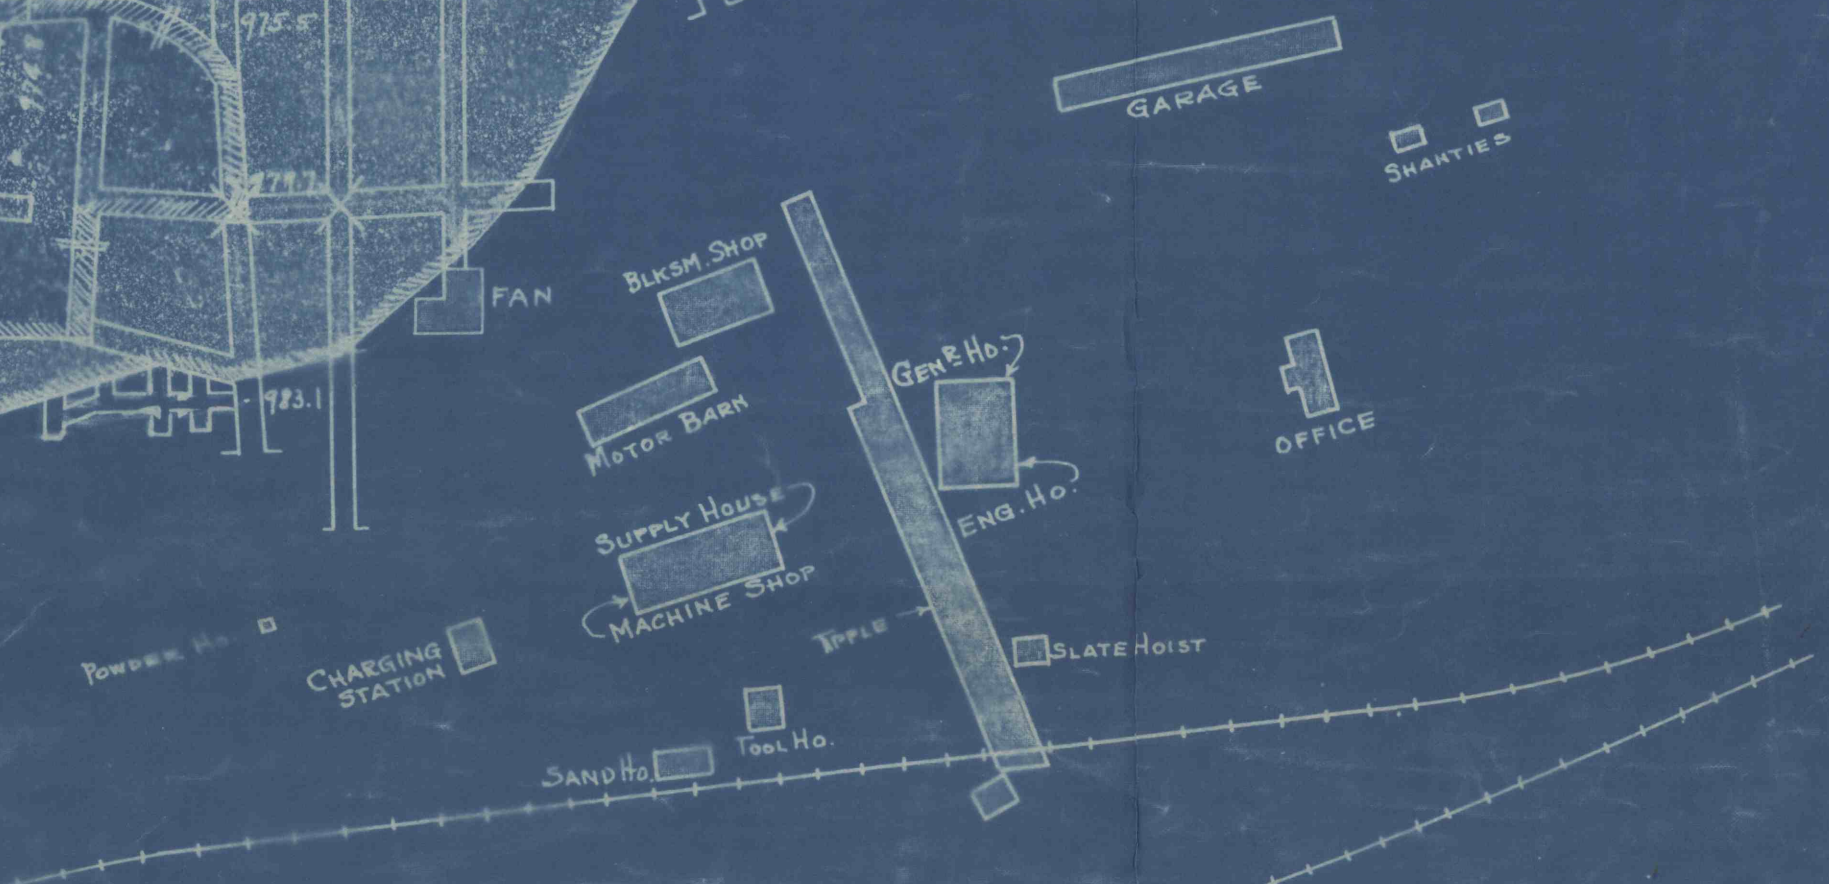

W. J. RAINEY INC
PERRYOPOLIS MINE

JAMISON COAL & COKE CO.

- PLANT N^o 21 -

Scale 1" = 100' Mar. 1928

C. E. Cowan
Chief Engineer