 
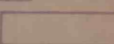
 


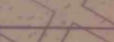

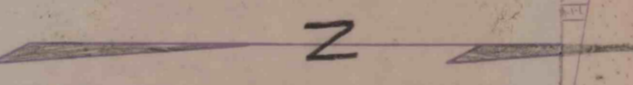


-  TOTAL PROPOSED LEASE AREA 24 9083 Acres
-  BARRIER PILLAR TO REMAIN 1 8215 Acres
-  ACRES RECOVERABLE COAL 23 0868 Acres
-  STEP NO. 1 - ADVANCE HEADINGS TO ROSEDALE GOAL
-  STEP NO. 2 - DEplete COAL EAST OF ADVANCE HEADINGS
-  STEP NO. 3 - DEplete UNMINED COAL ROSEDALE PROPERTY
-  STEP NO. 4 - DEplete COAL WEST OF ADVANCE HEADINGS

NOTE: THIS SECTION OF THE MINE ABANDONED 4-24-77

NOTE: THIS SECTION OF THE MINE ABANDONED MARCH 24, 1976

PETITE BROS. COAL CO.
 DILLINGER PA.
 CLARK TWP GREEN CO. PA.
 SEWICKLEY SEAM SCALE 1"=100'
 36 00908
FINAL MINE MAP



| Survey Extension | LEVELS EXTENSION | SURVEY EXTENSION | BY |
|------------------|------------------|------------------|----------------|
| 7-1-70 | 1-1-70 | 1-1-70 | R. M. Wilfong |

Robert M. Wilfong
4-17-75

