


PHILIP & HENRY WILL

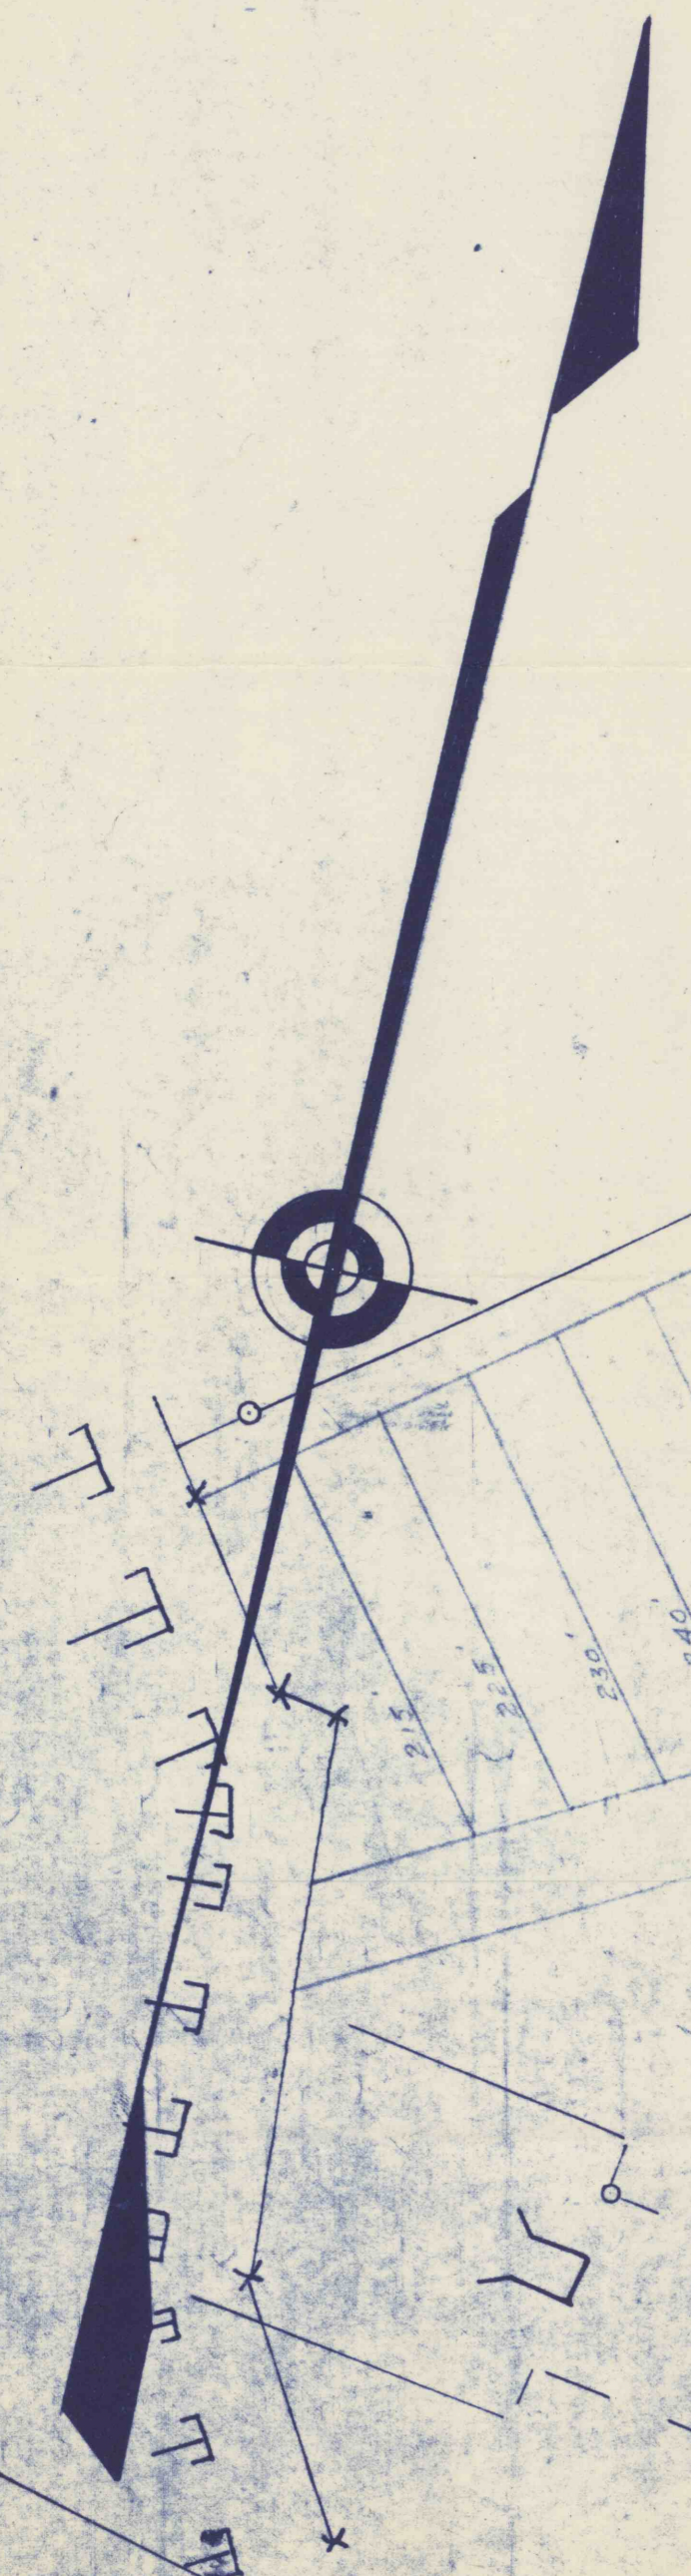

Barrier Pillar

Out. Prior Jan 1, '55

Out. Prior Jan 1, '55

NEGRO MOUNTAIN TUNNEL  
SOUTH PENN. R.R. CO.

PENNSYLVANIA

TURNPIKE

To Harrisburgh

TOWNSHIP

PERRY WALKER

SURF. PERRY WALKER  
COAL JOHN W. PILE  
RUSSELL M. AND RUTH E. PILE

SURF. DENISE COAL CO  
COAL JOHN W. PILE  
RUSSELL M. AND RUTH E. PILE

PONDS BUILT BY PILE RUN COAL CO  
FOR SETTLING SLT AND NEUTRALIZING  
MINE DRAINAGE

**PILE MINE**

**"D" SEAM OPERATION**  
STONYCREEK TWP. SOMERSET CO. PA.

SCALE 1" = 100'

H. GLAY STICKEL - LESSOR

GOLDEN LEE COAL CORPORATION  
Formerly DAVIS MINE

Reopened Dec. 1955 20-1957

#205  
P.C.C.