


Colley + Franklin Coke Co. in  
 the name of H. C. Frick Coal and  
 lease.

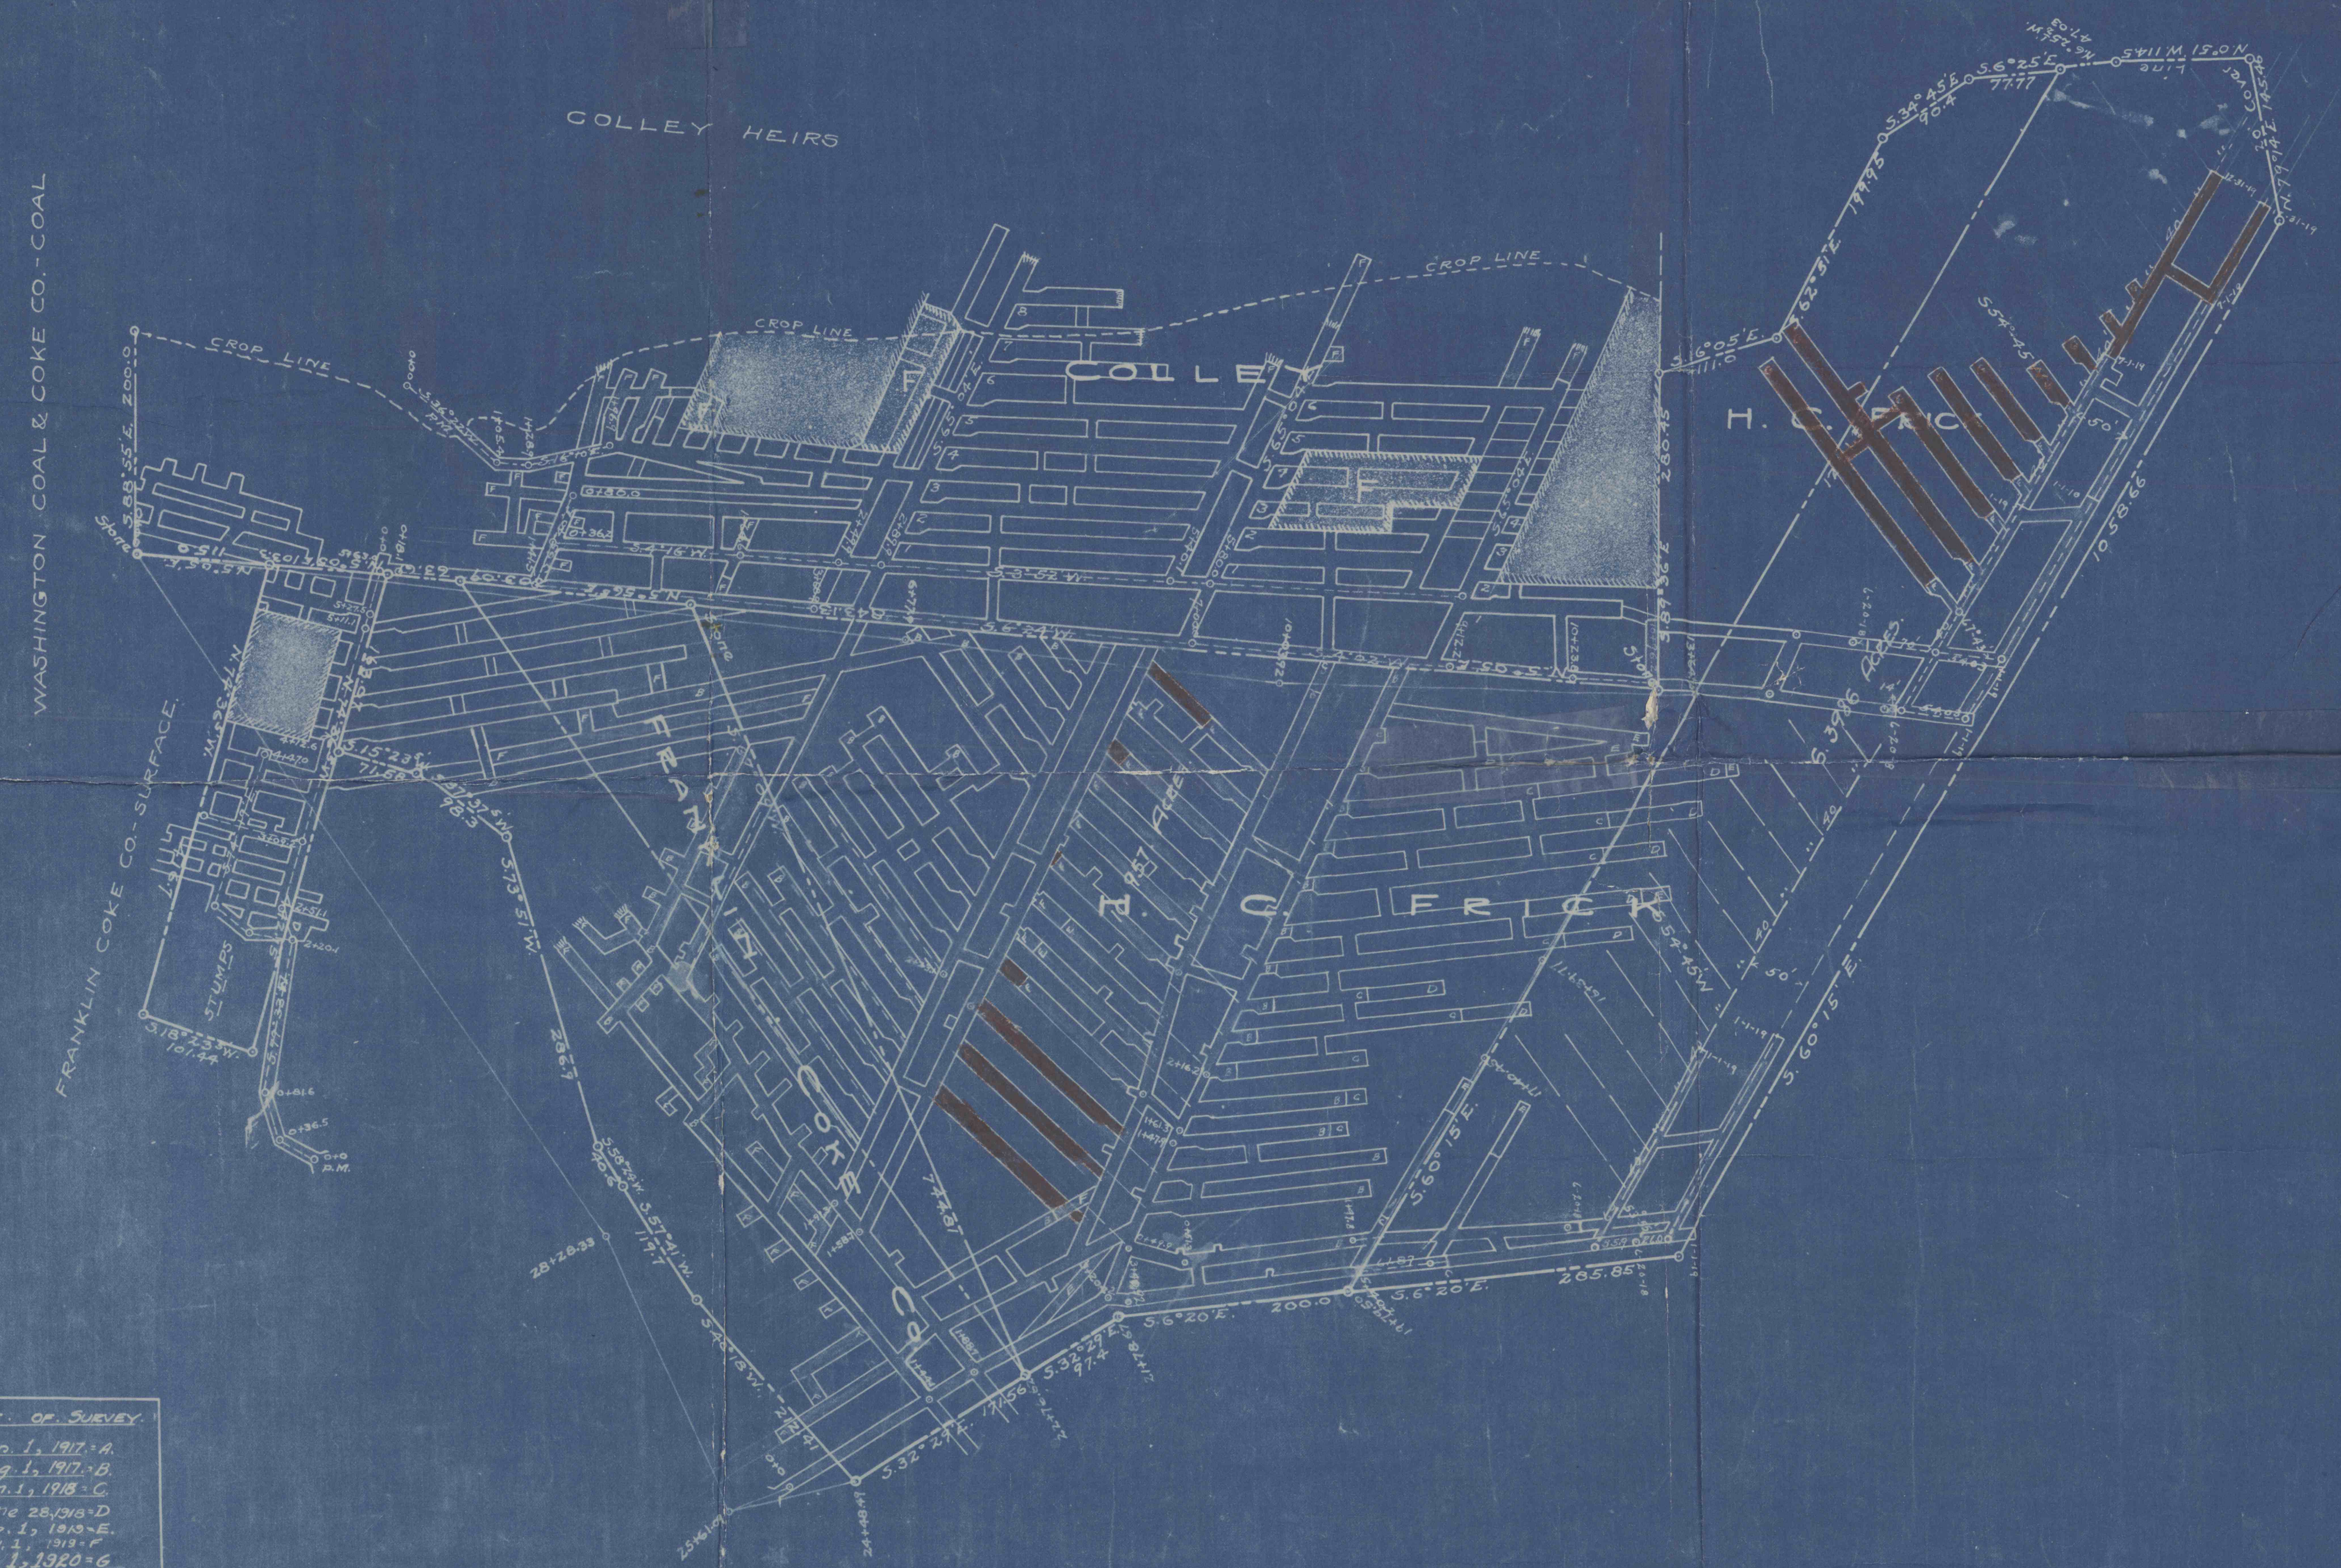

DATE OF SURVEY
Jan. 1, 1917 - A.
Aug. 1, 1917 - B.
Jan. 1, 1918 - C.
June 28, 1918 - D.
Jan. 1, 1919 - E.
July 1, 1919 - F.
Jan. 1, 1920 - G.

LEON MINE  
 FRANKLIN COKE CO.  
 FRANKLIN TWP., FAYETTE CO., PA.  
 SCALE - 1 = 100.      AUGUST, 1916.