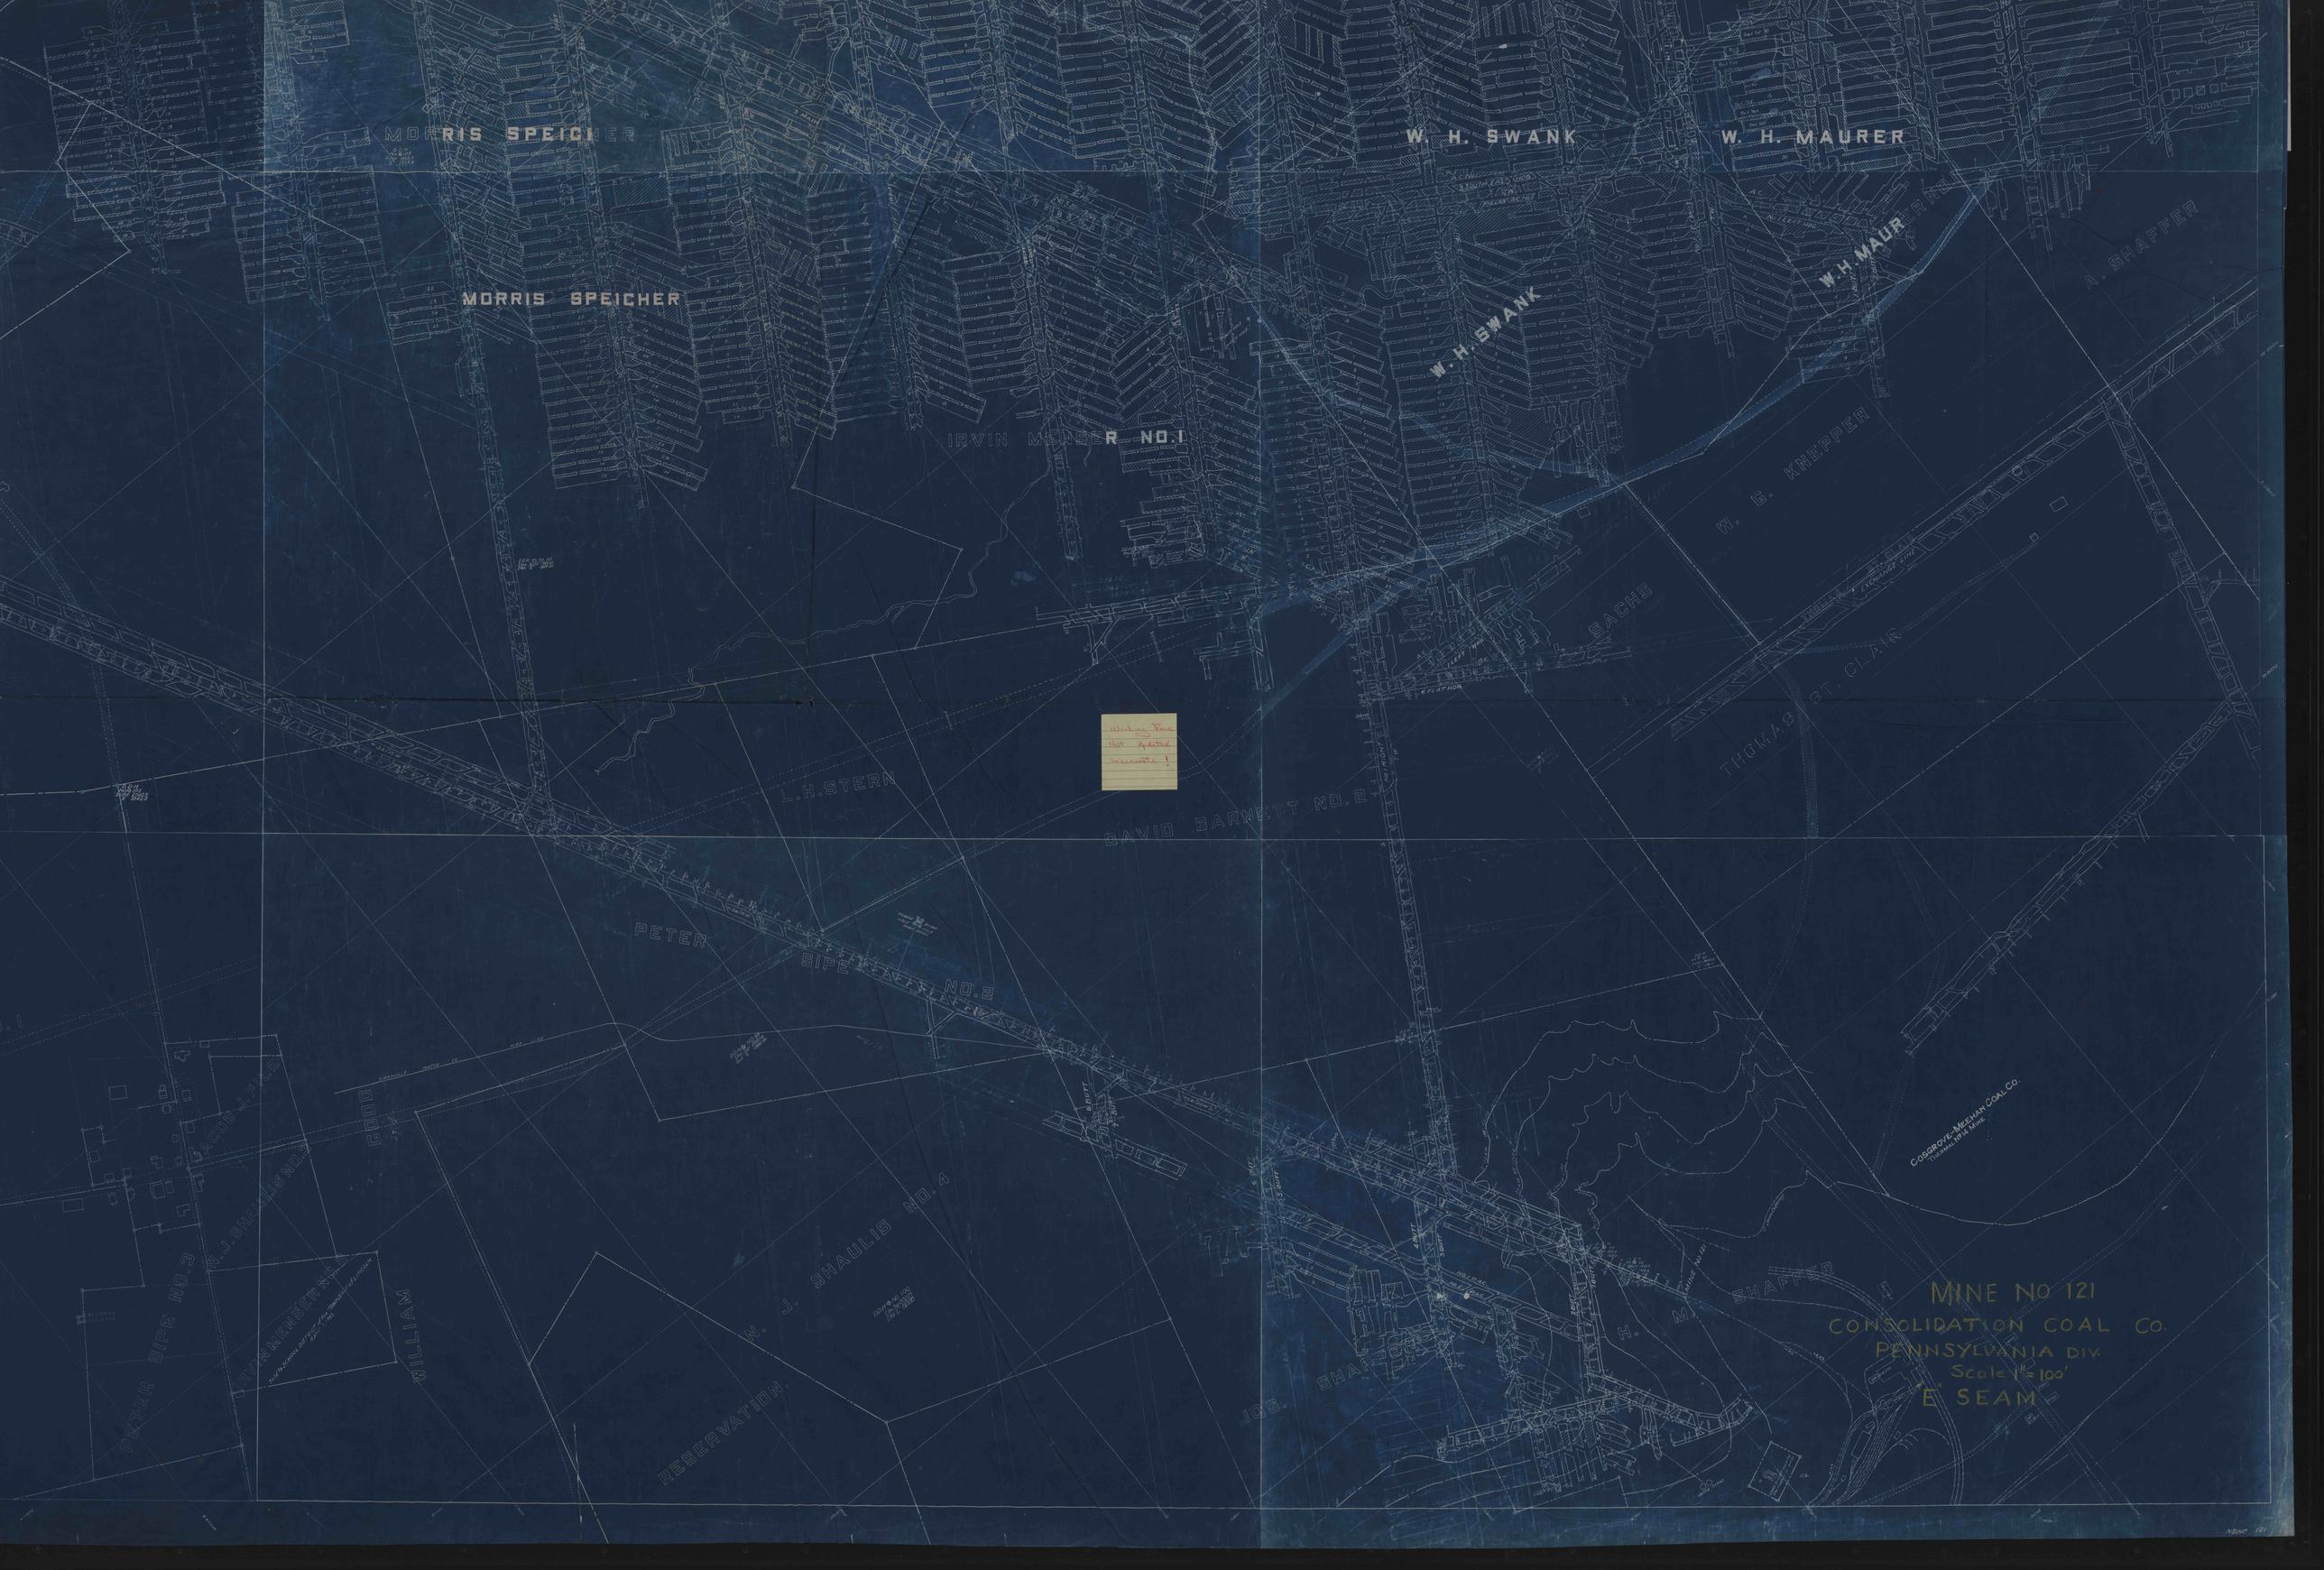
MORRIS SPEICHER
W. H. SWANK
W. H. MAURER
MORRIS SPEICHER
W. H. SWANK
W. H. MAUR
A. SHAFFER
IRVIN MENSER NO. 1
W. G. KNEPPER
SACHS
THOMAS ST. CLAIR
L. H. STERN
DAVID BARNETT NO. 2
PETER SIPE NO. 2
COSGROVE-MEEHAN COAL CO.
N. J. SHAULIS NO. 4
PETER SIPE NO. 3
WILLIAM
RESERVATION
H. M. SHAFFER
JOS. SHAFFER
MINE NO 121
CONSOLIDATION COAL CO.
PENNSYLVANIA DIV.
Scale 1" = 100'
E SEAM