




GEO. FRIEDLINE NO. 2

ED. F. MILLER NO. 2

HENRY HAY

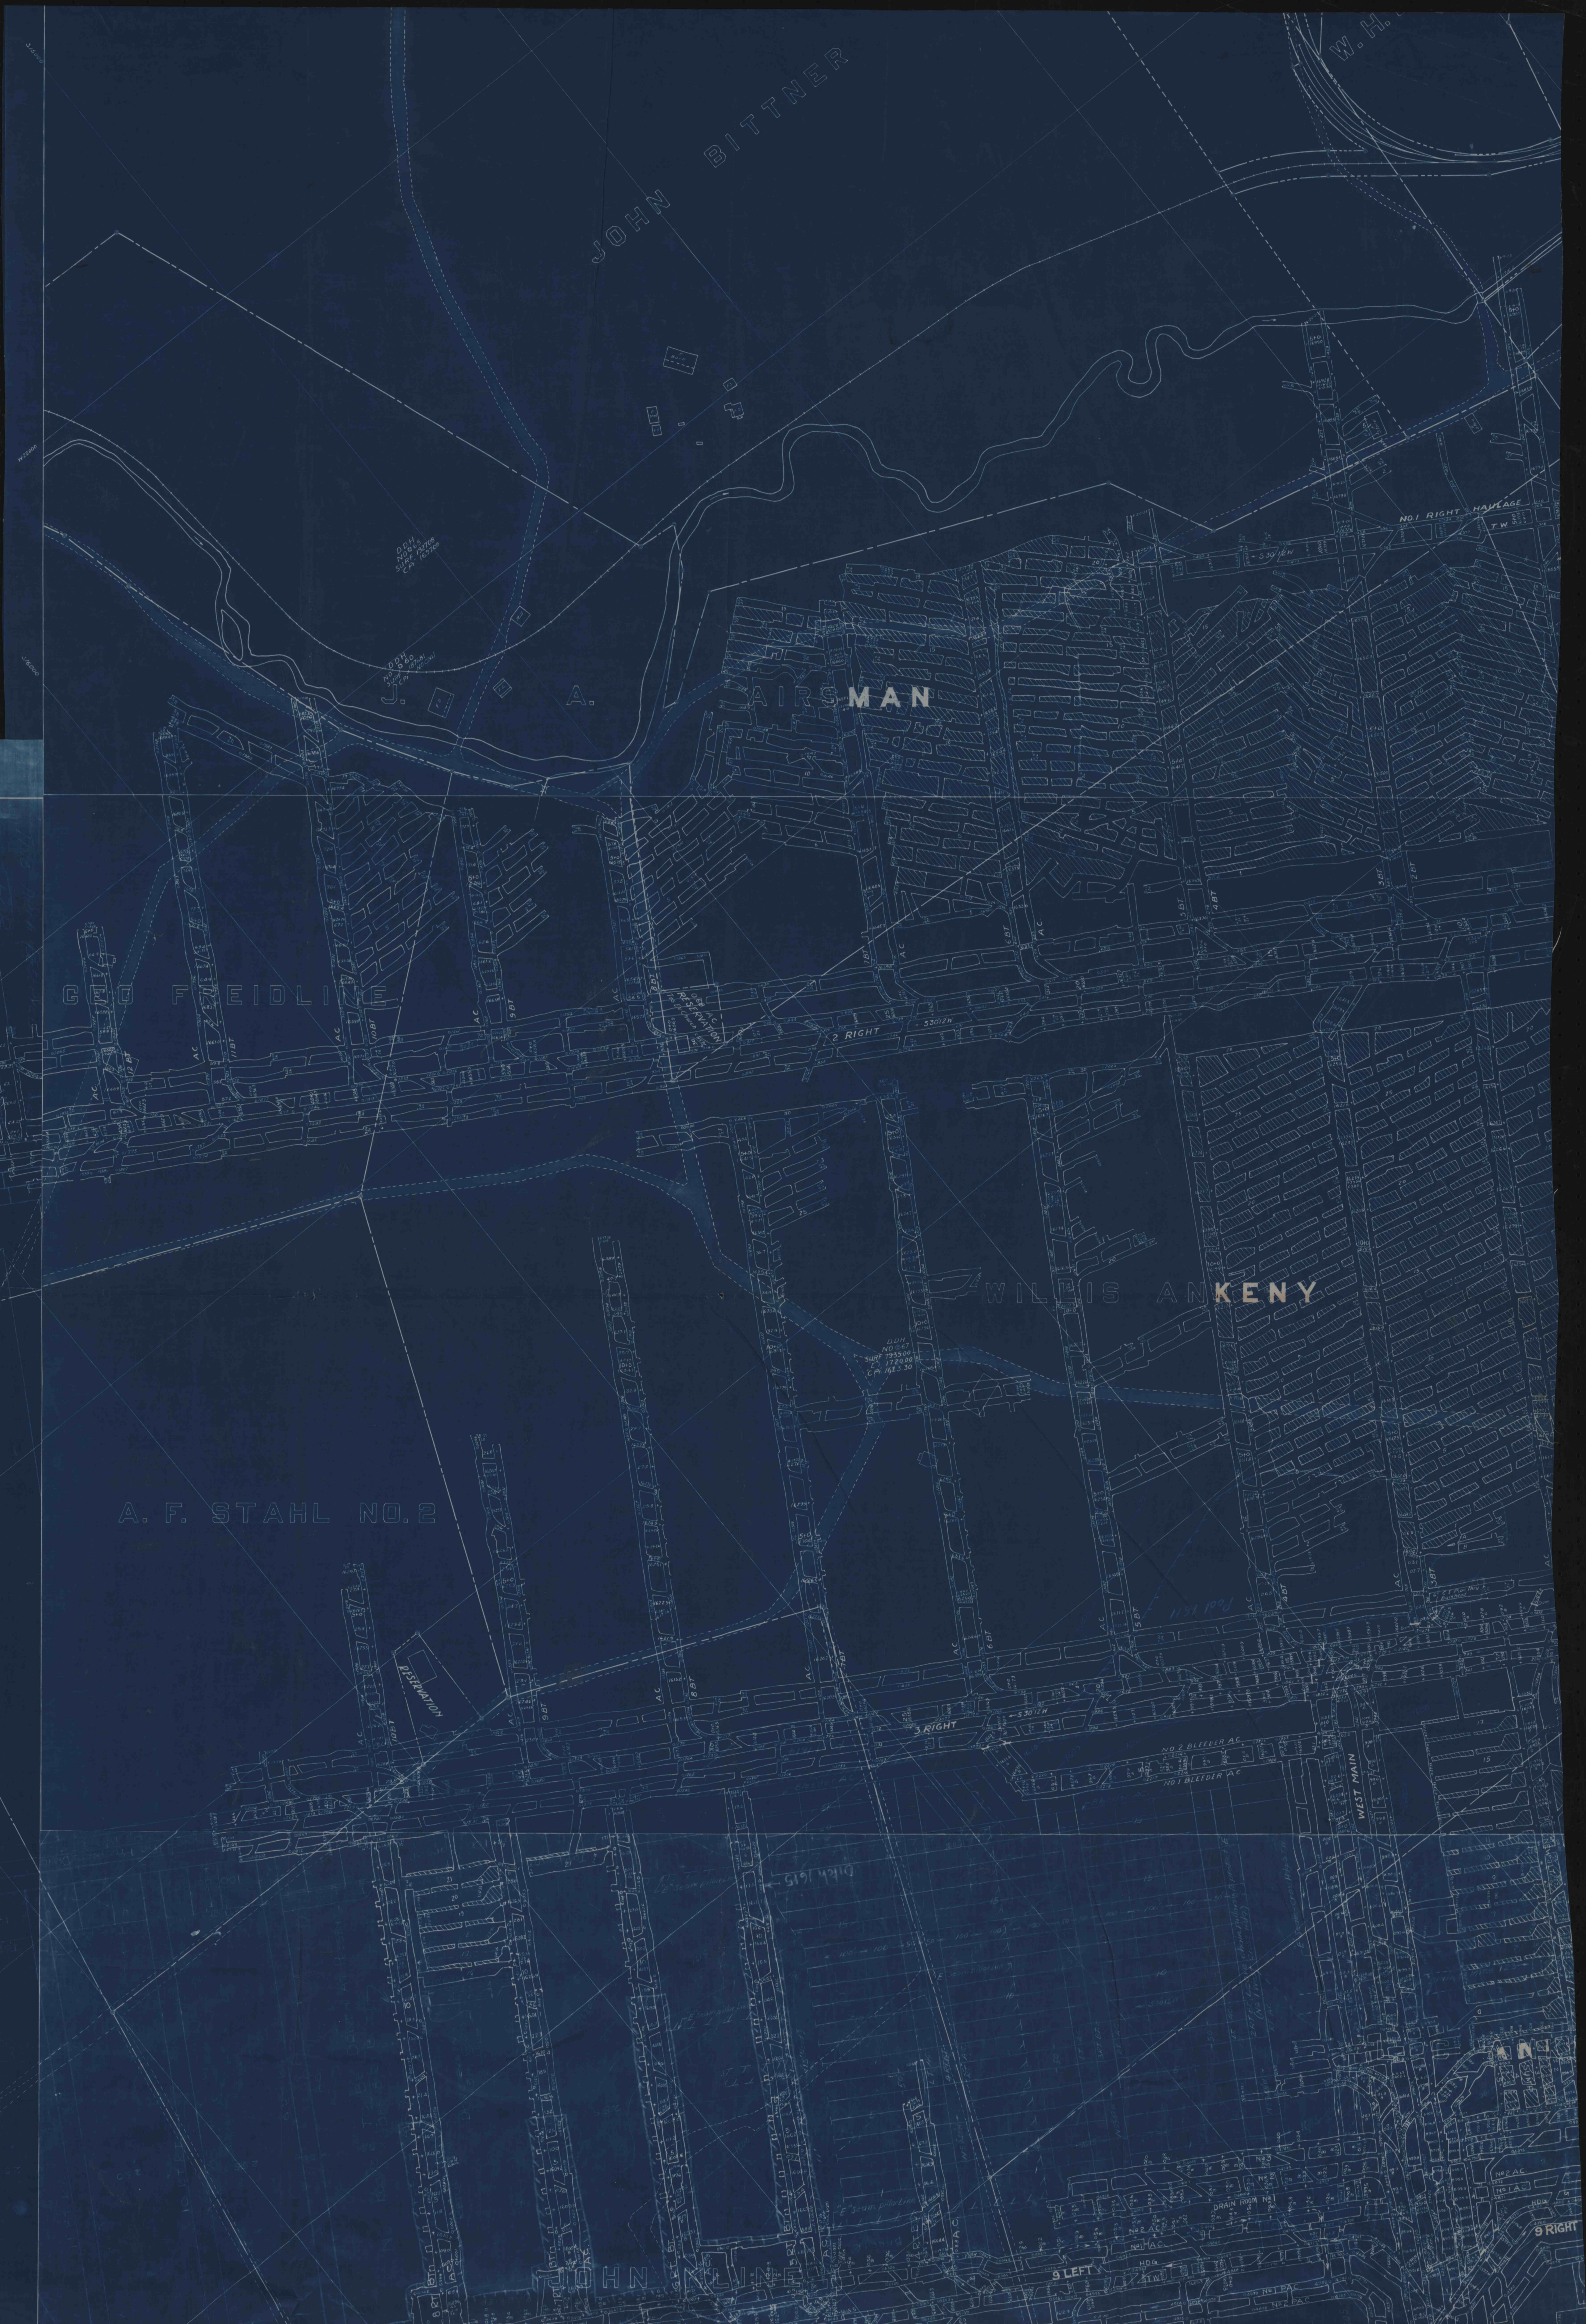

JOHN BITTNER

MAN

FEIOLIE

WILFIS ANKENY

A. F. STAHL NO. 2

JOHN WILHELM