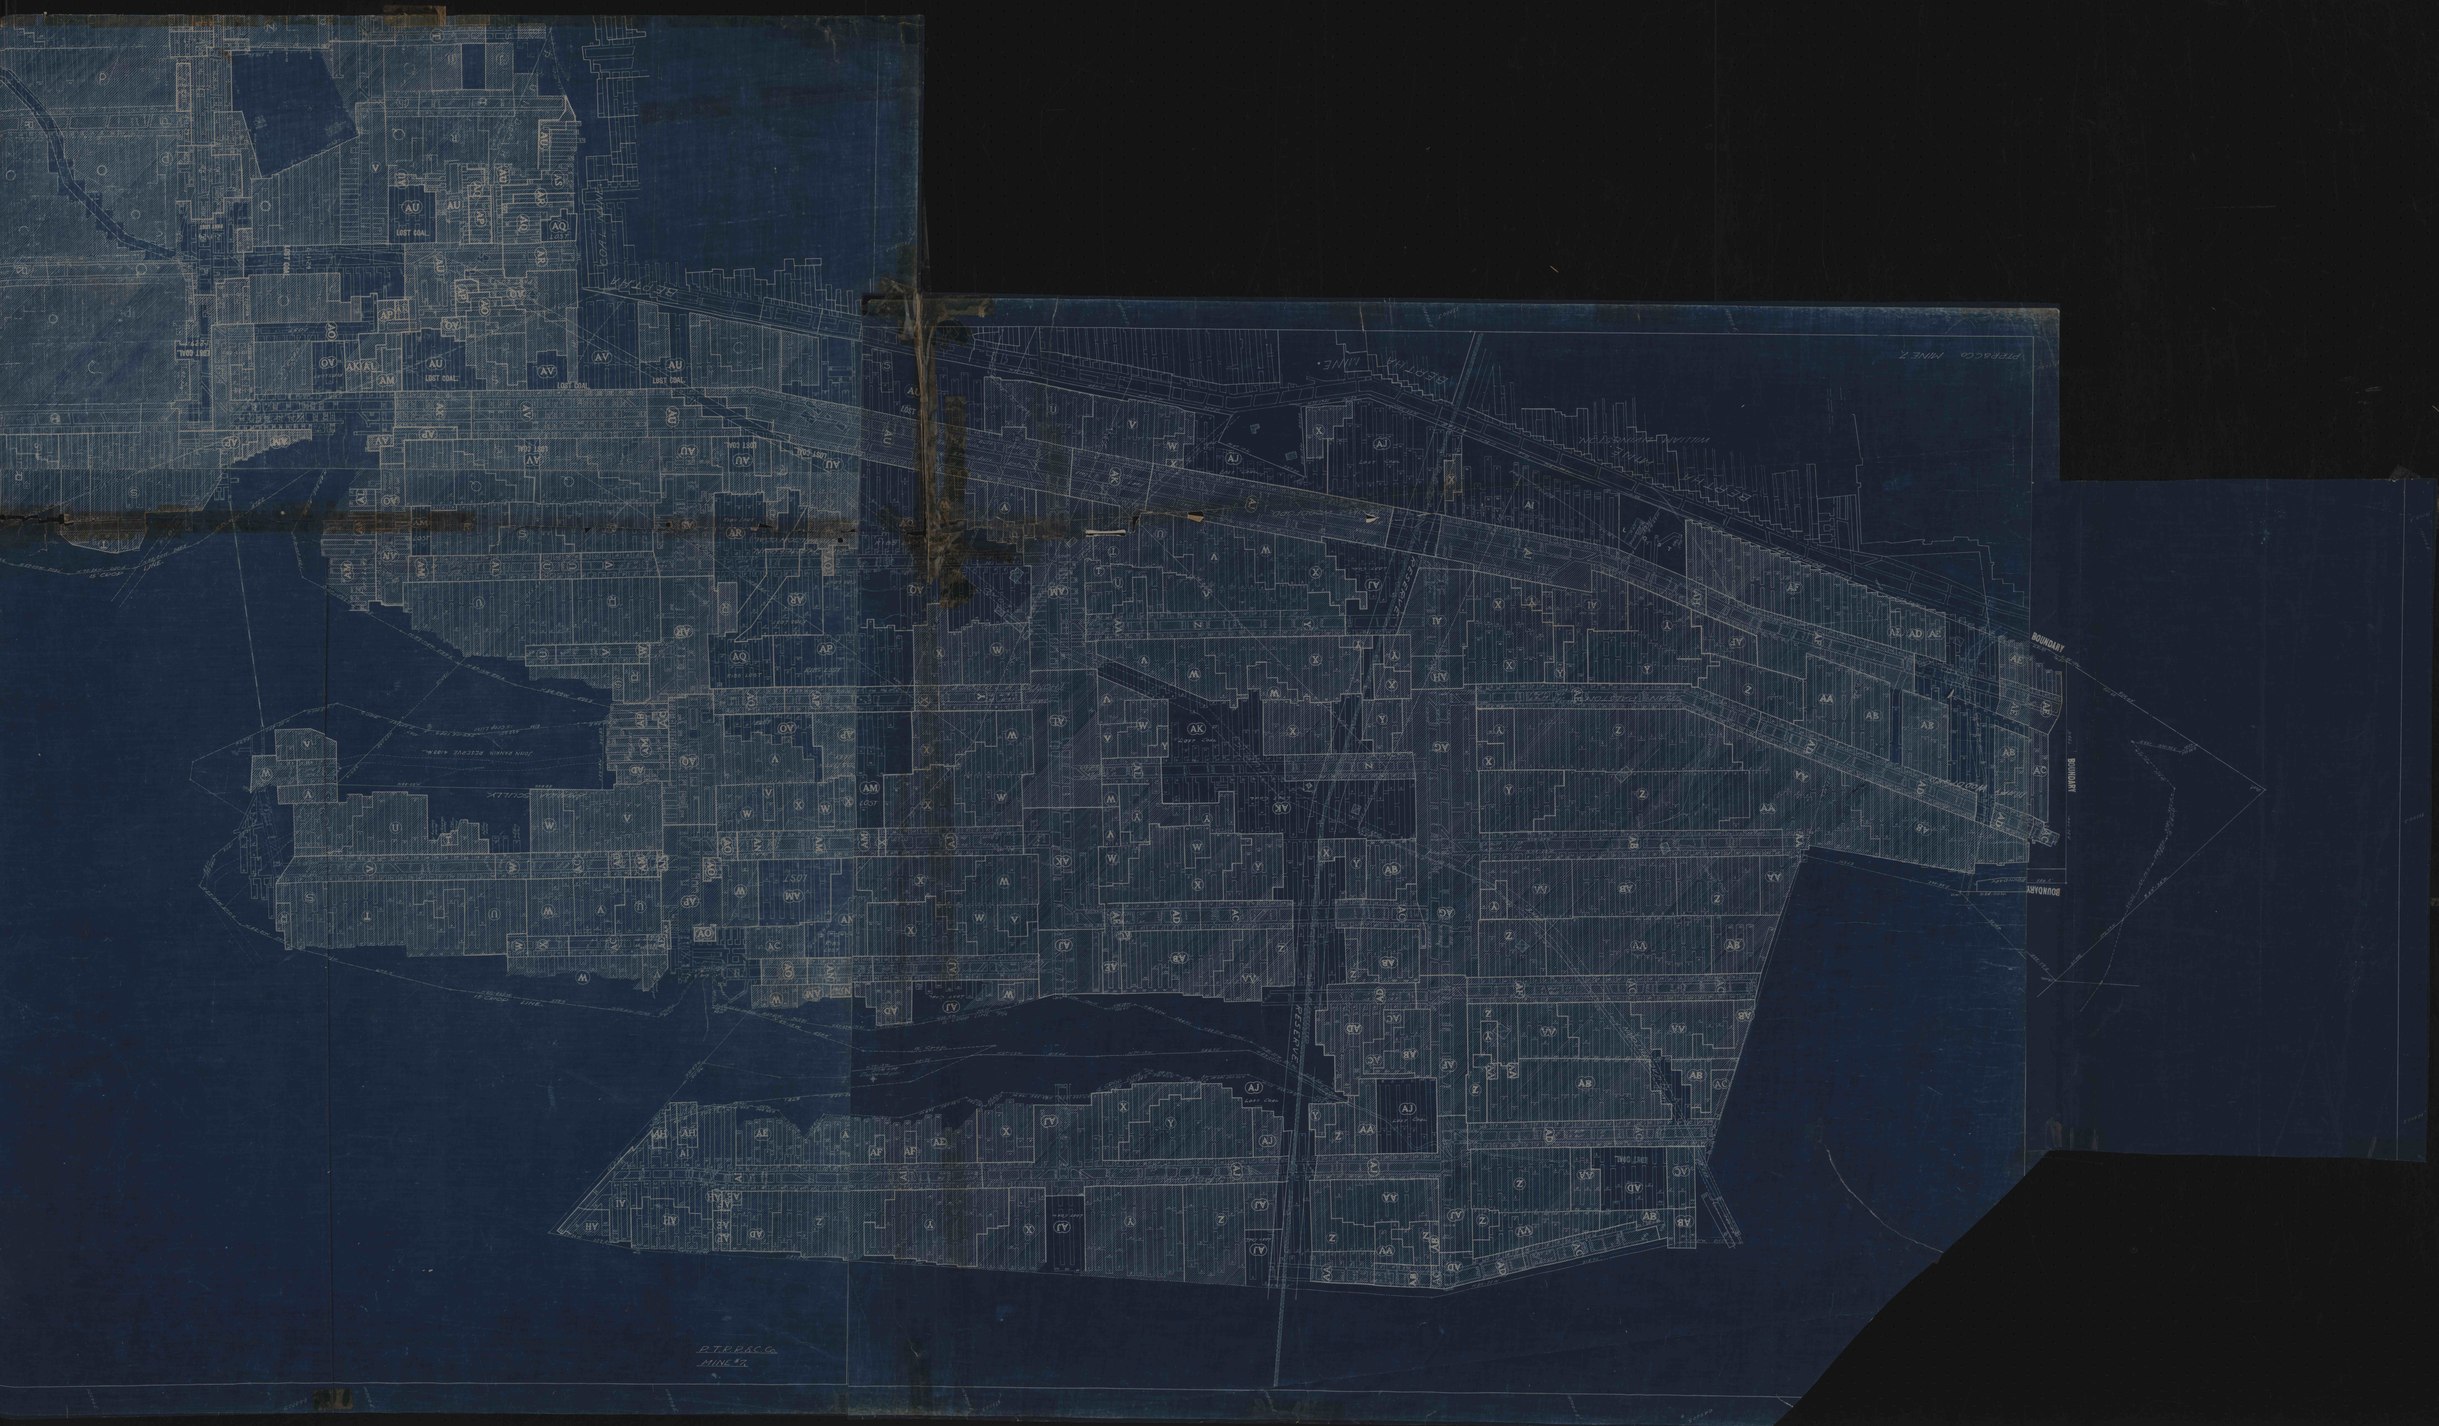
P.T.R.R.C.O.
MINE No. 7.
BOUNDARY
BOUNDARY
BOUNDARY
LOST COAL