

GRAZIER COAL MINING CO.

GRAZIER C.M. CO.


WILMORE COAL CO.

JOSEPH CUSTER

CAMBRIA FUEL CO.

Potochar & Potochar Coal Co.  
"Potochar Mine"  
Operated Surveys A, B, C

Index To Surveys		
115012	B	D. Cortese E.S.
115013	A	D. Cortese E.S.
115014	A	D. Cortese E.S.
115015	C	D. Cortese E.S.

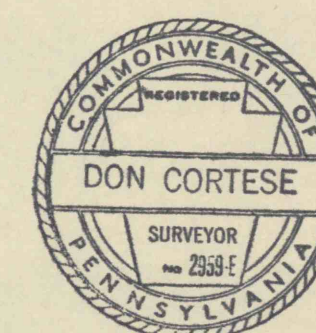

WM. NAU COAL CO.  
NEW JASAHILL COAL CO.  
B-SEAM MINING OPERATIONS  
SITUATE IN

CONEMAUGH TWP. SOMERSET CO. PA.

SCALE 1"=100'

9-2-1955

#2156  
12-30-55  
C.C.

