


JOHN HOFFMAN


BRUCE HARMON

BETTY SNELL

DOLMOVICH

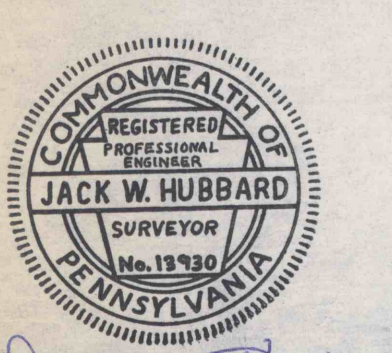

Jack W. Hubbard
1-21-69

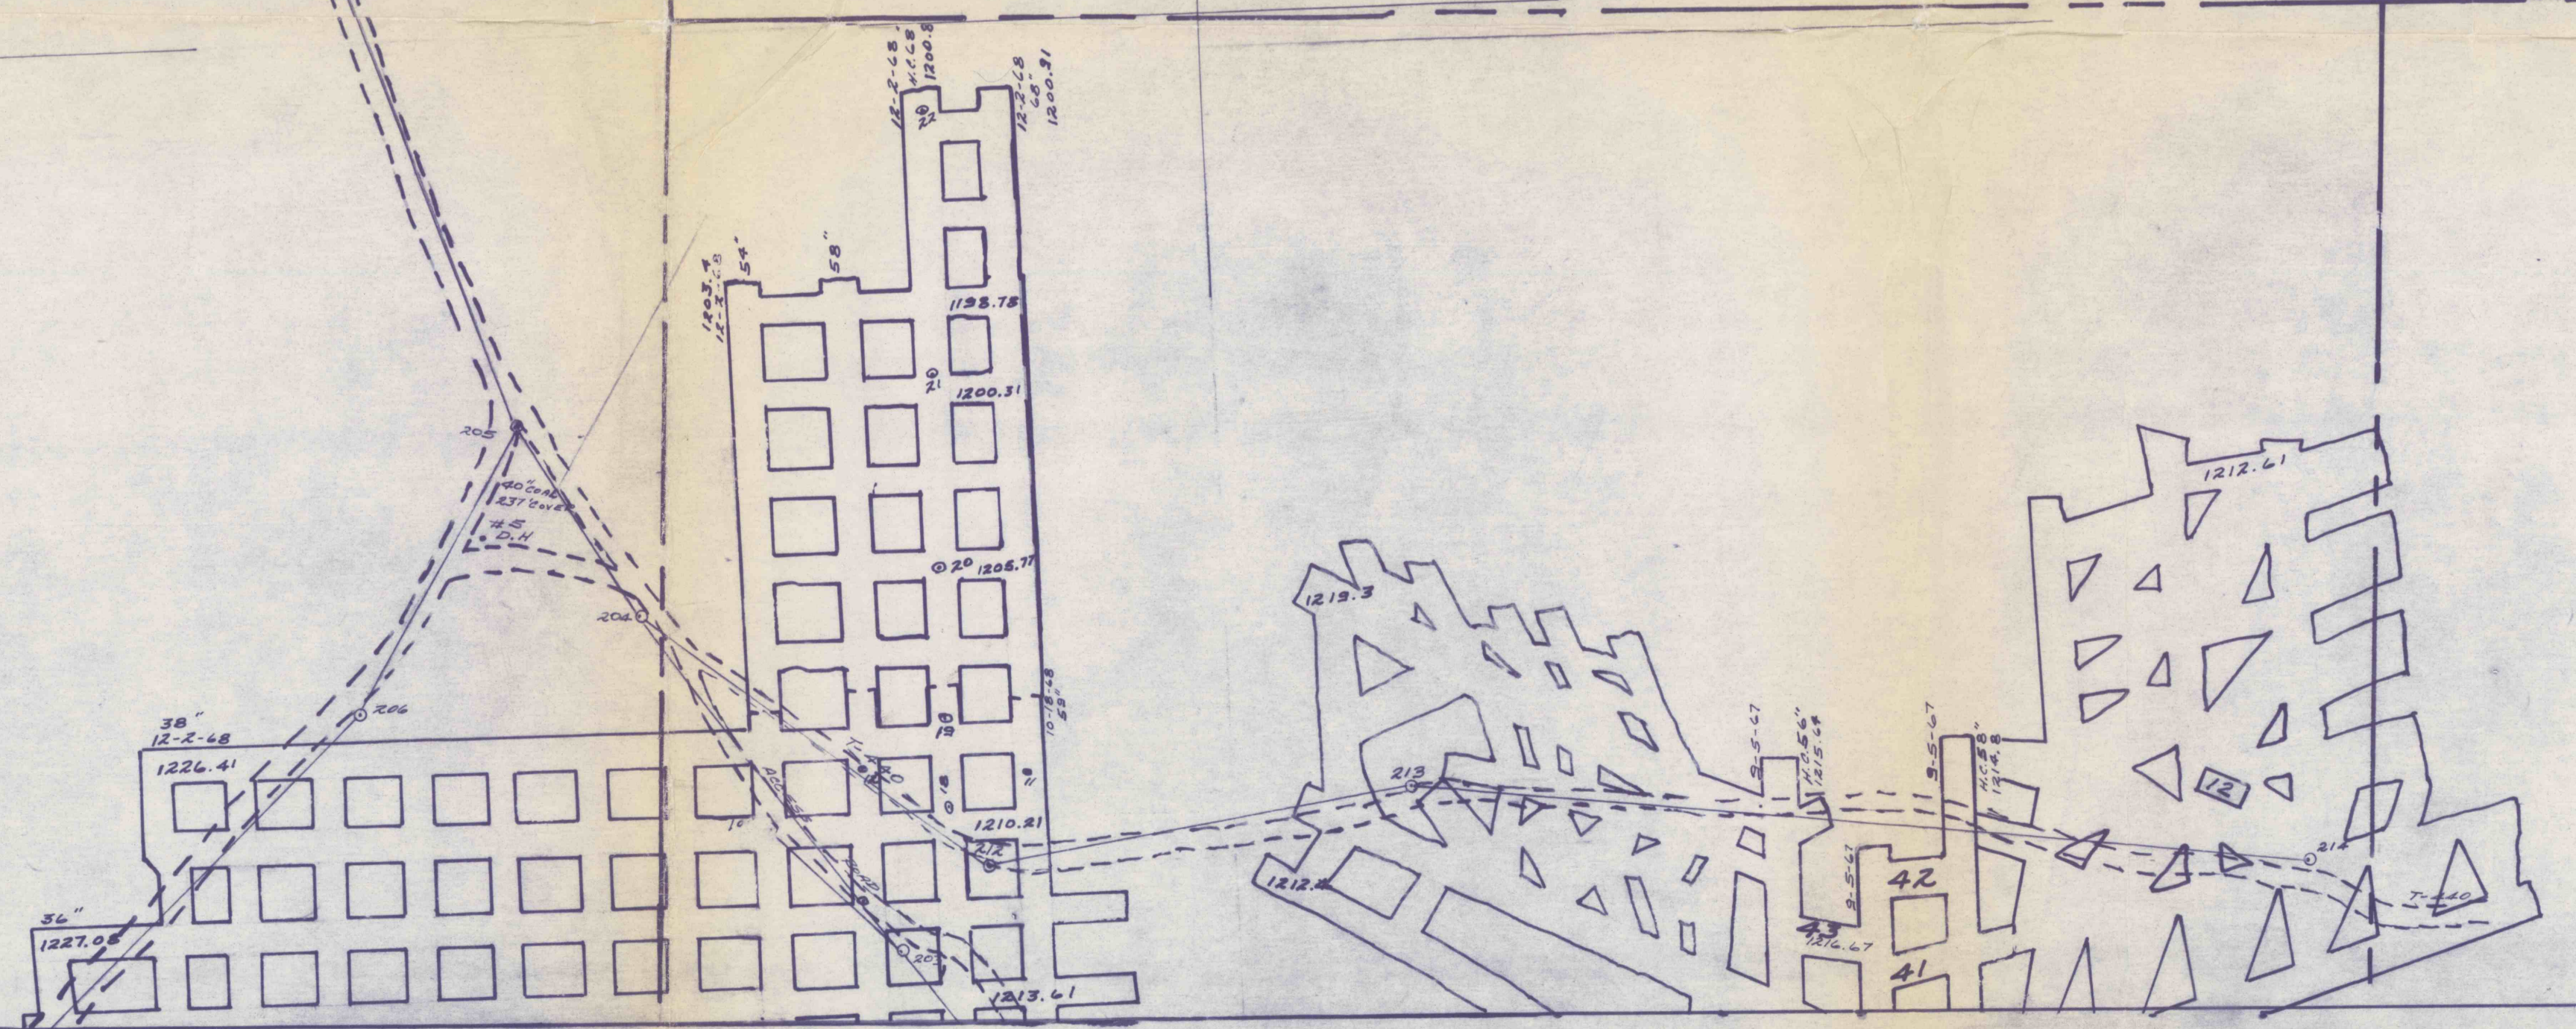

12-21-69
12-31-69
L.O.