


Sold to James Sperry & Co. Birmingham
 580 Ac #738
 301 " #2439
 488
 0-70
 518 Ac #1242

No ADDITIONAL
 MINING EXCEPT
 AS SHOWN

Support Area
 ROBT SWELTZER SURF

- LEGEND
- CONTEMPLATED MINING 1-2-68 to 7-2-68
 - SUPPORT AREA
 - PROTECTED STRUCTURE
 - MINING COMPLETED AREA
 - BOUNDARY LINE

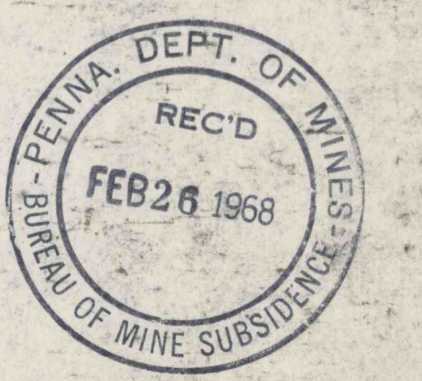

PONFEIGH-PINEHILL SMOKELESS COAL CO.
 BROTHERSVALLEY TWP, SOMERSET CO, PA. SCALE 1"=100' FEB. 21, 1968

#2167
 12-31-69
 CC