
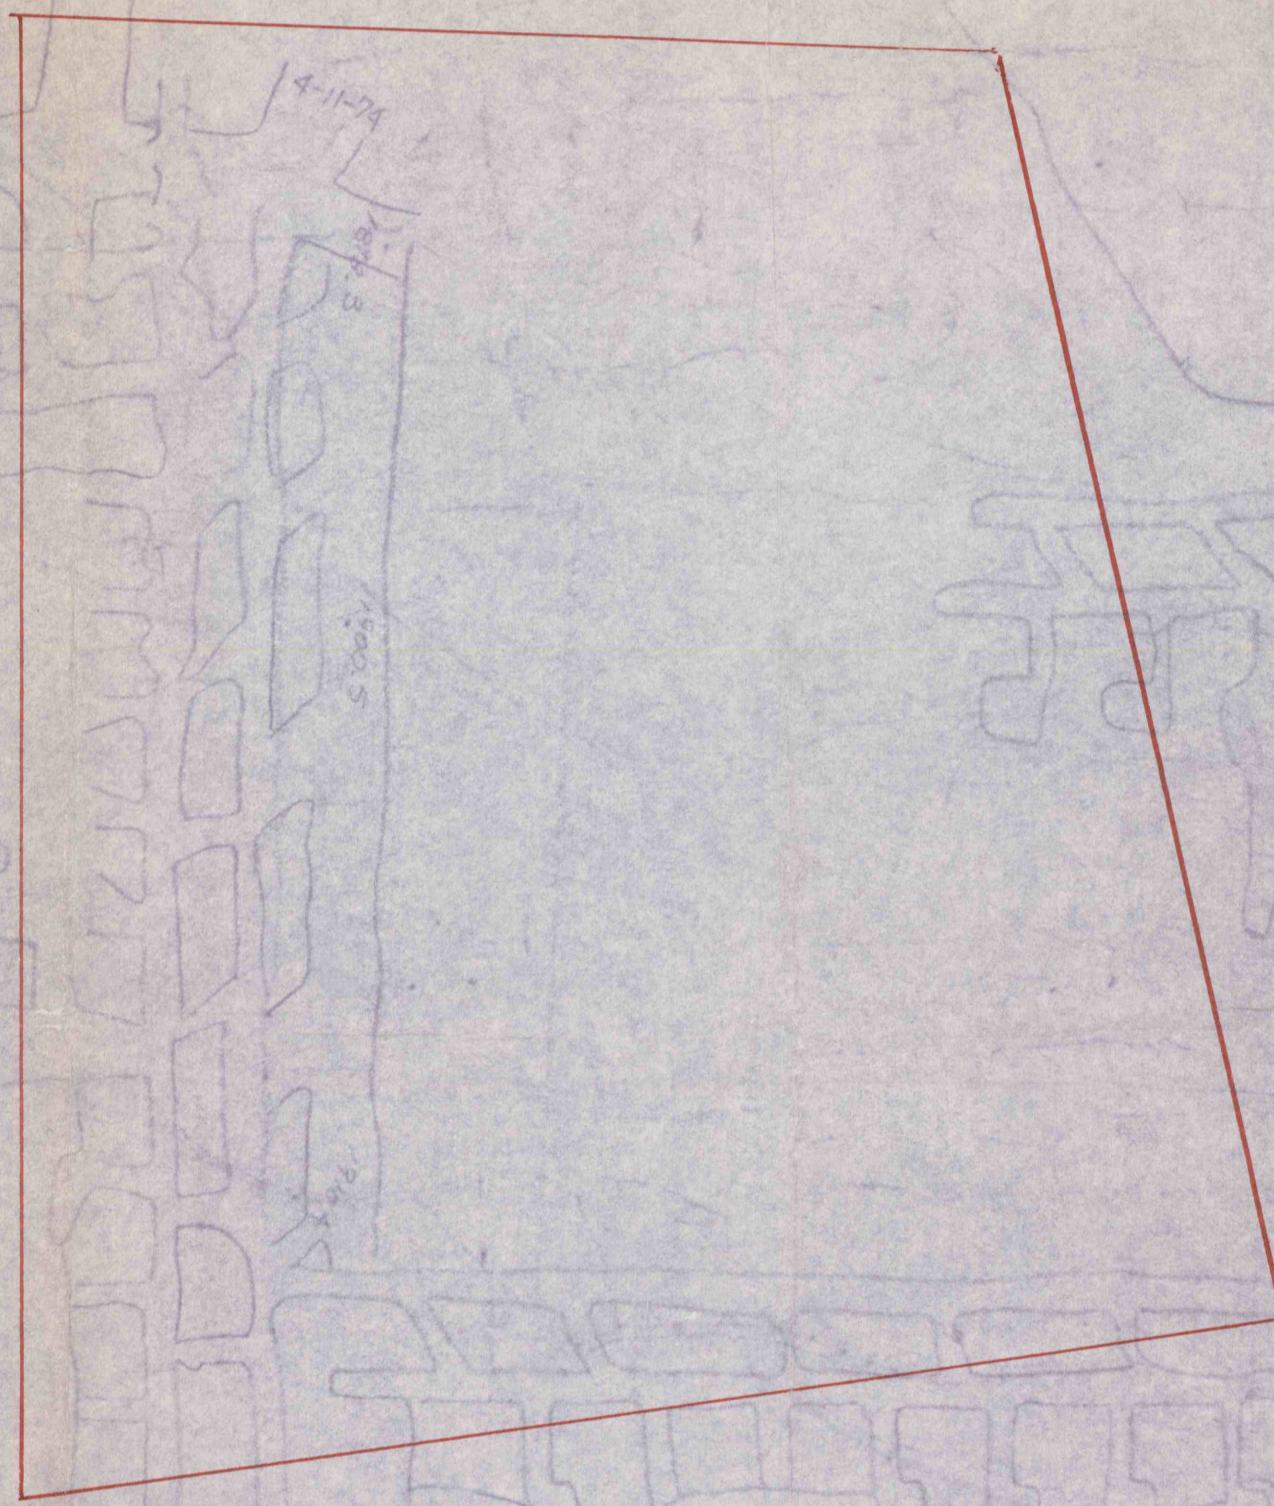


POTOCHAR MINE RECEIVED 2-22-75

PAINT & SHADE TWP. SOMERSET CO. PA. SCALE 1" = 100' NOV. 1953

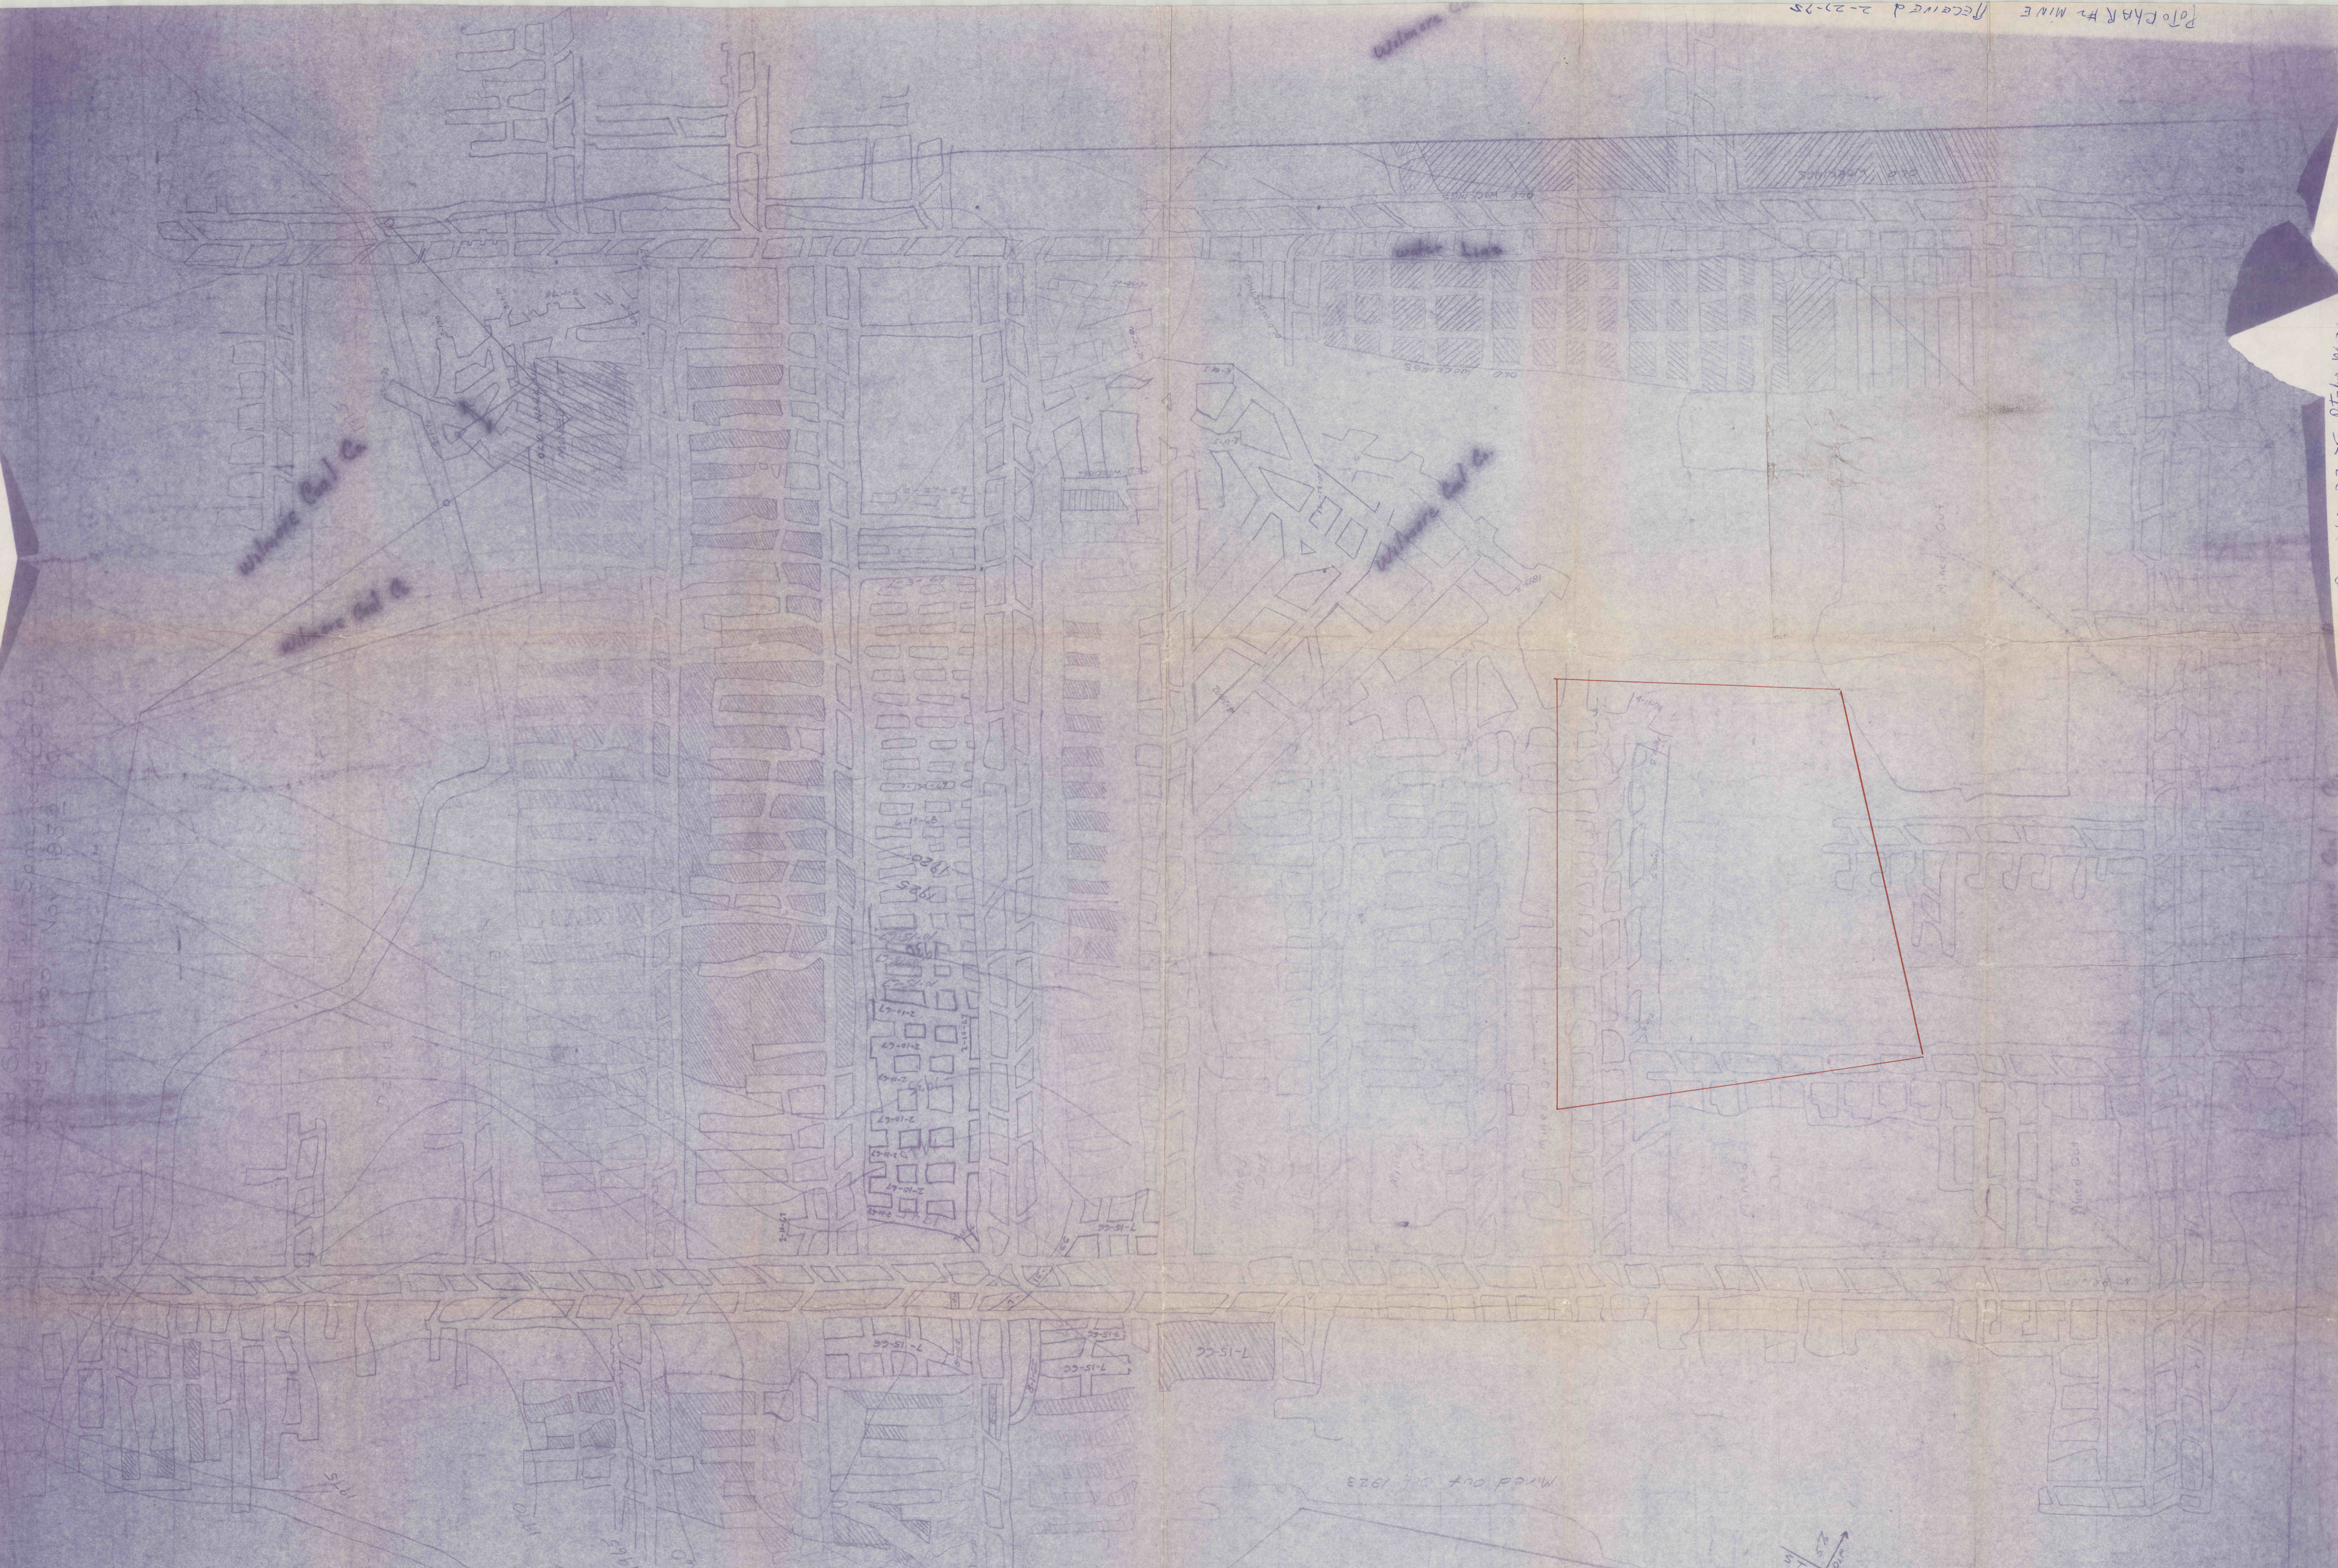


ELY & FRENCH
POTOCHAR & POTOCHAR COAL CO.
PAINT & SHADE TWP, SOMERSET CO, PA.
SCALE 1" = 100'
OCT. 1, 1966
POTOCHAR MINE - C

SURVEY OF WORKS BY OTHERS



202' of entry after mining is completed will be sealed off. There shall not fill to this point. There will be no water coming out the entrance.

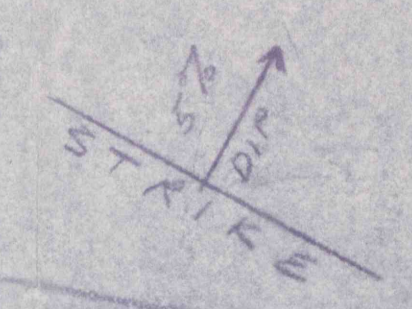

Wilmore Coal Co.

□ = Area to be mined - 10-17-74 to 4-17-75

#2177
1-11-6000
C.C.

Received 2-27-75 Potochar No. 2