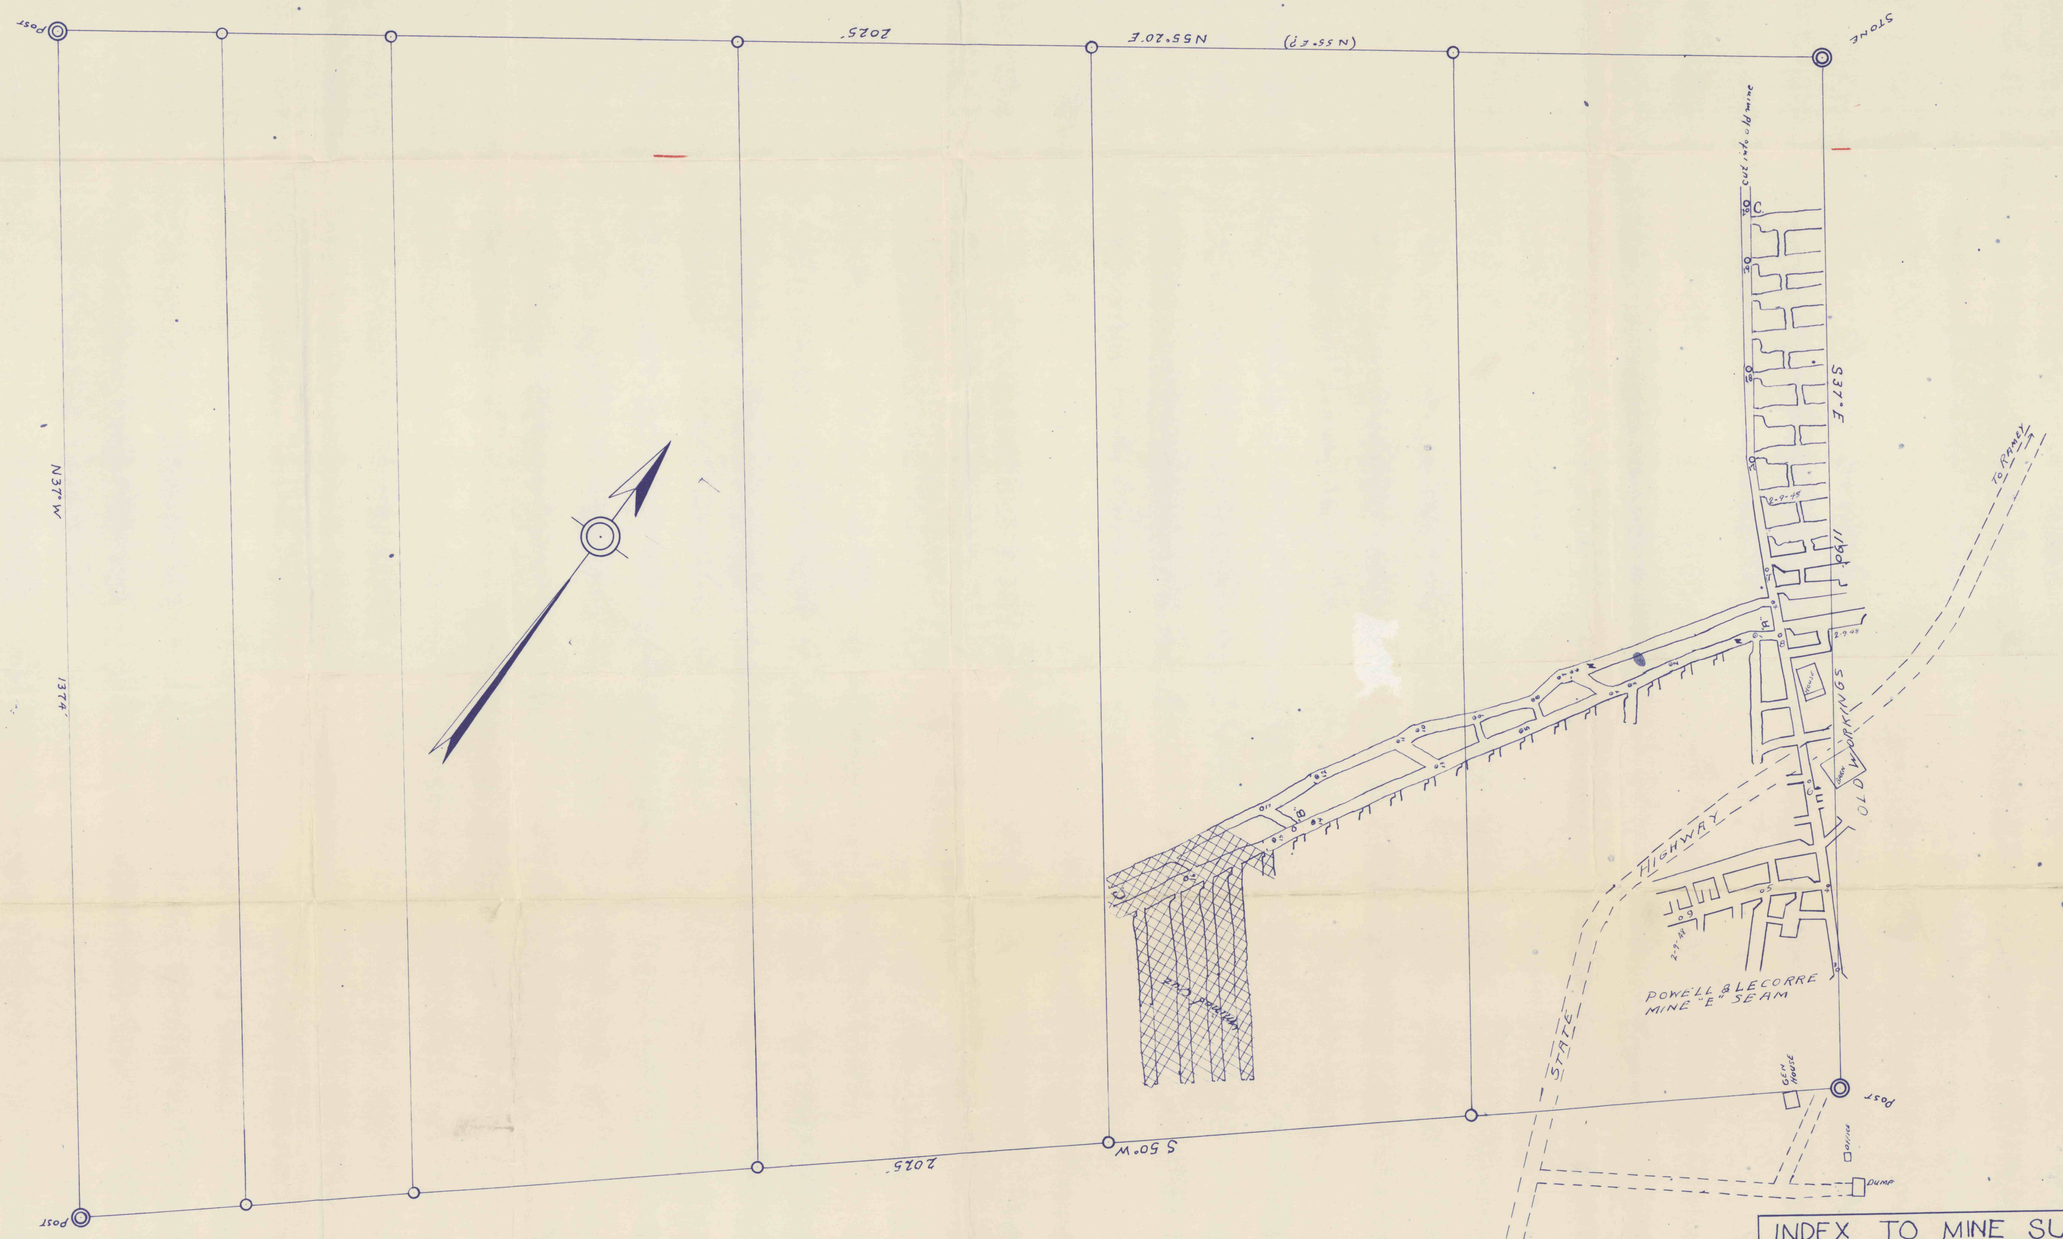

INDEX TO MINE SURVEYS			
LETTER	DATE	SURVEYED BY	PLATTED BY
	2-9-48	LUCAS & MORGAN	LUCAS & MORGAN
A	9-21-48	Thomas W. Heil	Thomas W. Heil
B	2-3-50	Thomas W. Heil	Thomas W. Heil
C	6-30-55	Guy A. Heil	Guy A. Heil

MAP OF
POWELL AND LECORRE MINE
OPERATED BY D. POWELL & LECORRE BROS.
GULICH TWP., CLEARFIELD COUNTY PA.
SCALE 1"=100'

NOTE
PROPERTY LINES, LOCATION OF DRIFT, AND BUILDINGS TAKEN FROM OLD MAPS WHICH DO NOT AGREE IN DISTANCE OR ANGLES

#2185
2-31-50
CC