


NEW SHAWMUT MINING CO.
 ST. MARYS, PA.
 PROCTOR NO. 3 (CALLY NO. 1)
 JAY TWP. ELK COUNTY, PA.
 SCALE - 1" = 100'
 SURVEY DATE - 11-22-68

James D. Brown
 P.E. # 9447-E

LEGEND
 CONTEMPLATED MINING - 11-22-68 TO 5-22-69
 SUPPORT AREA- *retreat work*
 PROTECTED STRUCTURES -
 MINING COMPLETED -

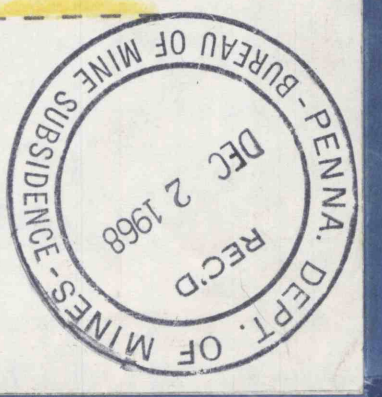

#2200
 12-21-68
 CC