


CARMEN PARZIALE-MINE
 SURVEY EXTENDED TO
 MO. DAY YEAR BY
 MAY 17 1934 R.R.B.
 DEC 17 1961 L.H.B.
 MAR 9 1964 L.H.B.
 MAR 8 1965 " " "

CLIFF BECK

SCALE 1"=100'



NEWSHAMMUT MINING CO.
 PROCTOR NO. 4 MINE

SURVEY EXTENDED TO			
NOV	18	1958	BY S. Burch
MAR	30	1960	" " S. Burch
DEC	12	1960	" " " "
JAN	24	1962	" " " "
JAN	17	1963	" " " "
MAR	18	1964	" " " "
FEB	2	1965	" " " "
APRIL	27	1966	" " " "
JULY	25	1966	" " " "
NOV	16	1966	" " " "

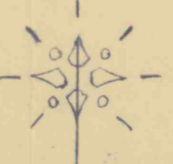

NEWSHAMMUT MINING CO.
 FEL

AREA WORKED OUT FROM JULY 25, 1966 TO NOVEMBER 30, 1966

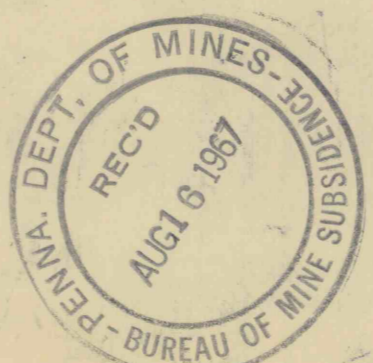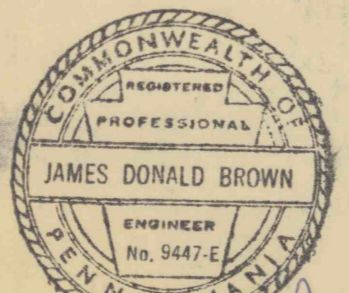

James Brown
 8/7/67

#2261
 12-31-99
 C.C.

5th Left