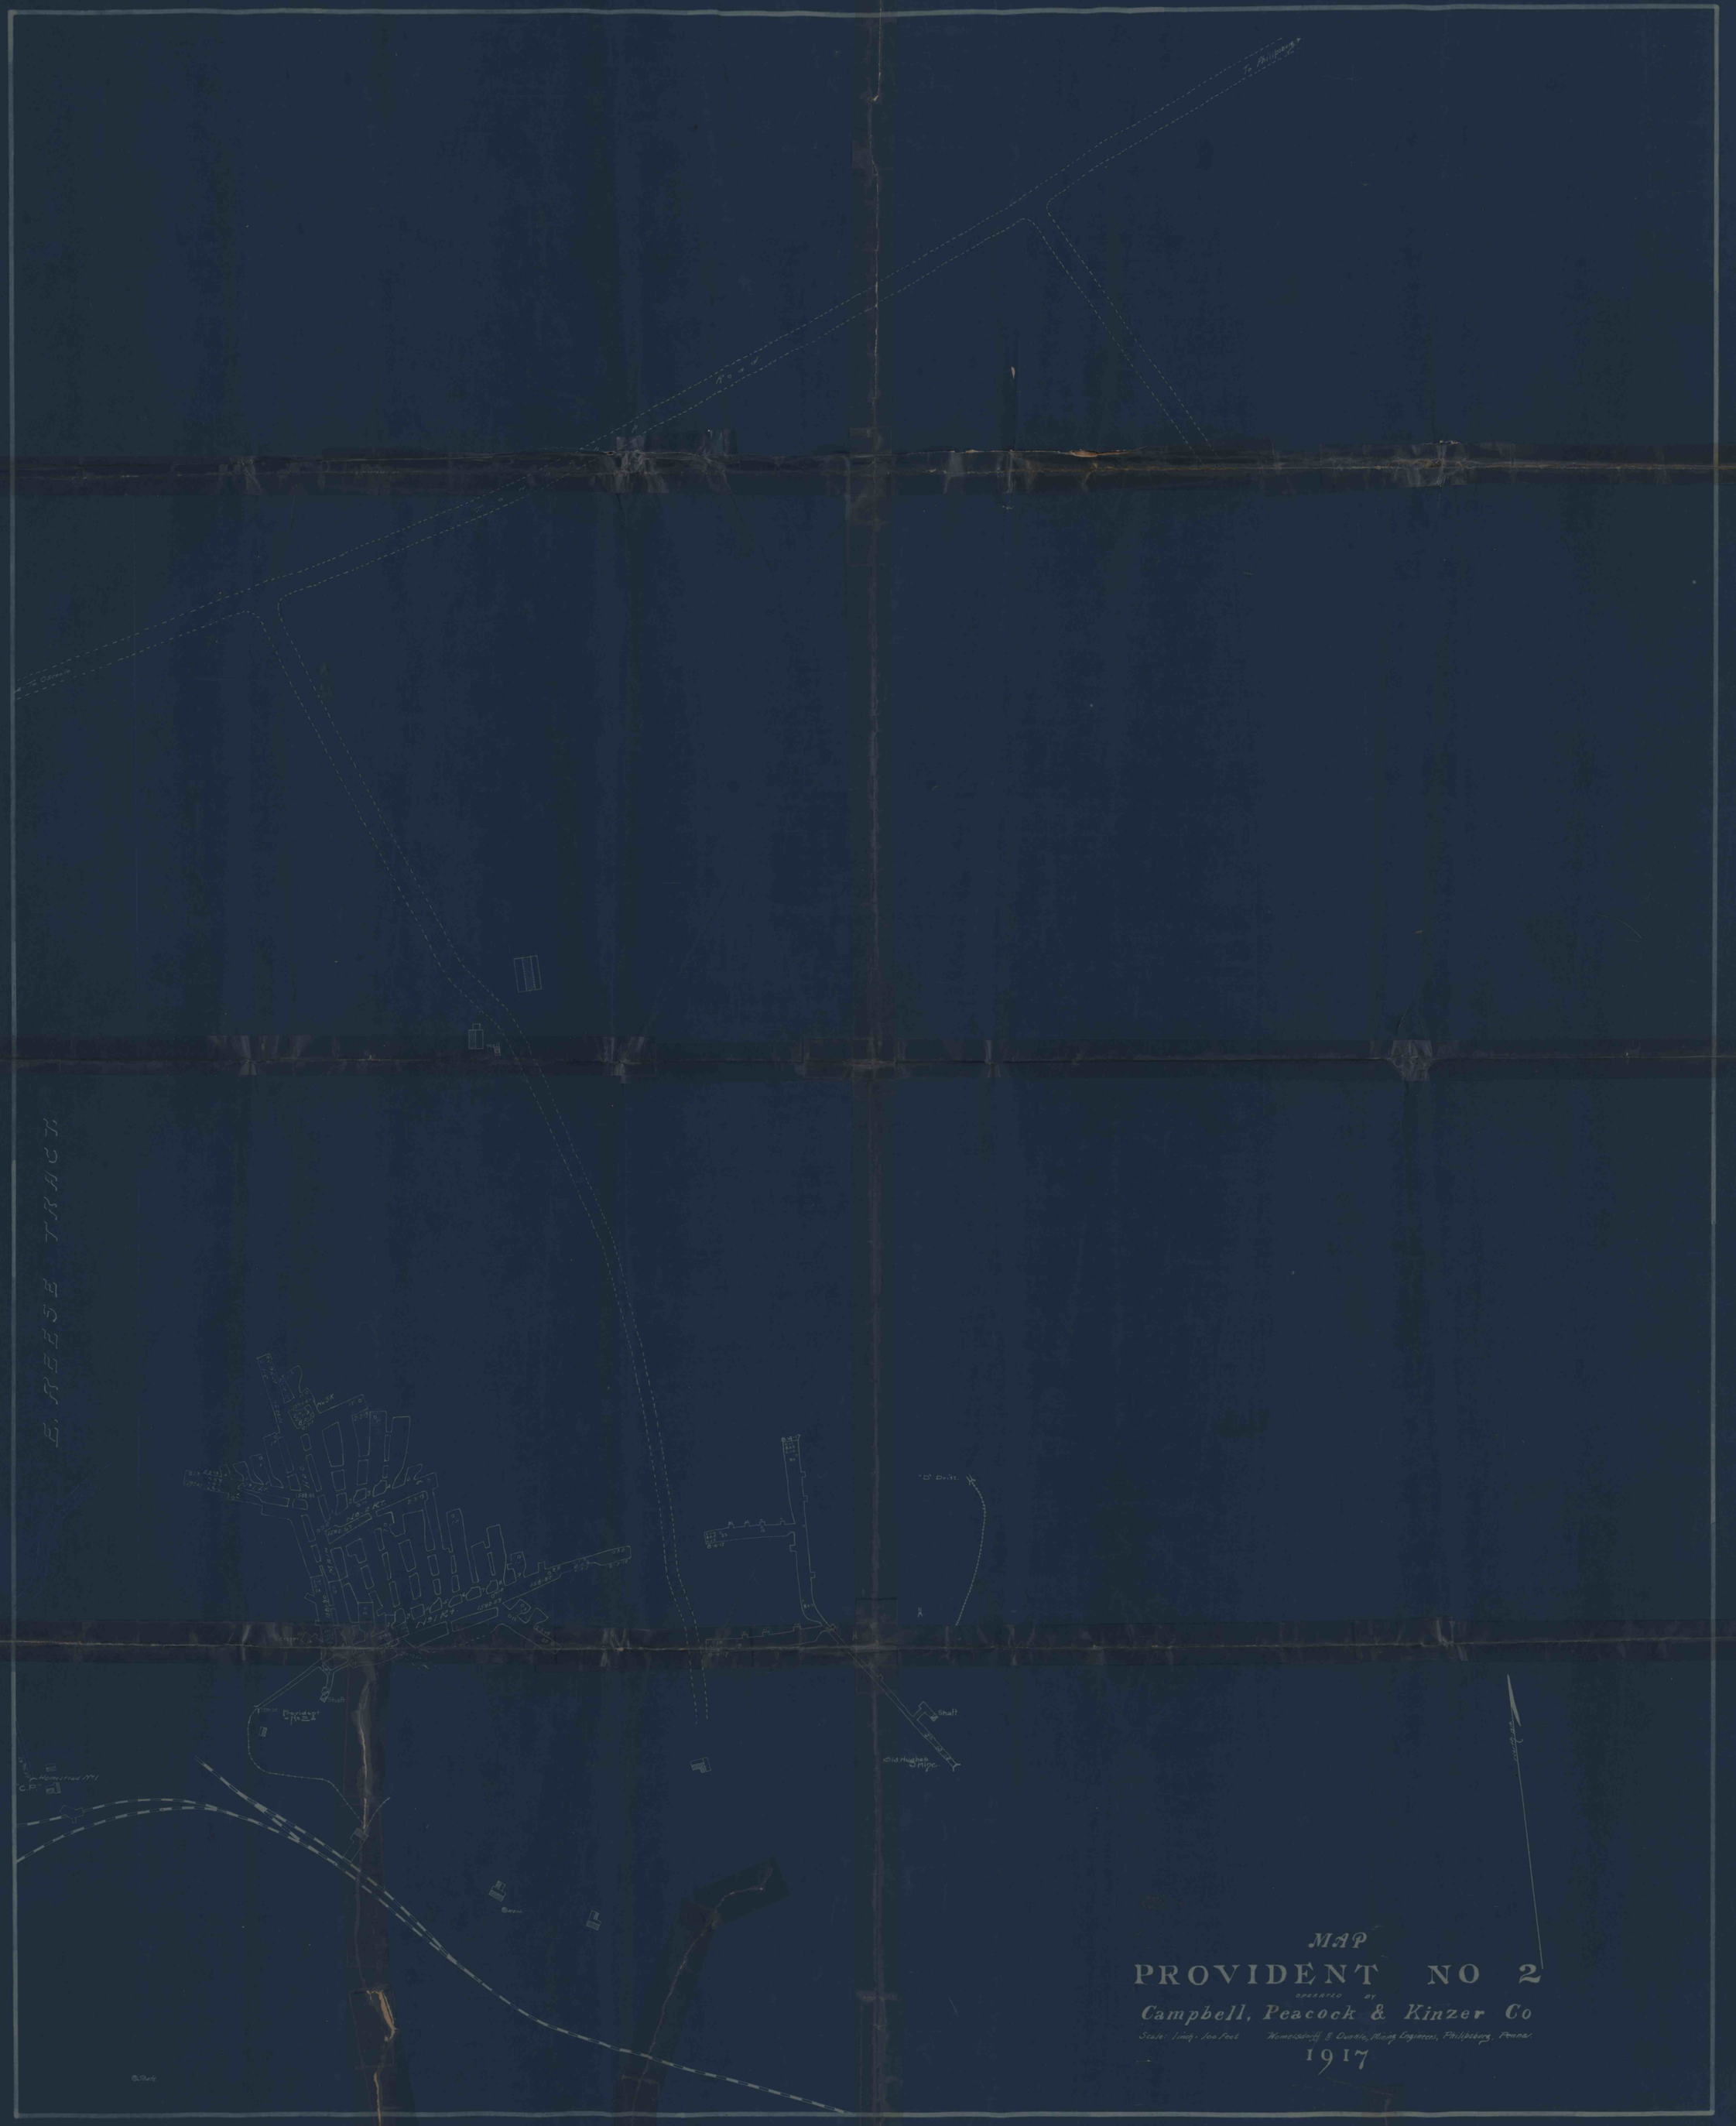

MAP
PROVIDENT NO 2

OPERATED BY

Campbell, Peacock & Kinzer Co

Scale: 1 inch = 100 Feet Homes-Ostoff & Durkee, Mining Engineers, Philipsburg, Penna.

1917