


N-2000

N-2000

N-1000

DUQUESNE LIGHT CO.  
WARWICK MINES  
- 411 N TITUS TRACT -

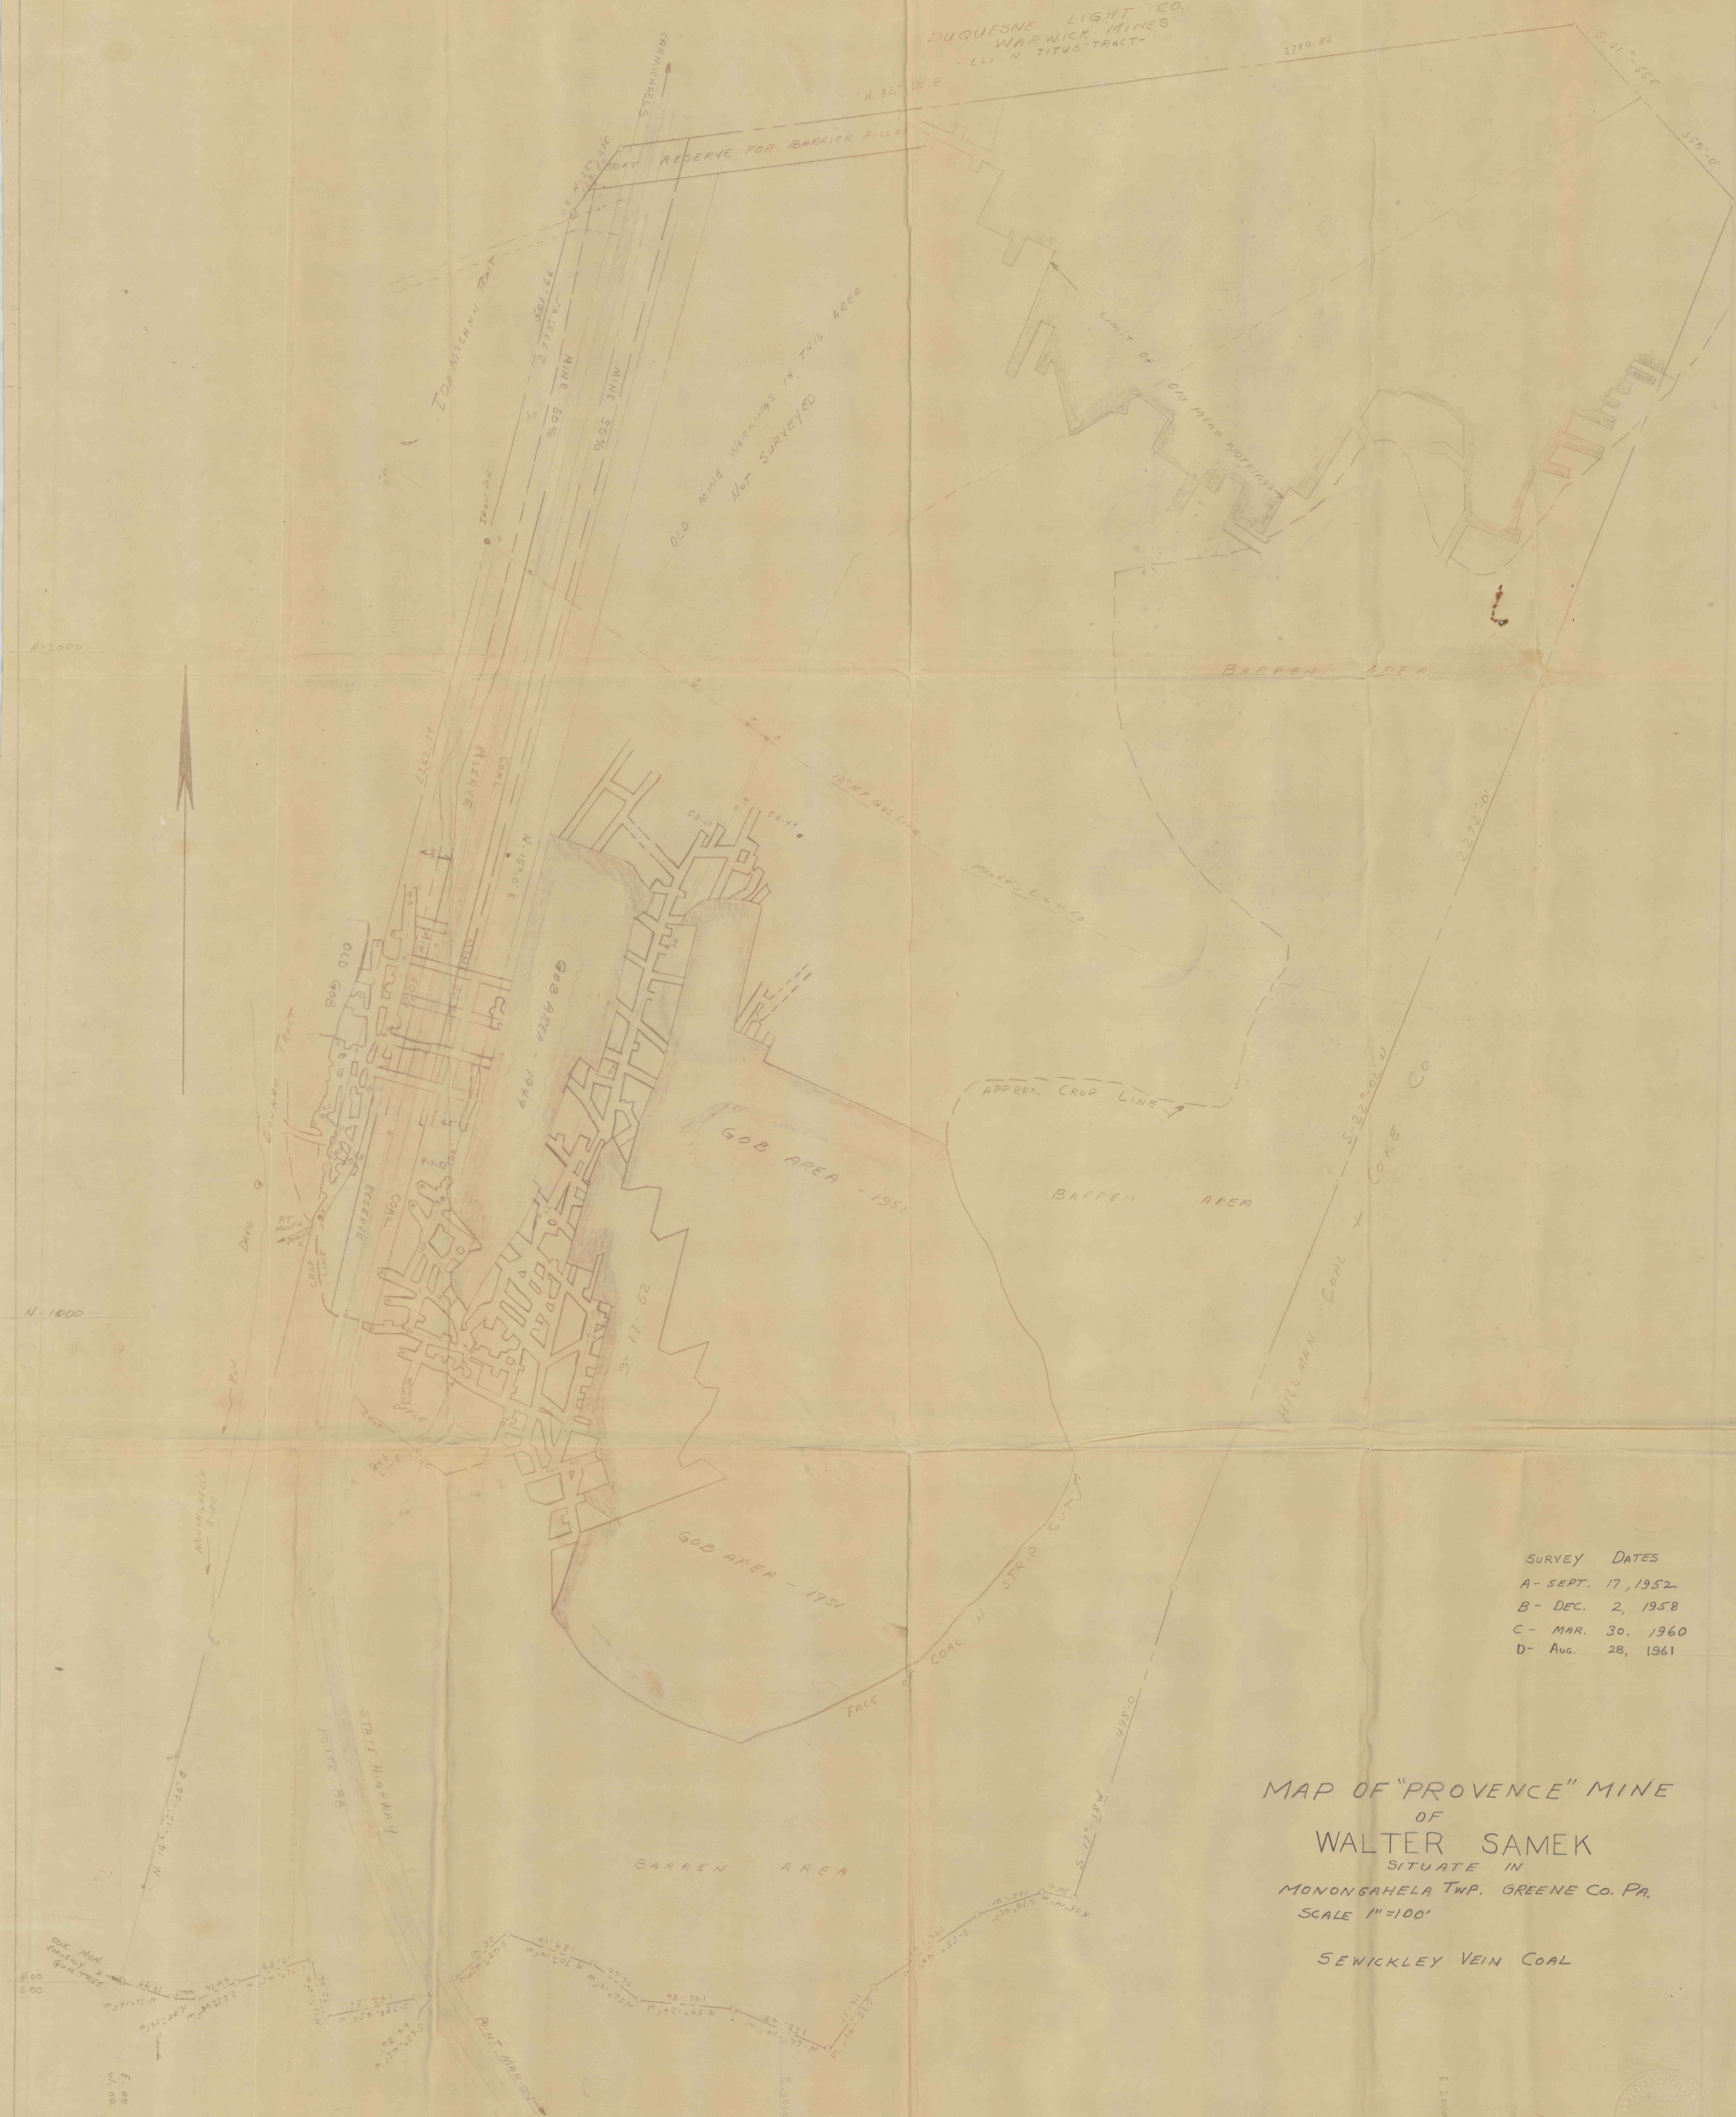

SURVEY DATES  
 A - SEPT. 17, 1952  
 B - DEC. 2, 1958  
 C - MAR. 30, 1960  
 D - Aug. 28, 1961

MAP OF "PROVENCE" MINE  
 OF  
 WALTER SAMEK  
 SITUATE IN  
 MONONGAHELA TWP. GREENE CO. PA.  
 SCALE 1"=100'

SEWICKLEY VEIN COAL

