


N-3000

N-2000

N-1000

DUQUESNE LIGHT CO.  
WARWICK MINES  
- ELI N TITUS TRACT -

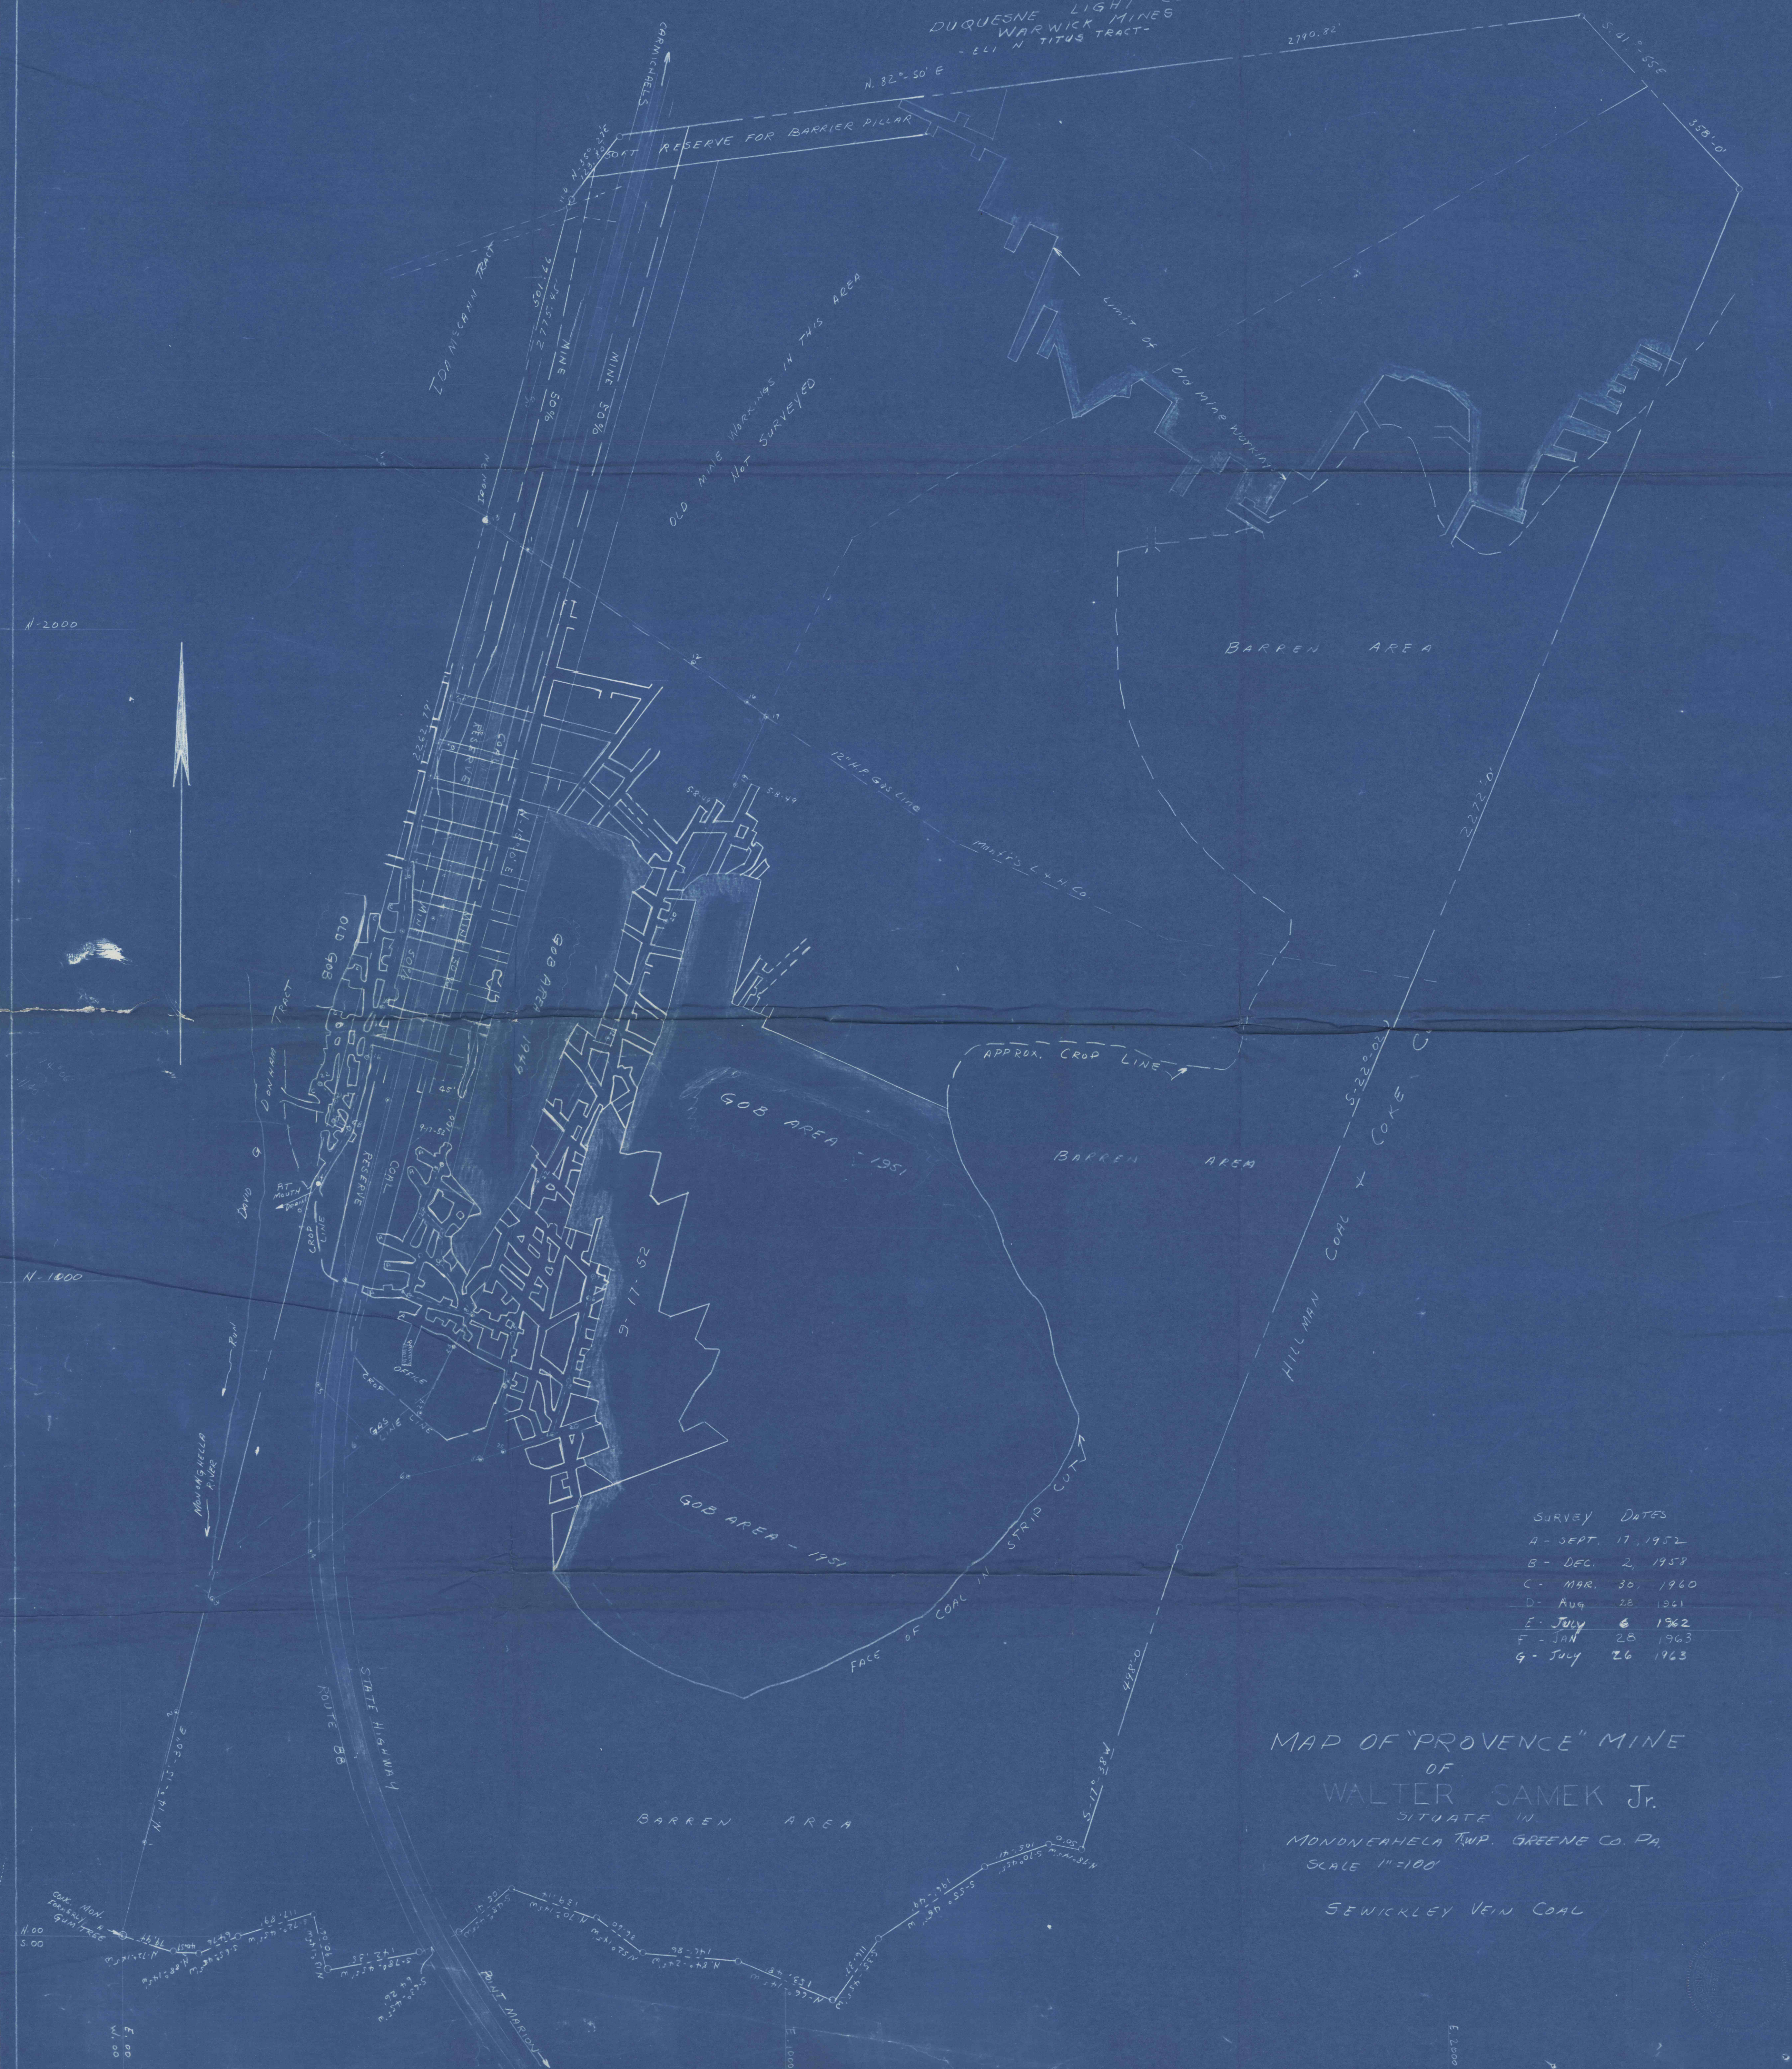

SURVEY DATES

A - SEPT. 17, 1952
B - DEC. 2, 1958
C - MAR. 30, 1960
D - AUG. 28, 1961
E - JULY 6, 1962
F - JAN. 28, 1963
G - JULY 26, 1963

MAP OF "PROVENCE" MINE  
OF  
WALTER SAMEK Jr.  
SITUATE IN  
MONONGAHELA TWP. GREENE CO. PA.  
SCALE 1"=100'  
SEWICKLEY VEIN COAL

E. 1000