


N-3000

N-2000

N-1000

DUQUESNE LIGHT CO
WARWICK MINES
- ELI N. TITUS TRACT

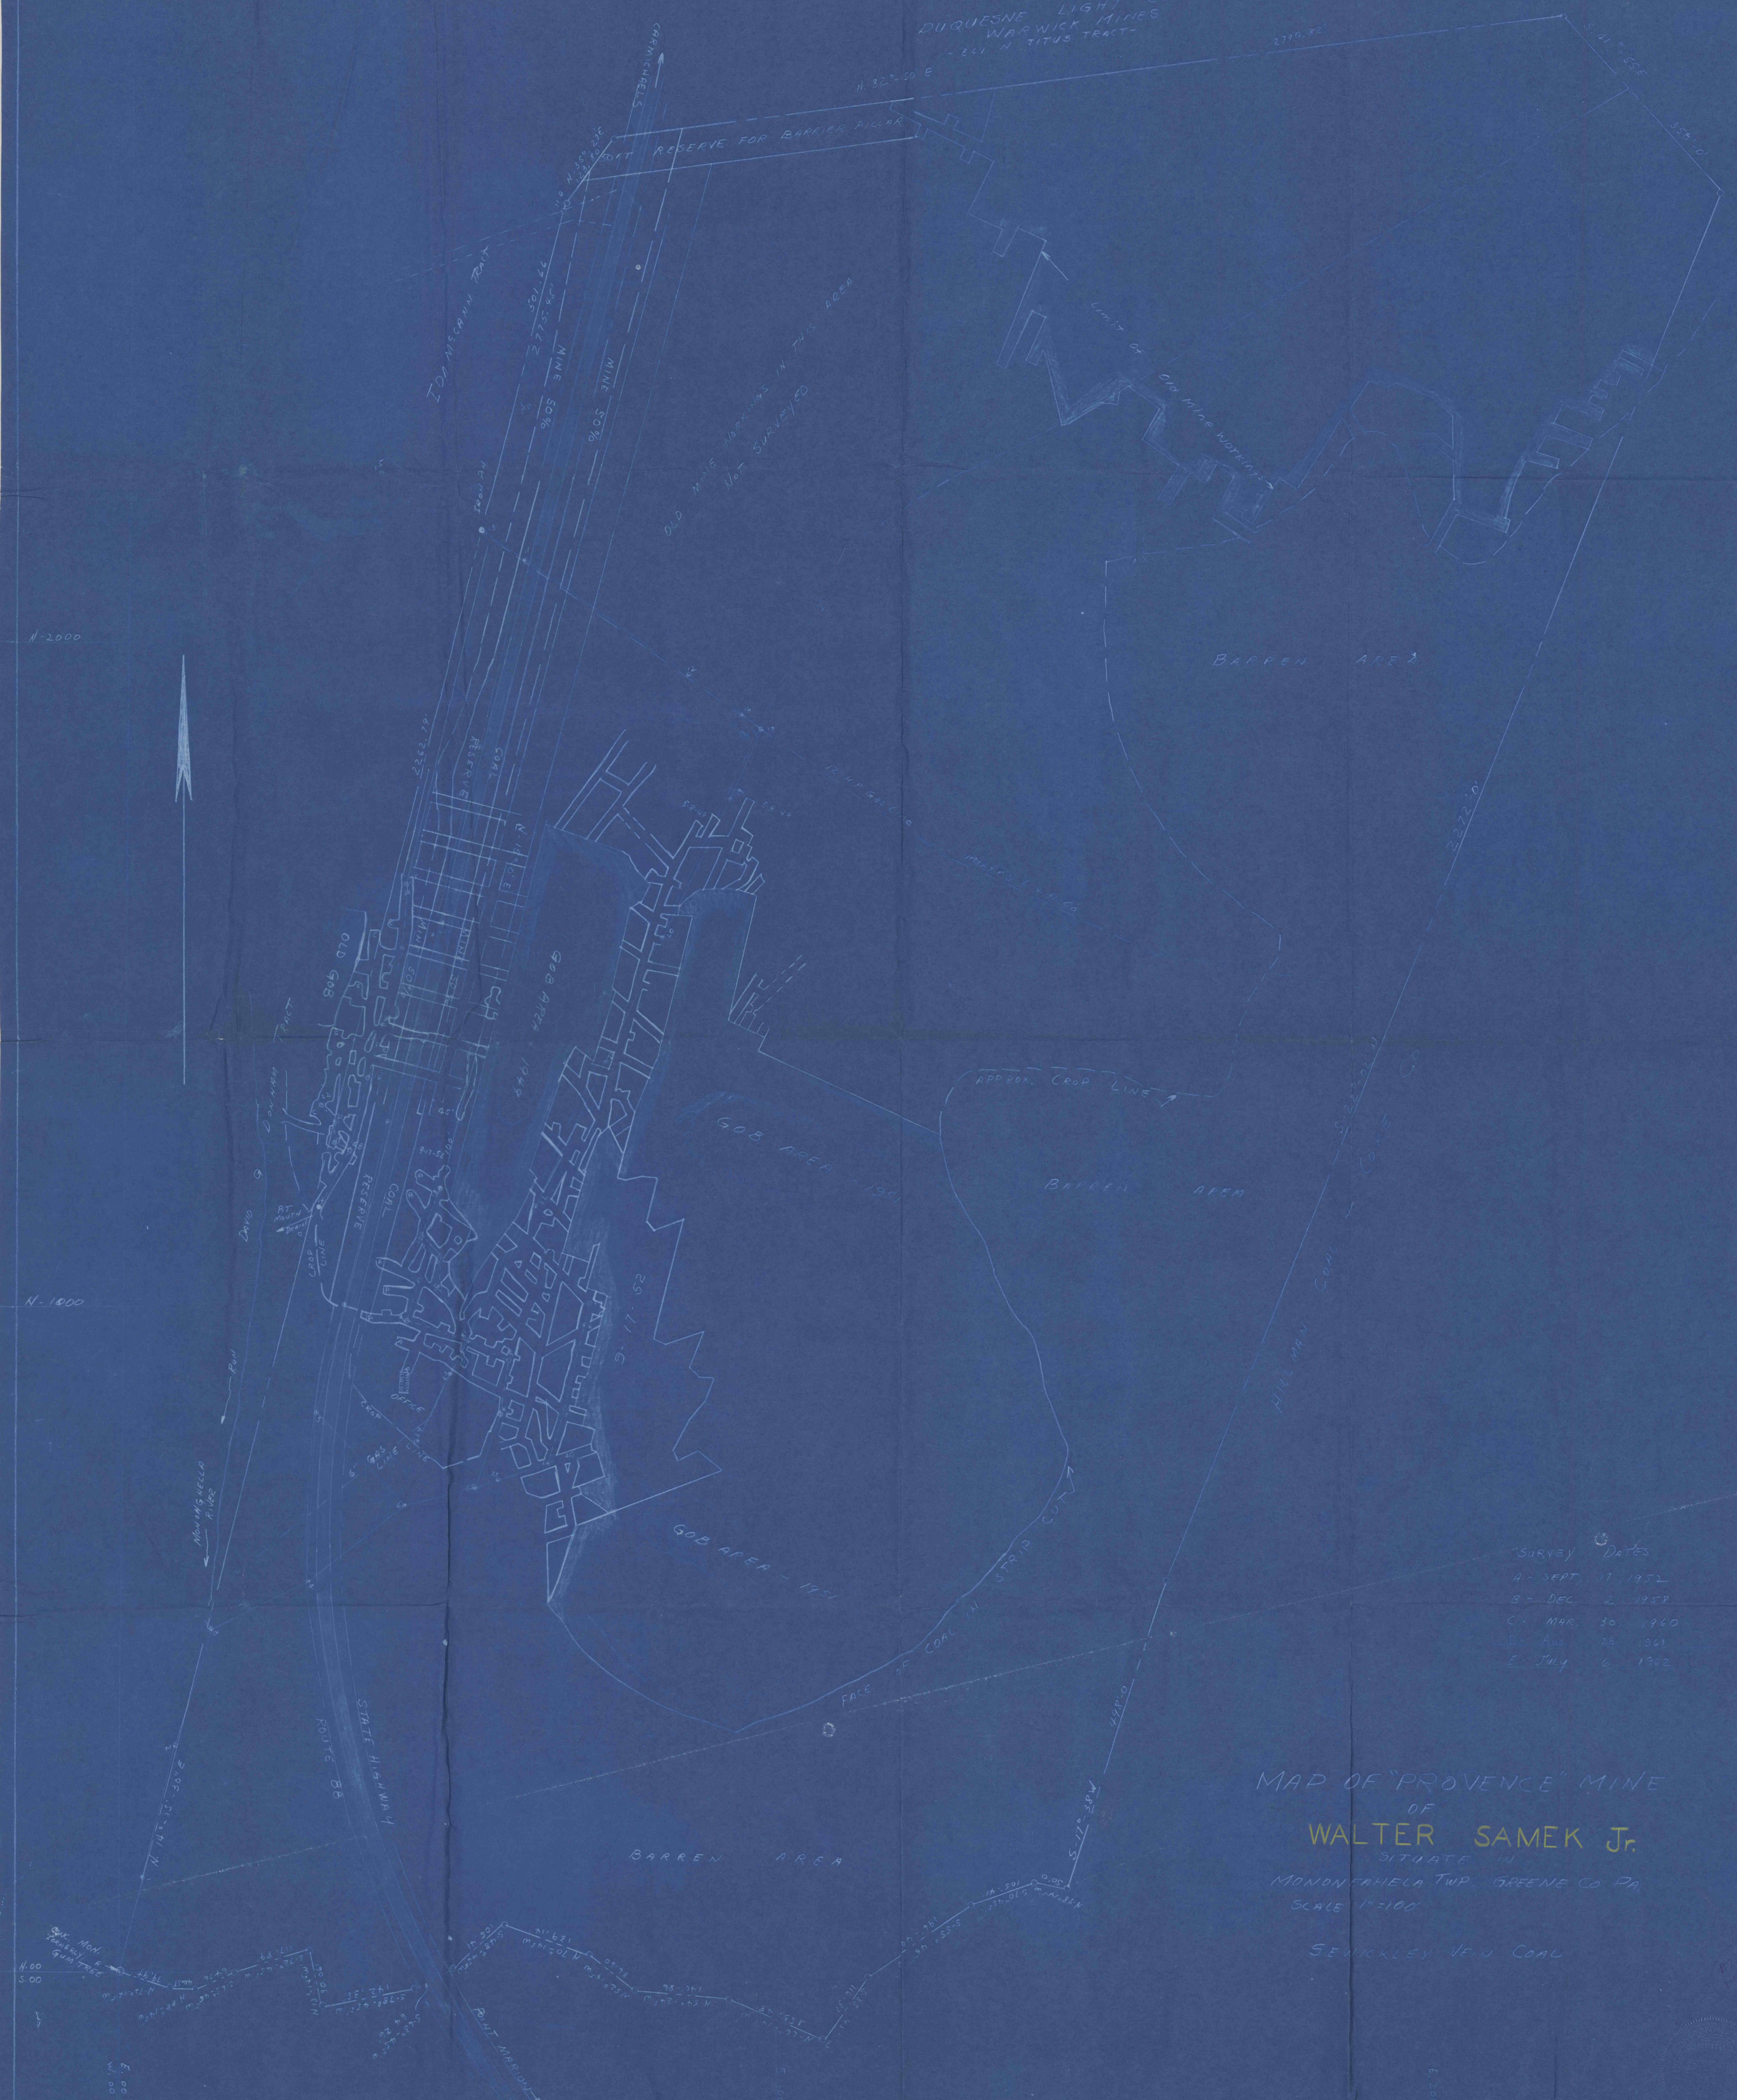

SURVEY DATES
 A - SEPT 17, 1952
 B - DEC 2, 1958
 C - MAR 30, 1960
 D - AUG 28, 1961
 E - JULY 6, 1962

MAP OF "PROVENCE" MINE
 OF
WALTER SAMEK JR.
 SITUATE IN
 MOUNDINGHELLA TWP. GREENE CO. PA.
 SCALE 1"=100'
 SEWICKLEY VAN COAL

