

CHAS. POPE TRACT  
(P.C.C. CO. OWN LEASE)

CHAS. POPE TRACT  
(P.C.C. CO. OWN LEASE)

NATHAN FOSTER  
(P.C.C. CO. OWN LEASE)


SWOPE TRACT

PRESENT DRAINAGE COURSE

4420  
14200

PATTON CLAY MFG. CO.

SCALE 1"=100'  
MAP OF NO. 1 MINE  
PATTON, PA. MAY, 1913  
C. PRIME SEAM  
Walter C. Kitchin, Eng'r.

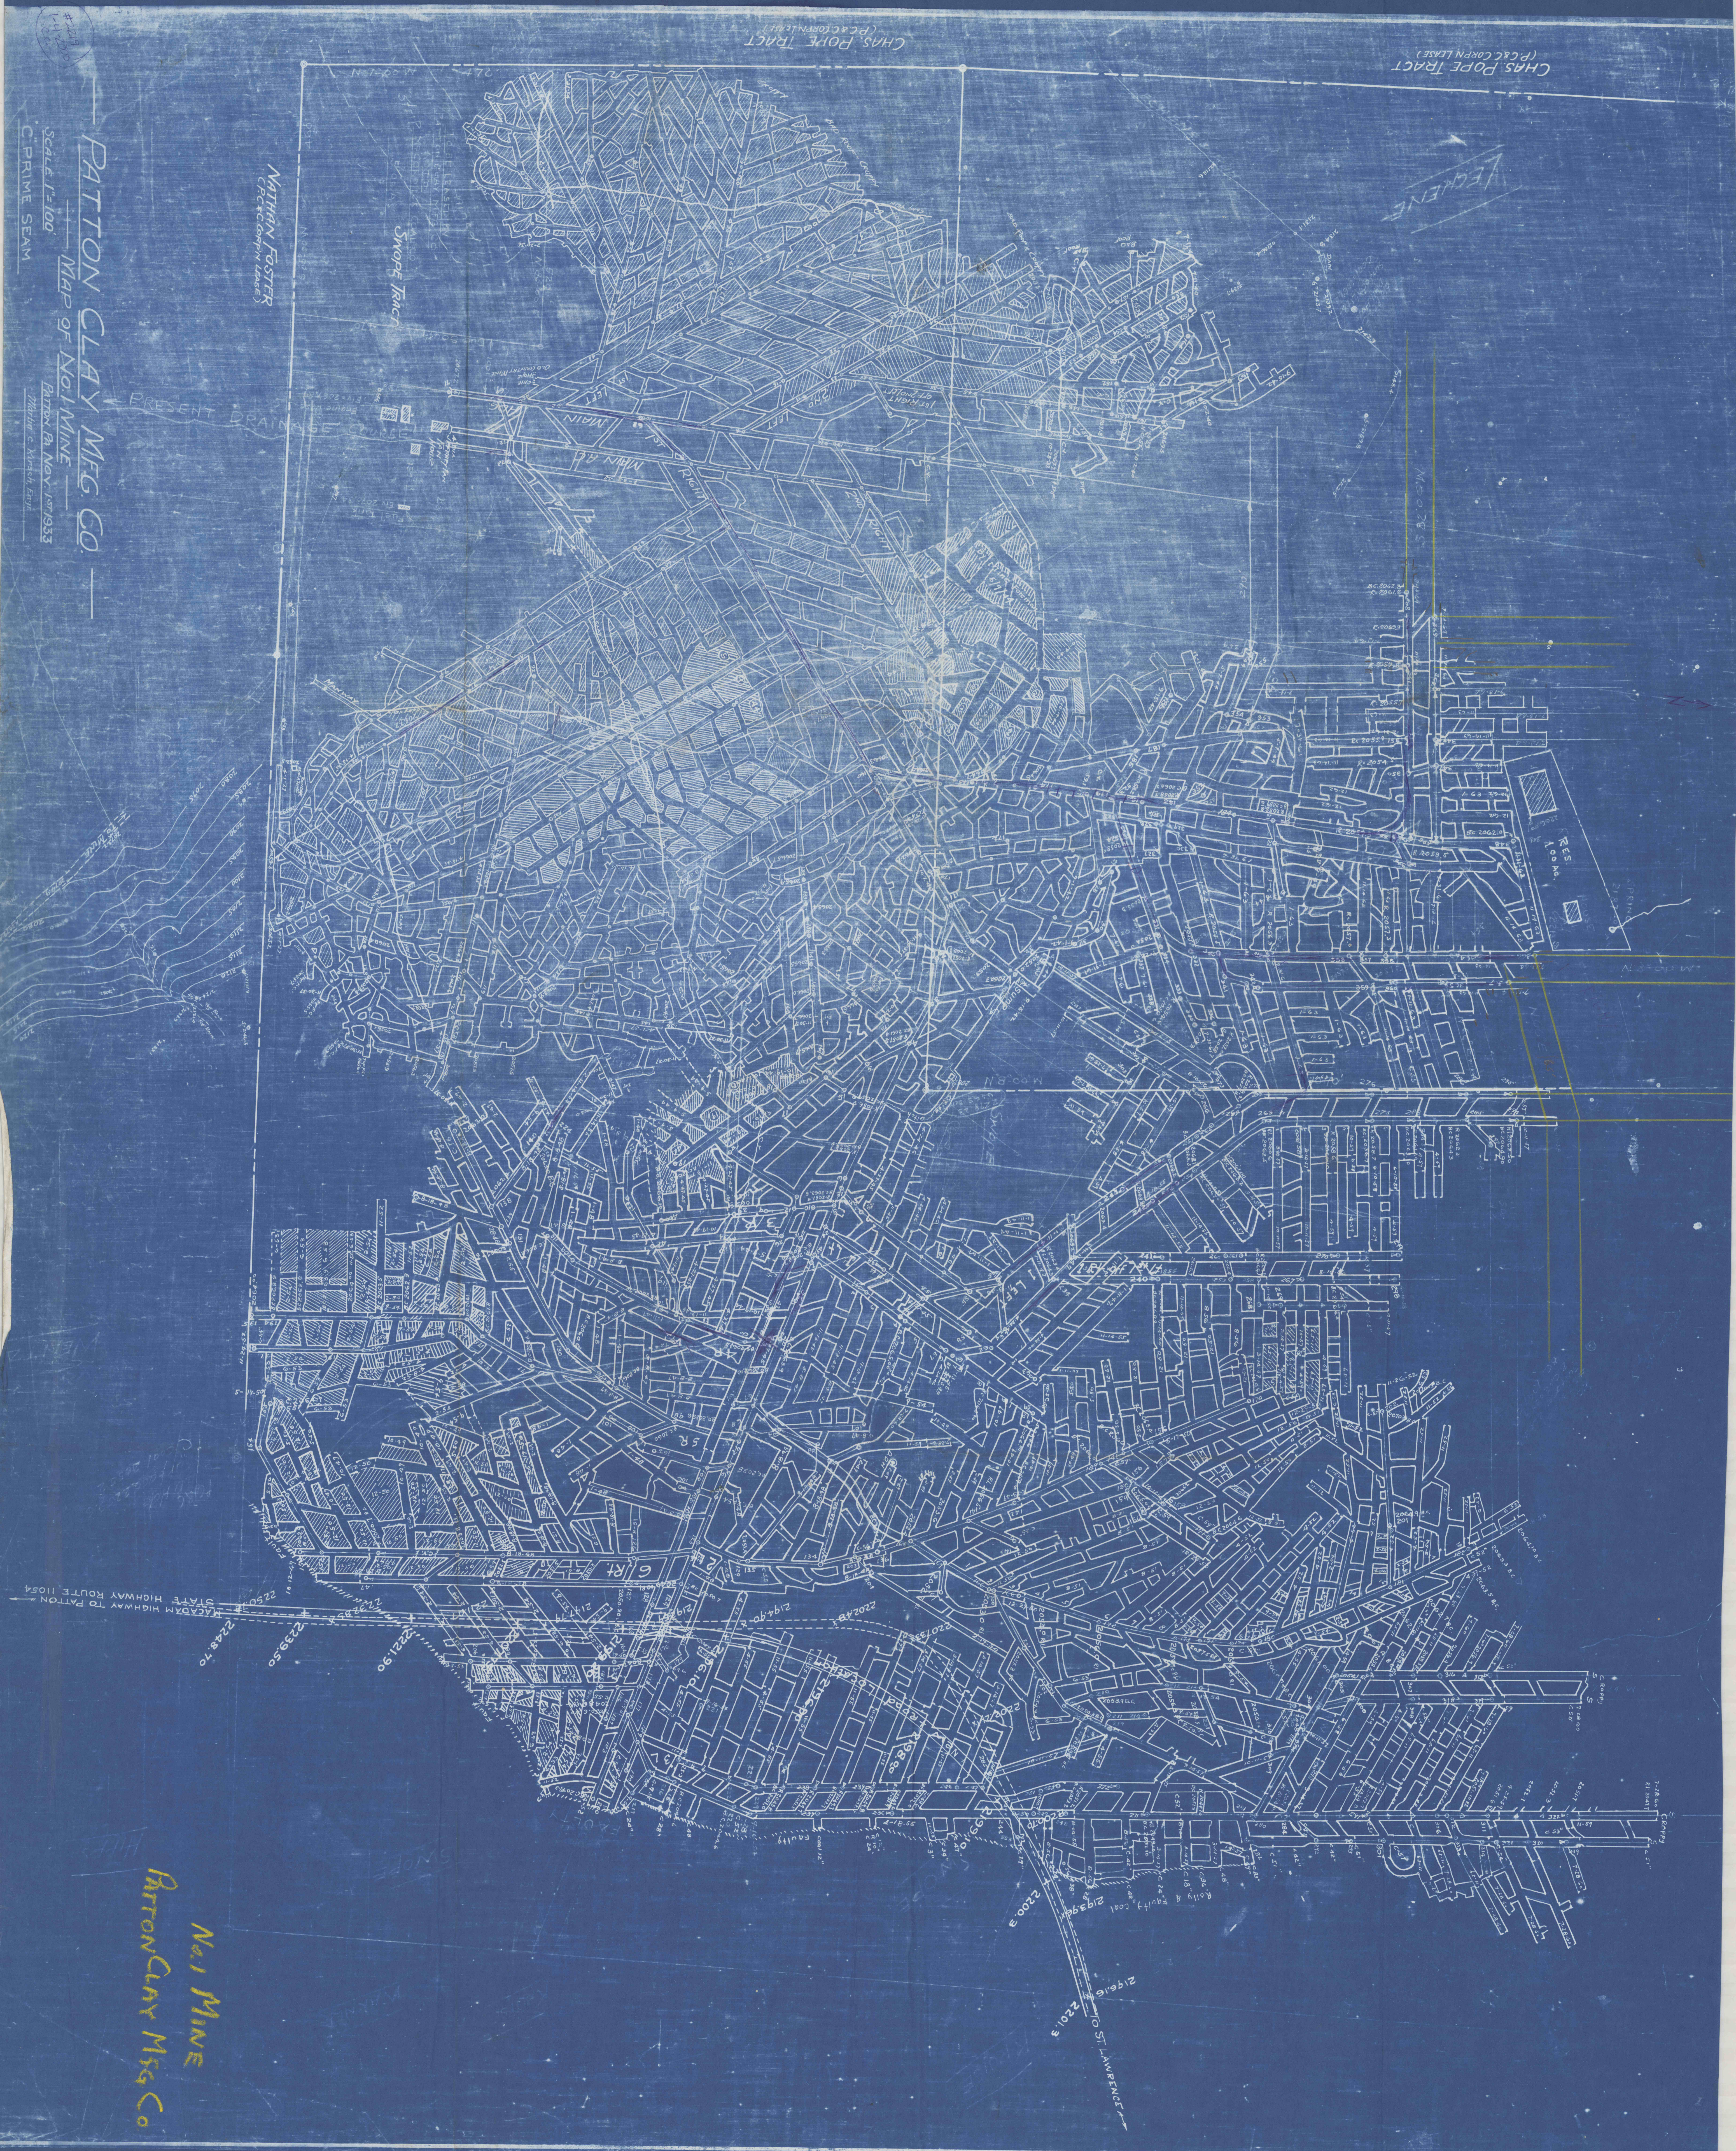

No. 1 MINE  
Patton Clay Mfg. Co.

MACADAM HIGHWAY TO PATTON  
STATE HIGHWAY ROUTE 11054  
2250.0  
2248.70  
2239.50  
2221.90  
2198.00

2196.0  
2200.3  
2199.0  
2201.3  
ST. LAWRENCE

RES. ROOM

M. 28 S.

M. 29 S.

6th St

7th St

Mason Run

1st Shaft




















































































