


M. PRINCIPINNI AND E. PRINCIPINNI  
OWNERS OF SURFACE AND COAL

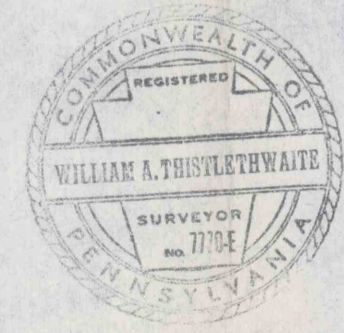

NOTE:  
THIS MAP PREPARED FROM BLUE PRINTS OF WHITELEY  
MINING CO. PRIOR OPERATOR. MINE ABANDONED MARCH 31, 1960.  
POSTED TO DATE FEB. 20, 1964 BY Charles H. Reed Feb. 20, 1964

2-20-70 William A. Thistlethwaite	"	"	SEPT. 17, 1964 BY Charles H. Reed
3-17-70 William A. Thistlethwaite	"	"	MAR. 9, 1965 BY Charles H. Reed
12-30-70 William A. Thistlethwaite	"	"	OCT. 23, 1965 BY Charles H. Reed
"	"	"	AUG. 3, 1966 BY William A. Thistlethwaite
"	"	"	FEB. 1, 1967 BY William A. Thistlethwaite
"	"	"	AUG. 1, 1967 BY William A. Thistlethwaite
"	"	"	JAN. 20, 1968 BY William A. Thistlethwaite
"	"	"	JULY 20, 1968 BY William A. Thistlethwaite
"	"	"	AUG. 20, 1969 BY William A. Thistlethwaite

R. AND S. MINE No 2  
R. AND S. COAL CO.  
DUNKARD TWP. GREENE, CO. PA.  
SCALE 1"=100 FT. DATE AUG. 15, 1963.  
M'CUNE & STOPINSKI OPERATOR  
CARMICHAELS, PENNA.

THIS MAP PREPARED BY Charles H. Reed BOBTOWN, PA. aug. 15, 1963

#0027  
1-6-2000  
CC