



FIELD COPY

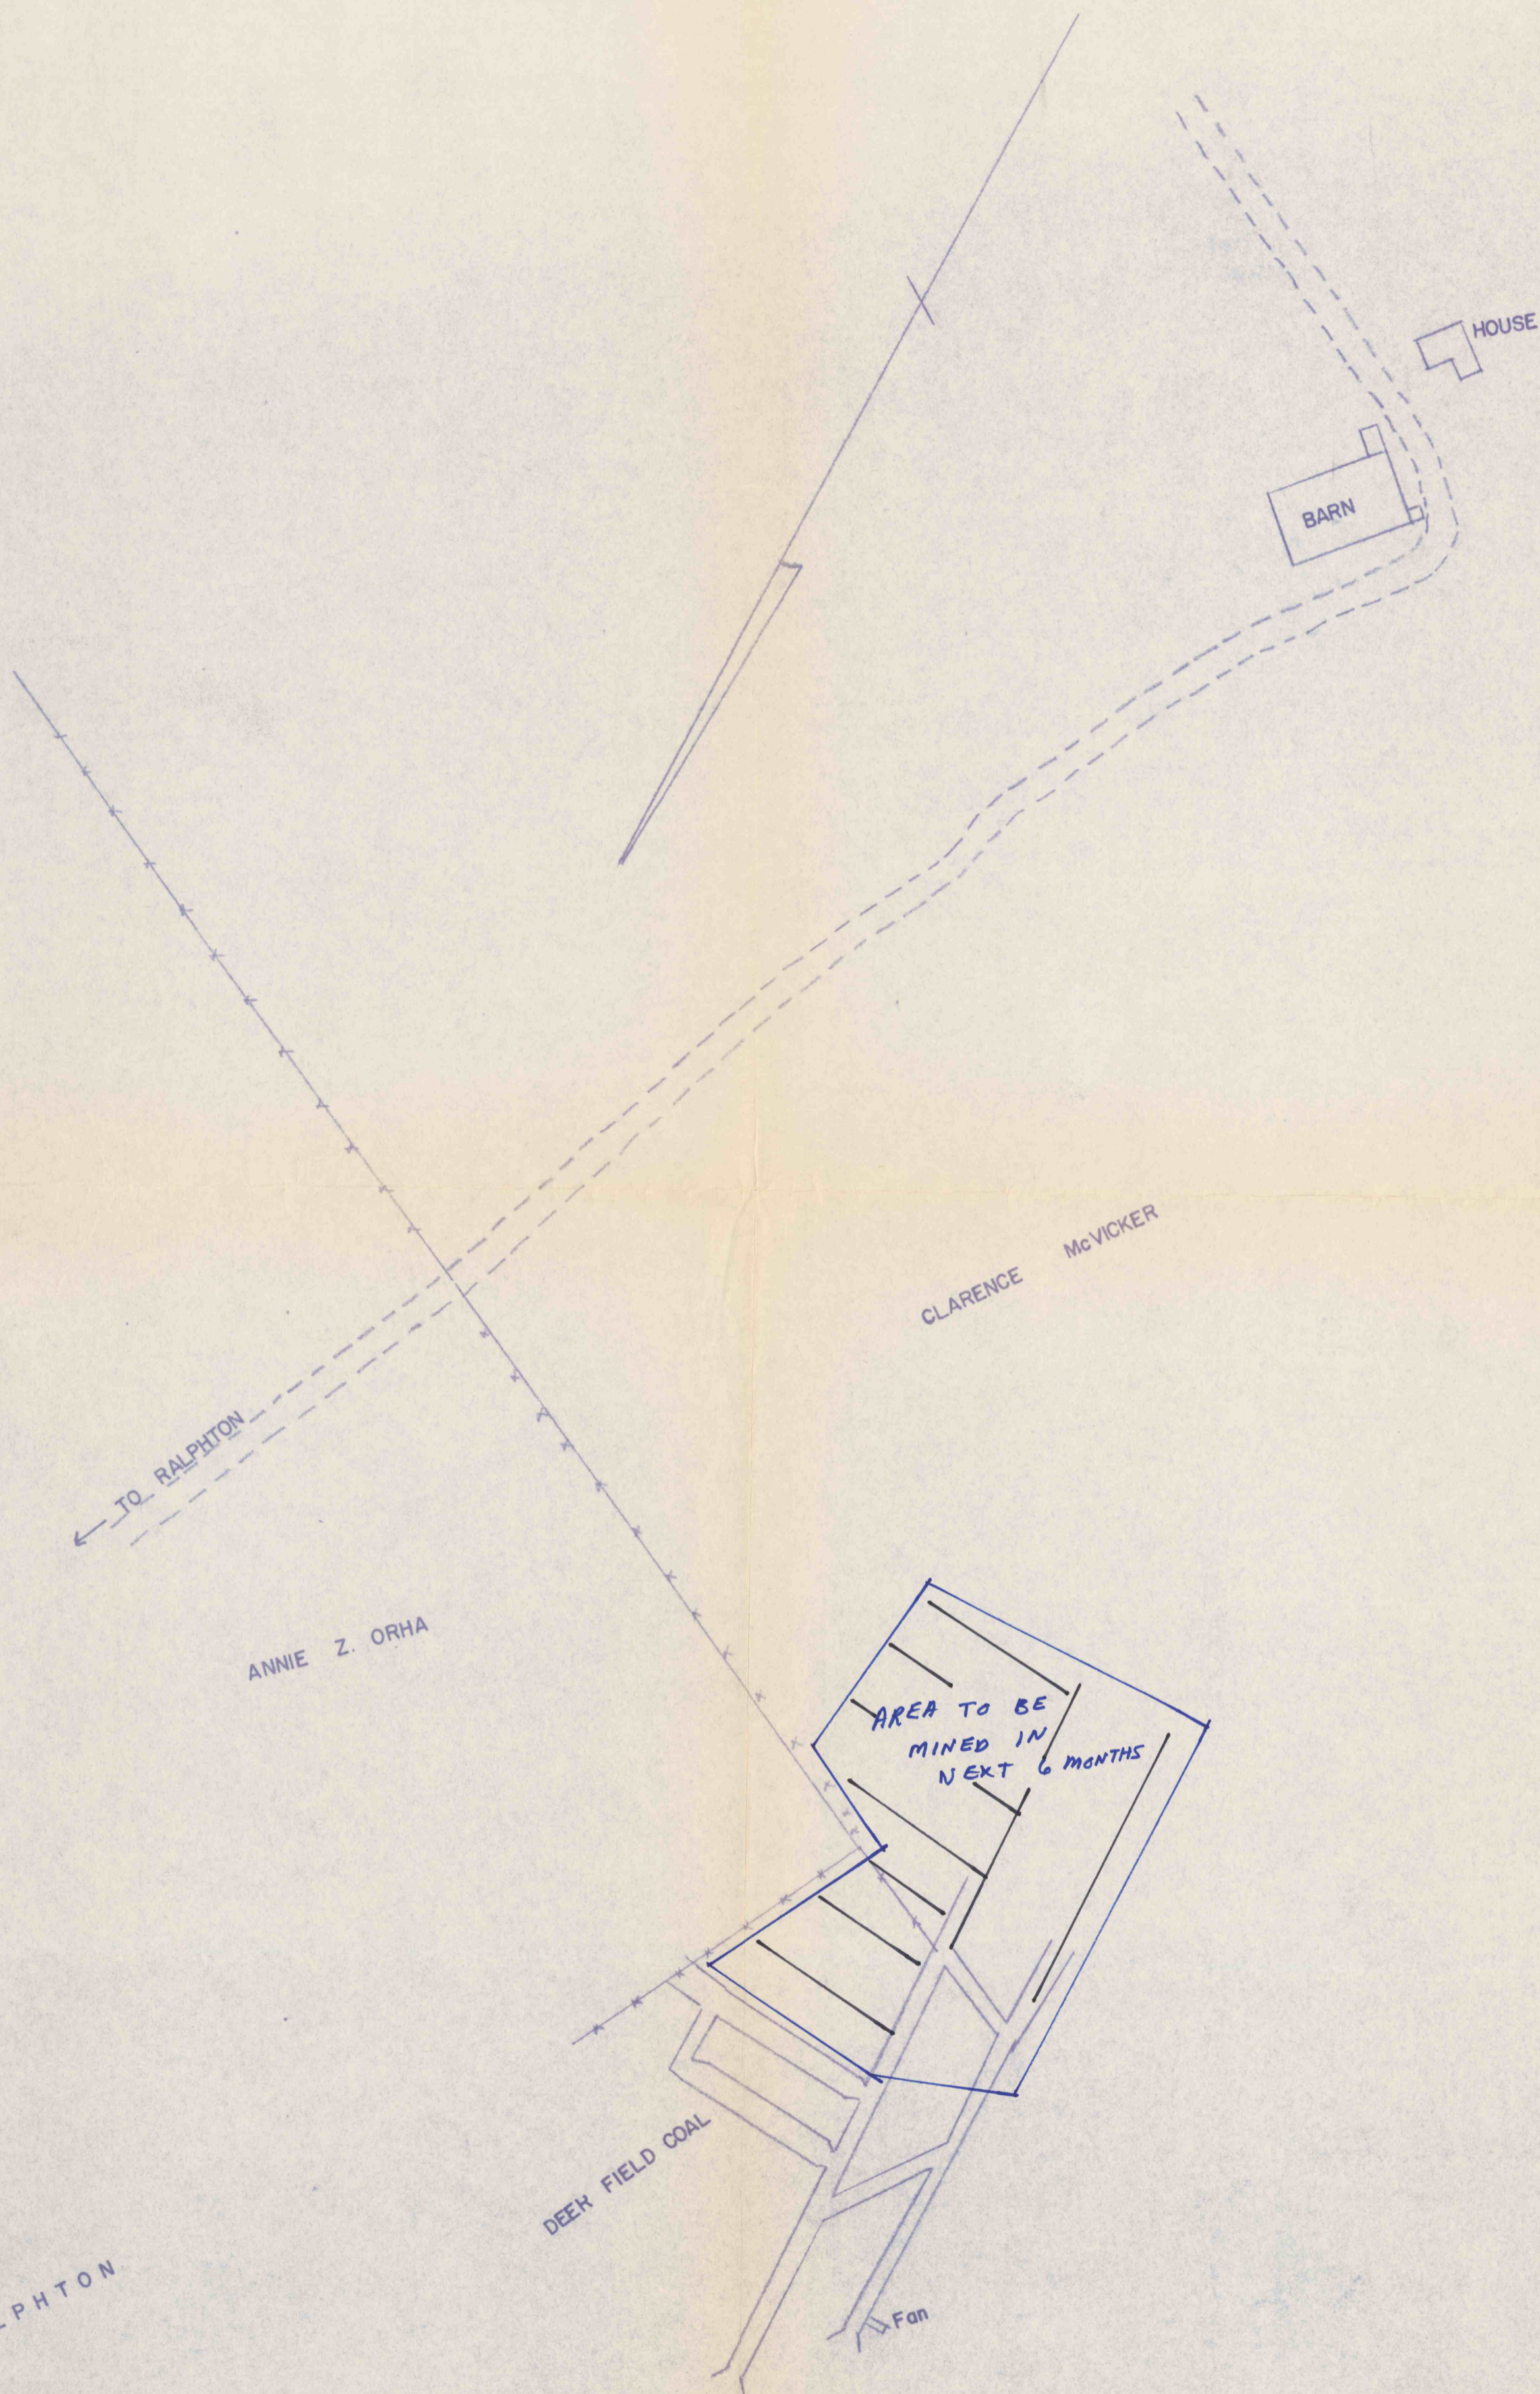

ELY & FRENCH

CARR MINING CO., - RALPHTON MINE - "E" SEAM
 QUEMAHONING TWP., SOMERSET CO., PENNSYLVANIA
 SCALE 1" = 100' MARCH 1, 1967

SURVEY & MAP BY CHARLES J. McLANEY, R.S. - TRACED BY ELY & FRENCH

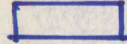 AREA TO BE MINED IN NEXT 6 MONTHS

#2238
 1-6-2000
 CC