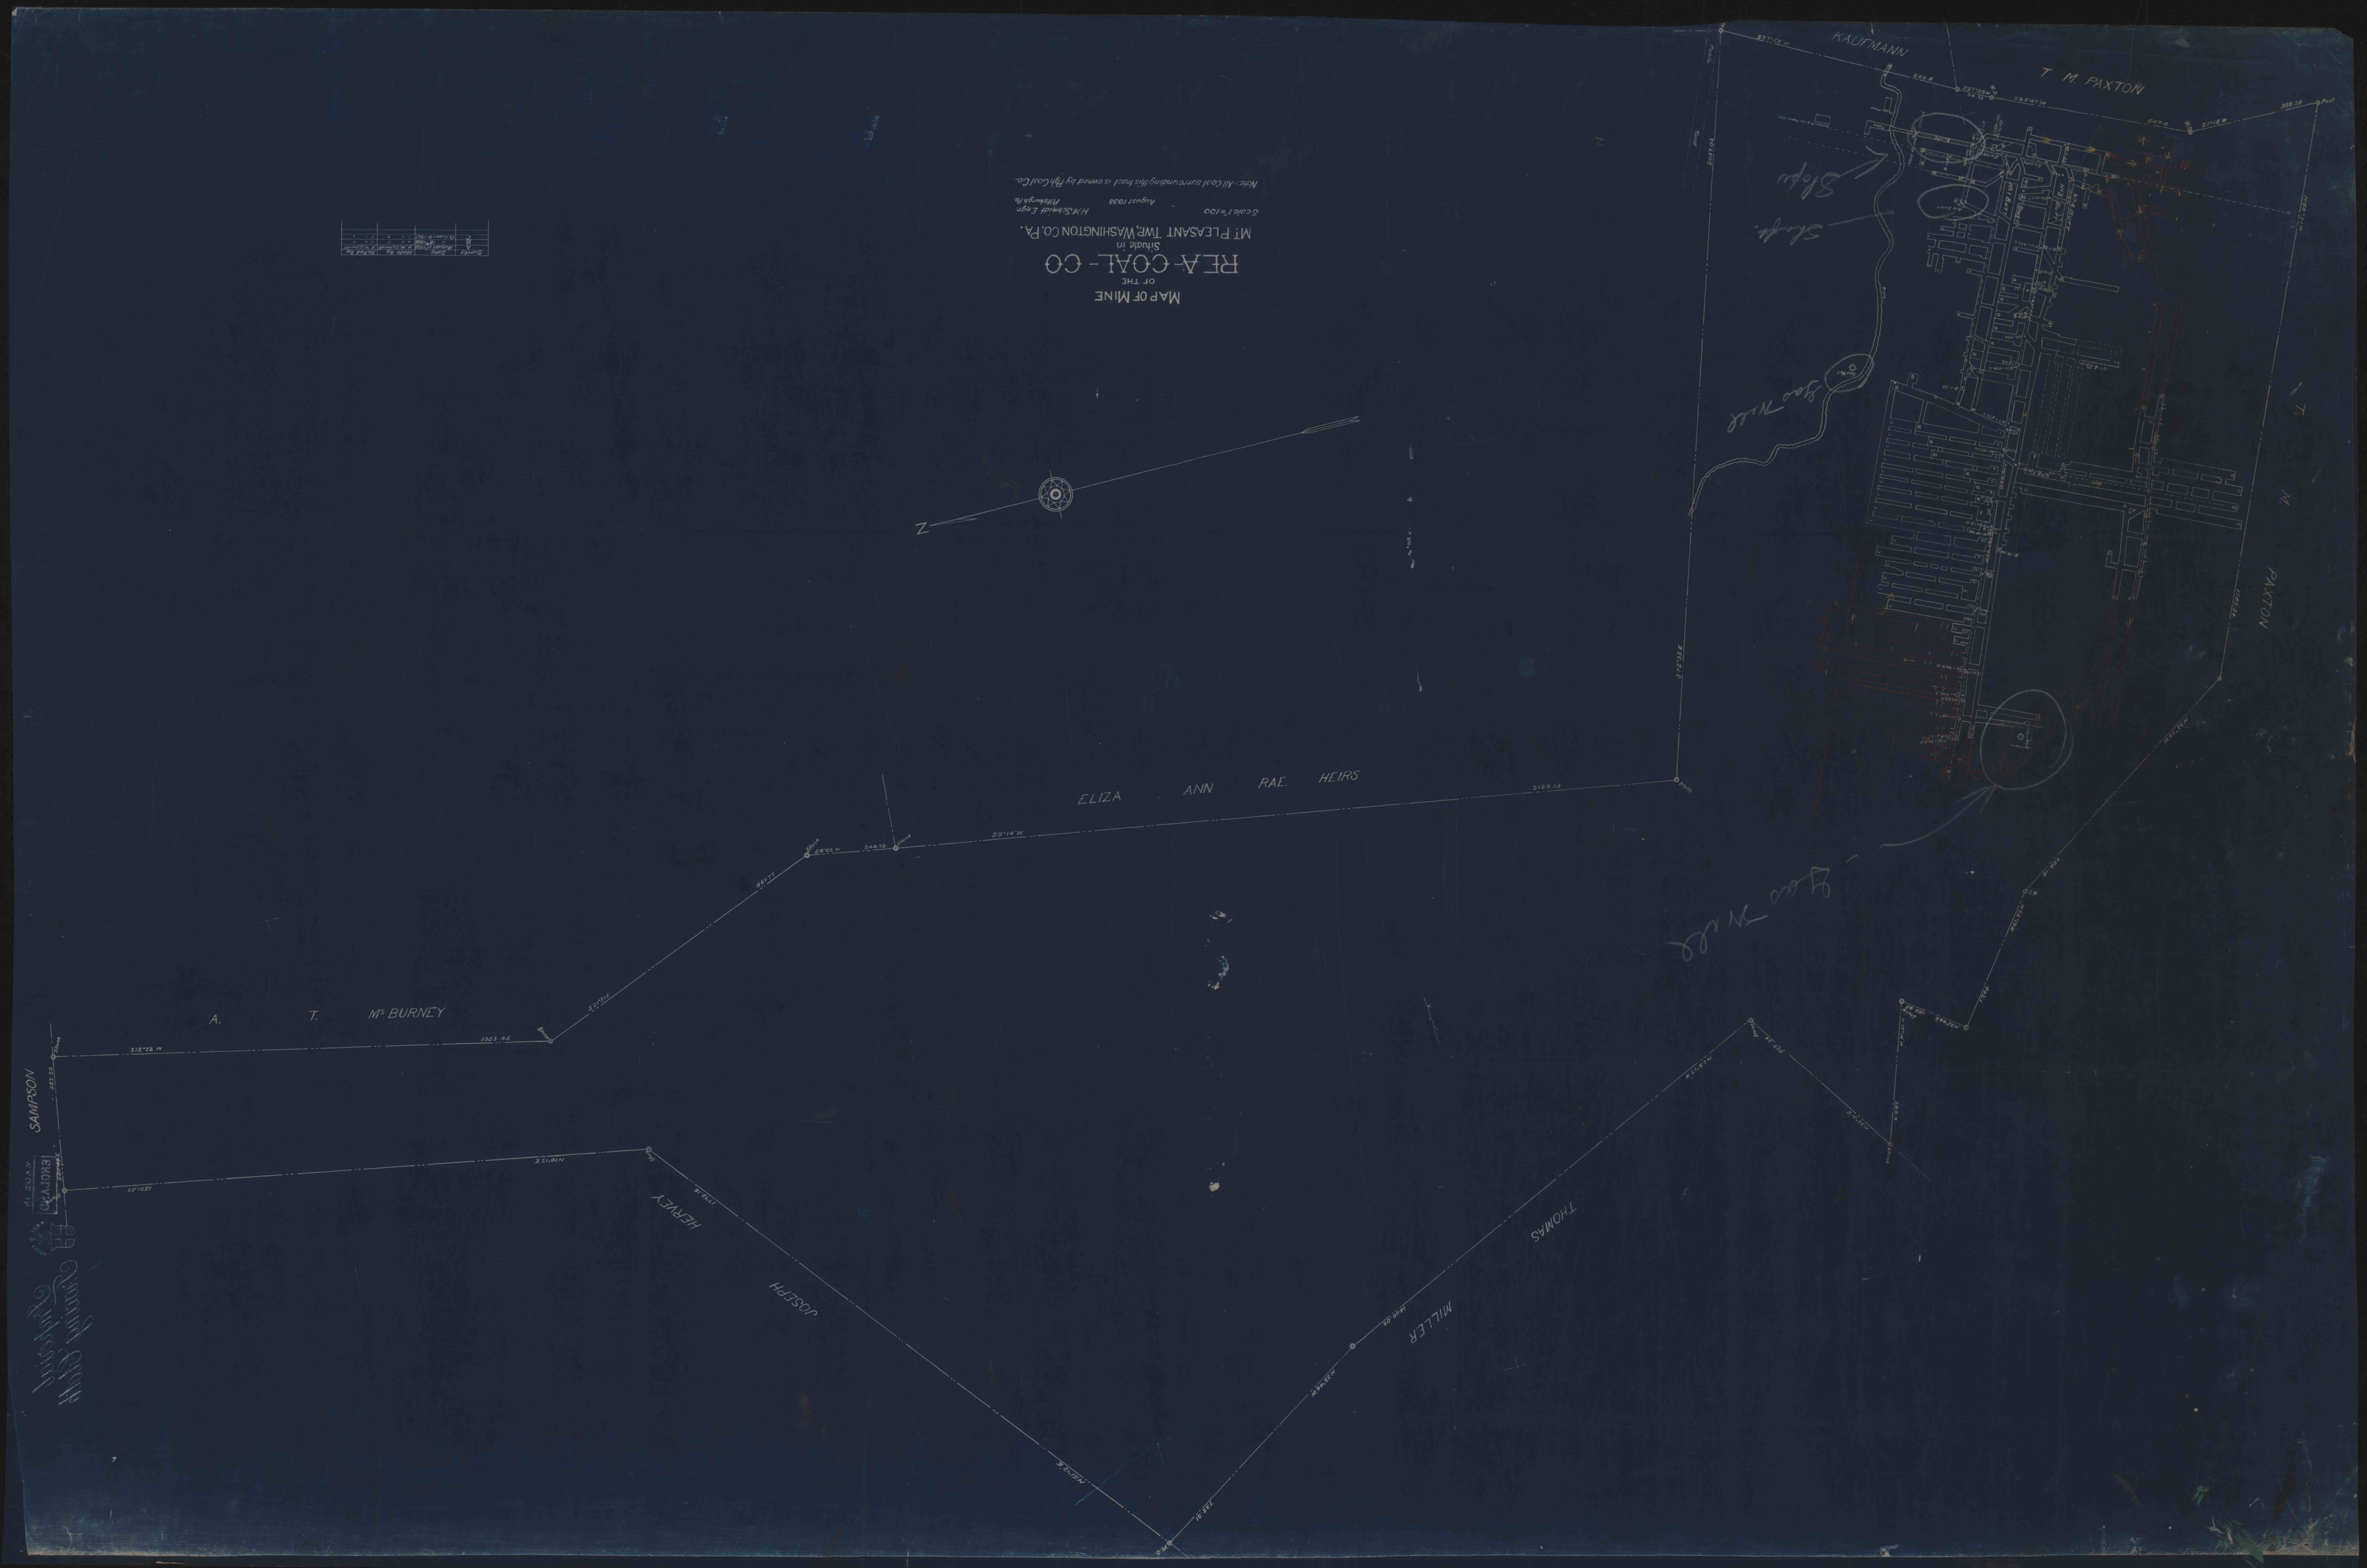
MAP OF MINE
OF THE
REA-COAL-CO
Situate in
Mt PLEASANT TWP, WASHINGTON CO, PA.
Scale 1"=100
August 1933
H.M.Schmidt Engr.
Pittsburgh Pa.
Note:- All coal surrounding this tract is owned by Pgh Coal Co.
KAUFMANN
T. M. PAXTON
T. M. PAXTON
ELIZA ANN RAE HEIRS
A. T. McBURNEY
SAMPSON
JOSEPH HERVEY
THOMAS MILLER
Slope
Slope
Gas Well
Gas Well