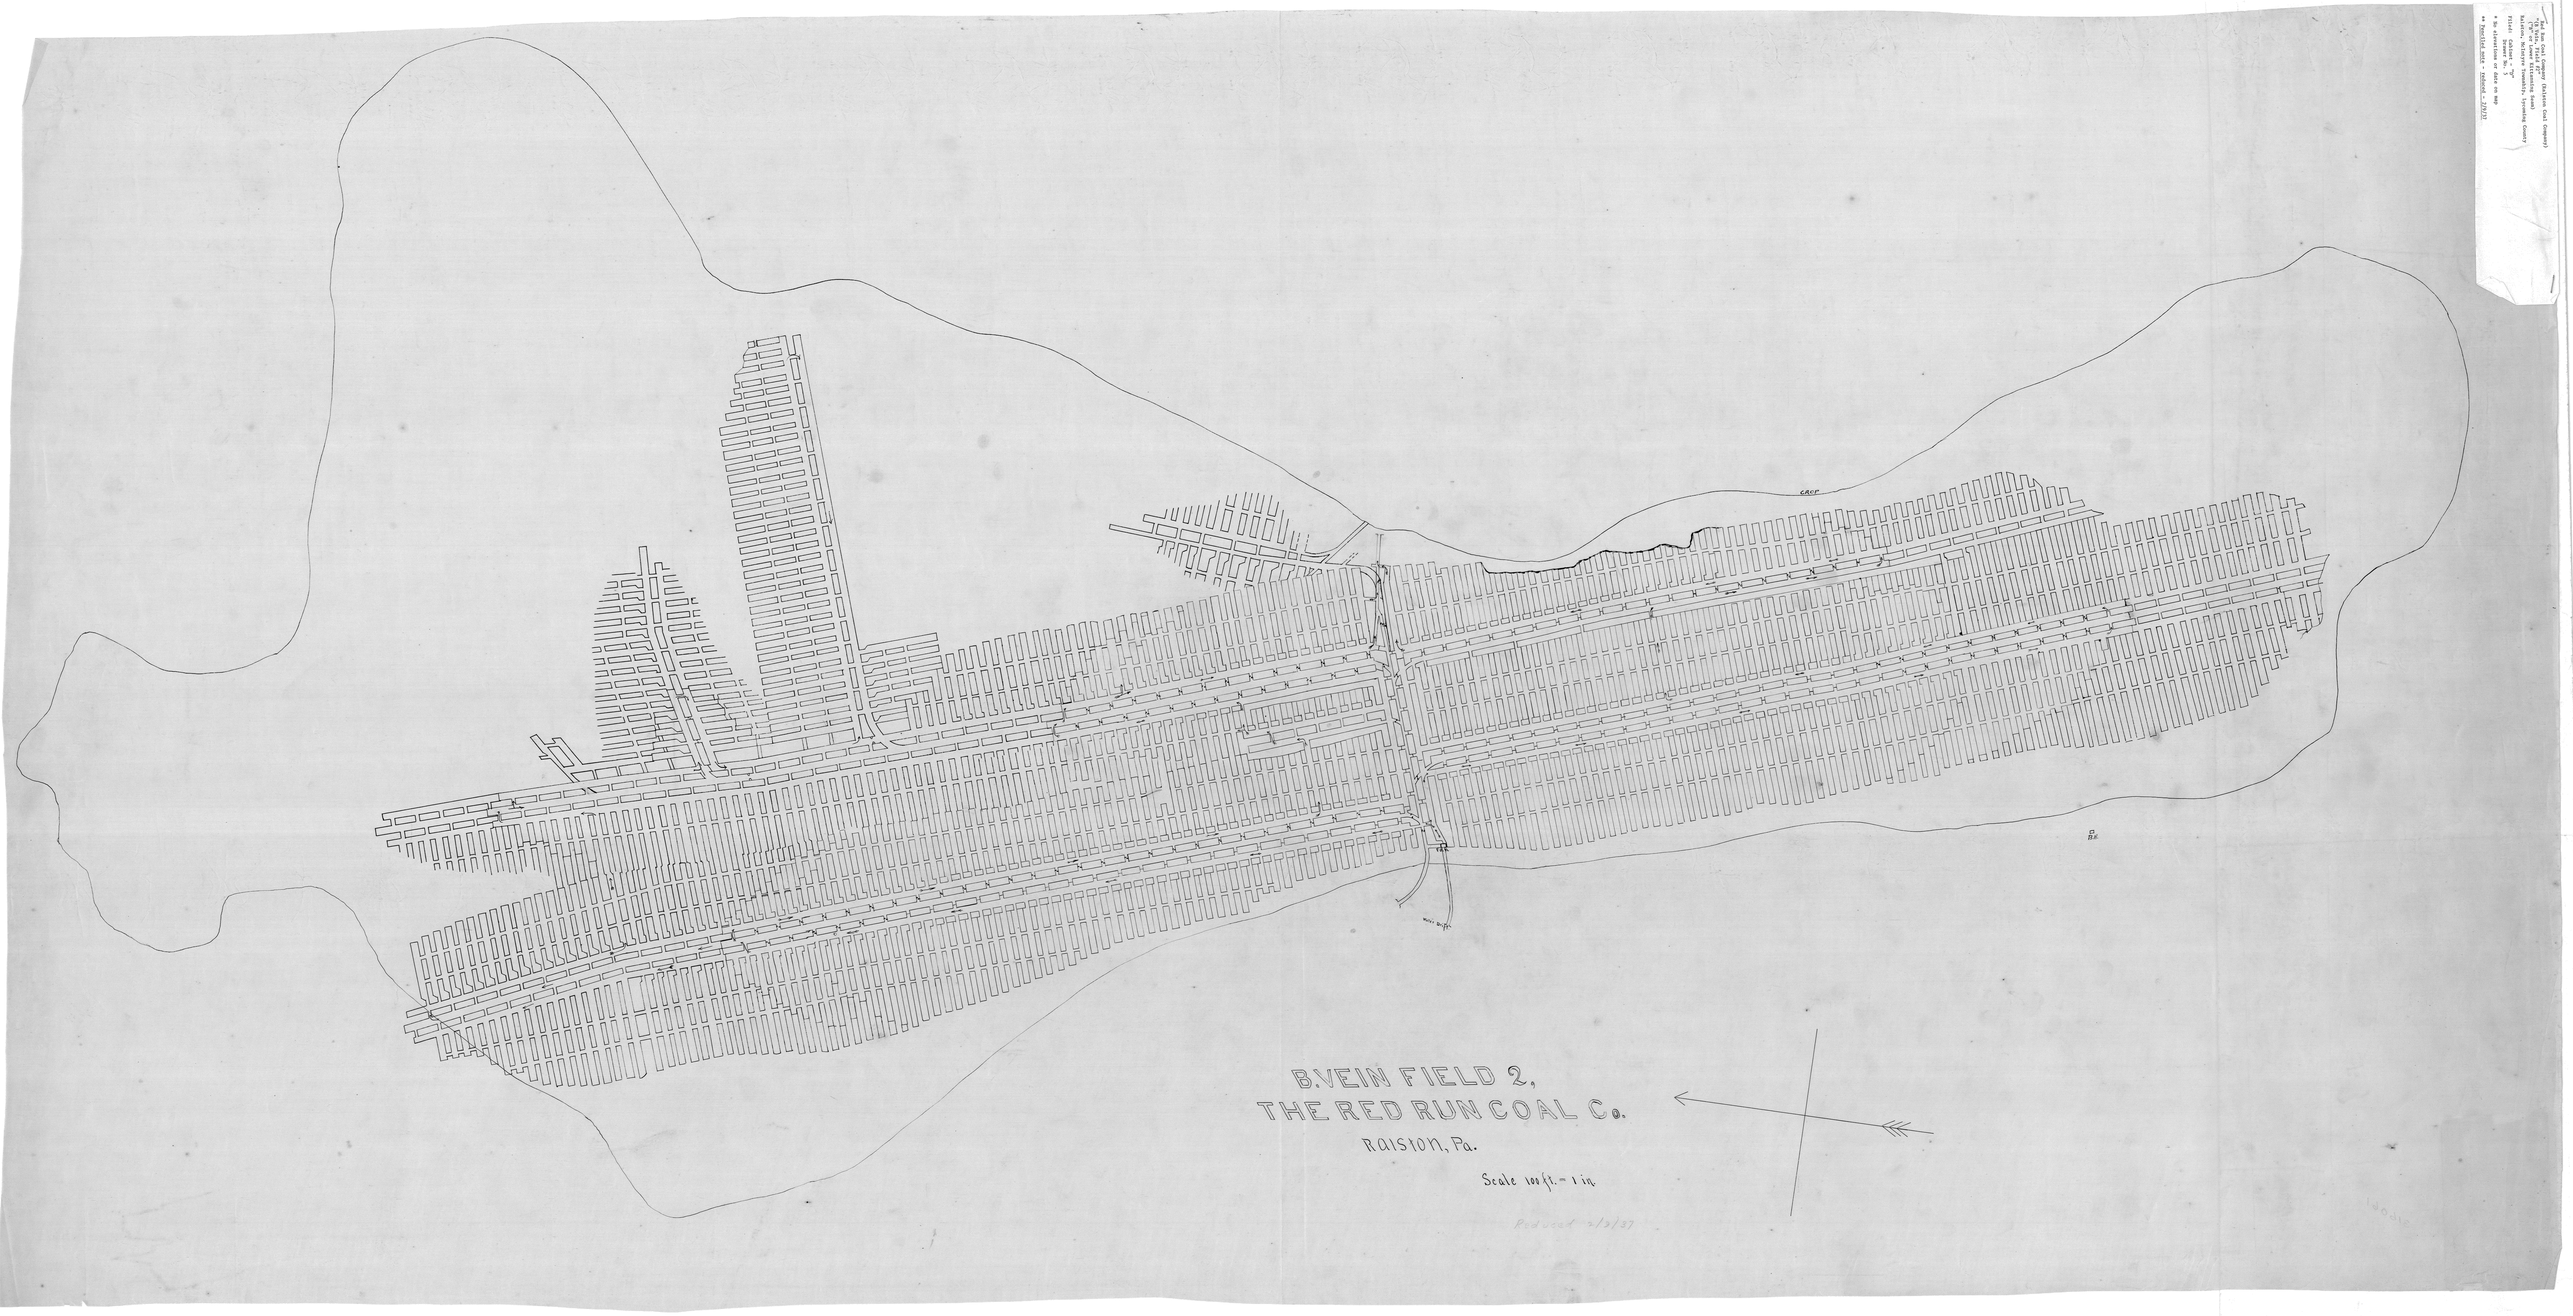
CROP
B.VEIN FIELD 2,
THE RED RUN COAL Co.
RAISTON, Pa.
Scale 100 ft. = 1 in.
Reduced 2/3/37