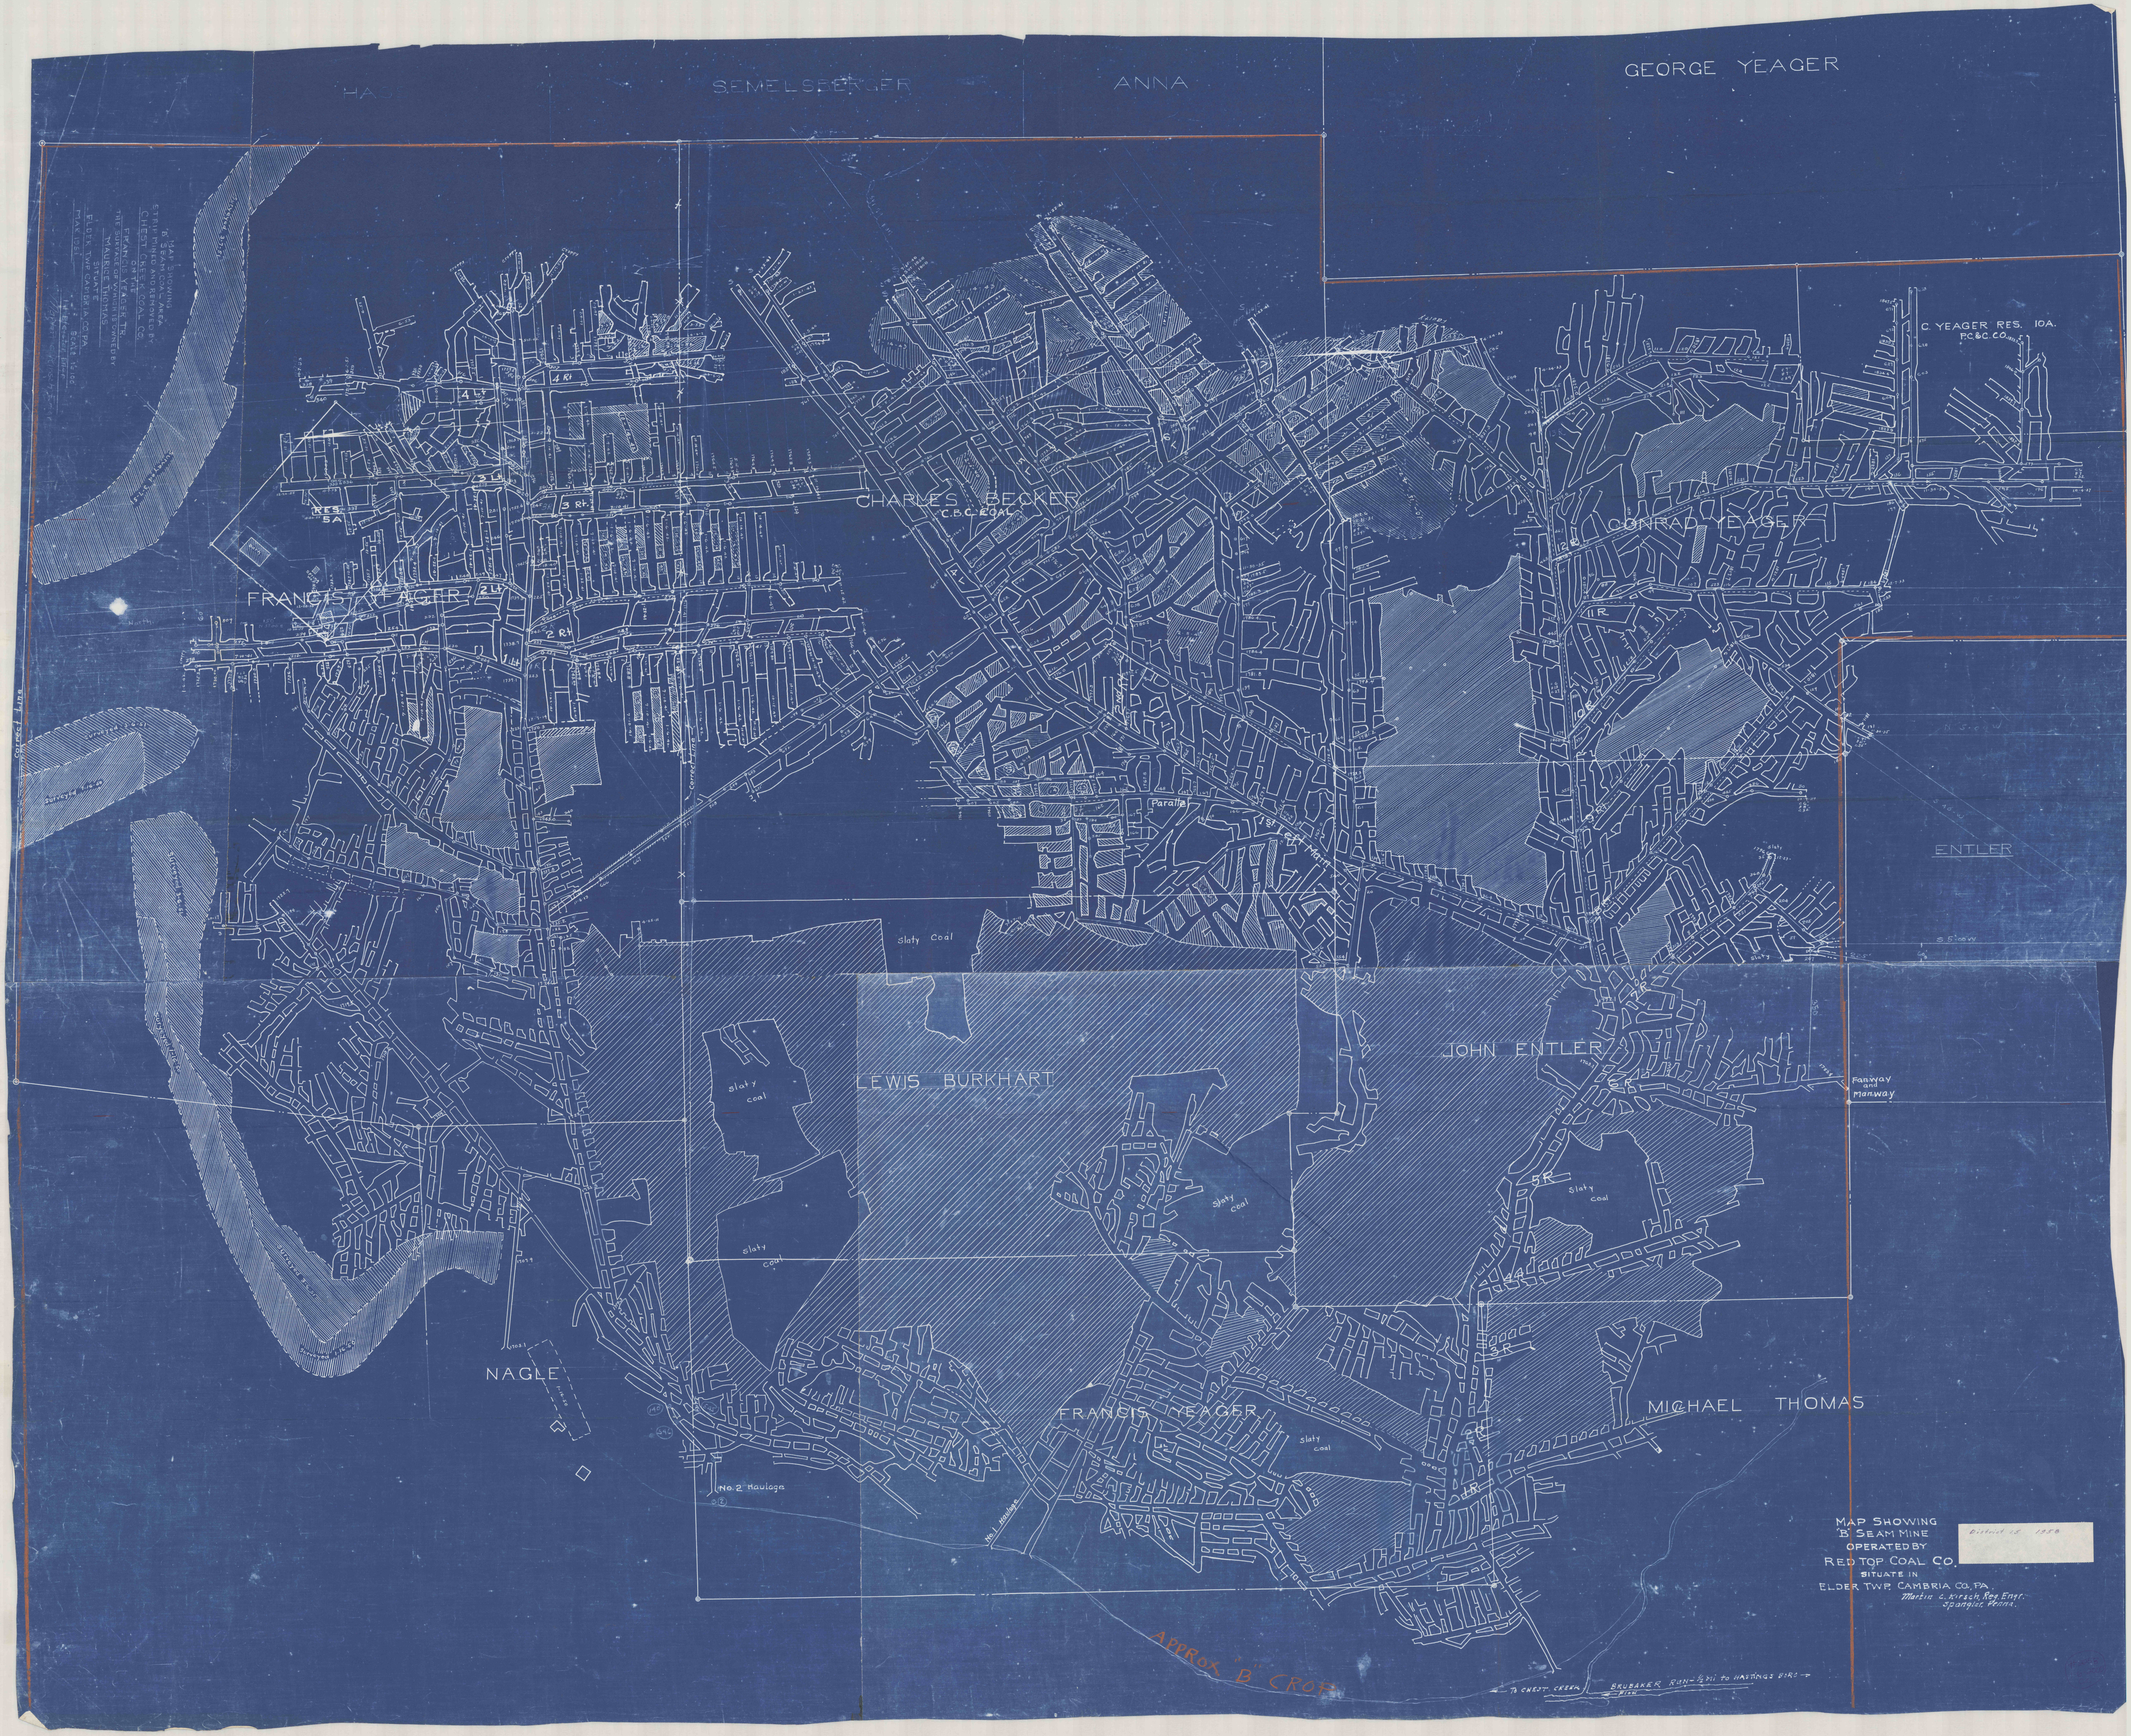

MAP SHOWING
"B" SEAM MINE
OPERATED BY
RED TOP COAL CO.
SITUATE IN
ELDER TWP. CAMBRIA CO. PA.
Martin C. Kirsch, Reg. Engr.
Spangler, Penna.

District 15 1958