


REDSTONE MINE

OF THE
UNITED STATES STEEL CORPORATION
 SOUTH UNION TWP. - FAYETTE CO. - PA.

DATUM OF LEVELS 16.1 FT. BELOW MEAN TIDE AT SANDY HOOK
 SCALE 1"=100'

DATE OF SURVEYS

11-6-1893	A	1-24-1900	A-1	2-25-1907	A-2	8-15-1913	A-3	1-7	
1-3-1894	B	10-25-1900	B-1	5-25-1907	B-2	11-11-1913	B-3	J-2	
4-10-1894	C	1-31-1901	C-1	8-25-1907	C-2	2-9-1914	D-3	J-2	
10-24-1894	D	5-1-1901	D-1	11-6-1907	D-2	5-18-1914	D-3	J-2	
2-29-1894	E	8-22-1901	E-1	2-20-1908	E-2	7-5	8-18-1914	E-3	J-2
4-8-1895	F	12-10-1901	F-1	5-19-1908	F-2	7-5	1-11-1914	F-3	J-2
7-18-1895	G	2-11-1902	G-1	8-19-1908	G-2	B.H.	5-21-1915	G-3	T-8
10-16-1895	H	5-12-1902	H-1	11-19-1908	H-2	T.S.	6-5-1915	H-3	T-8
1-5-1896	I	8-25-1902	I-1	5-19-1909	I-2	T.S.	11-24-1915	I-3	A-5
7-3-1896	J	2-19-1903	J-1	8-19-1909	J-2	J.T.	11-24-1915	J-3	A-5
11-11-1896	K	5-12-1903	K-1	11-19-1909	K-2	T.S.	5-24-1917	K-3	A-5
1-15-1897	L	8-10-1903	L-1	11-19-1909	L-2	W.S.	11-27-1917	L-3	R-4
4-24-1897	M			2-19-1910	M-1	A.S.	6-5-1918	M-3	R-4
7-3-1897	O	5-19-1904	P-1	5-30-1910	N-2	A.S.	11-26-1918	N-3	R-4
10-16-1897	P	8-19-1904	Q-1	8-17-1910	O-2	A.S.	5-28-1919	O-3	A-5
3-31-1897	Q	11-22-1904	R-1	2-17-1911	P-2	A.S.	11-24-1919	P-3	A-5
7-6-1898	R	3-11-1905	S-1	5-19-1911	R-2	A.S.	6-1-1920	Q-3	V-H
9-29-1898	S	5-17-1905	T-1	8-18-1911	S-2	T.S.	11-23-1920	R-3	A-5
12-16-1898	T	8-18-1905	U-1	1-26-1911	T-2	A.S.	6-6-1921	S-3	R-H
5-17-1899	U	12-12-1905	V-1	5-16-1912	U-2	T.S.	11-21-1921	T-3	R-H
7-11-1899	V	3-14-1906	W-1	8-17-1912	V-2	A.S.	5-21-1924	V-3	R-H
11-18-1899	W	6-19-1906	X-1	11-19-1912	W-2	A.S.	5-19-1925	W-3	R-H
11-18-1900	X	9-26-1906	Y-1	2-18-1913	X-2	A.S.	5-8-1926	X-3	W-5
4-24-1900	Y	2-19-1906	Z-1	5-16-1913	Y-2	A.S.	11-11-1926	Y-3	W-5
	Z				Z-1	J-2	5-11-1927	Z-3	R-H

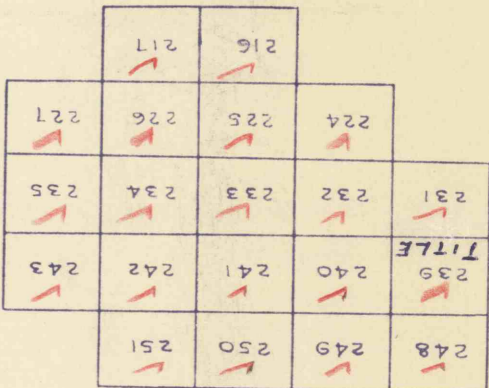

20 SHEETS - FIT THUS