


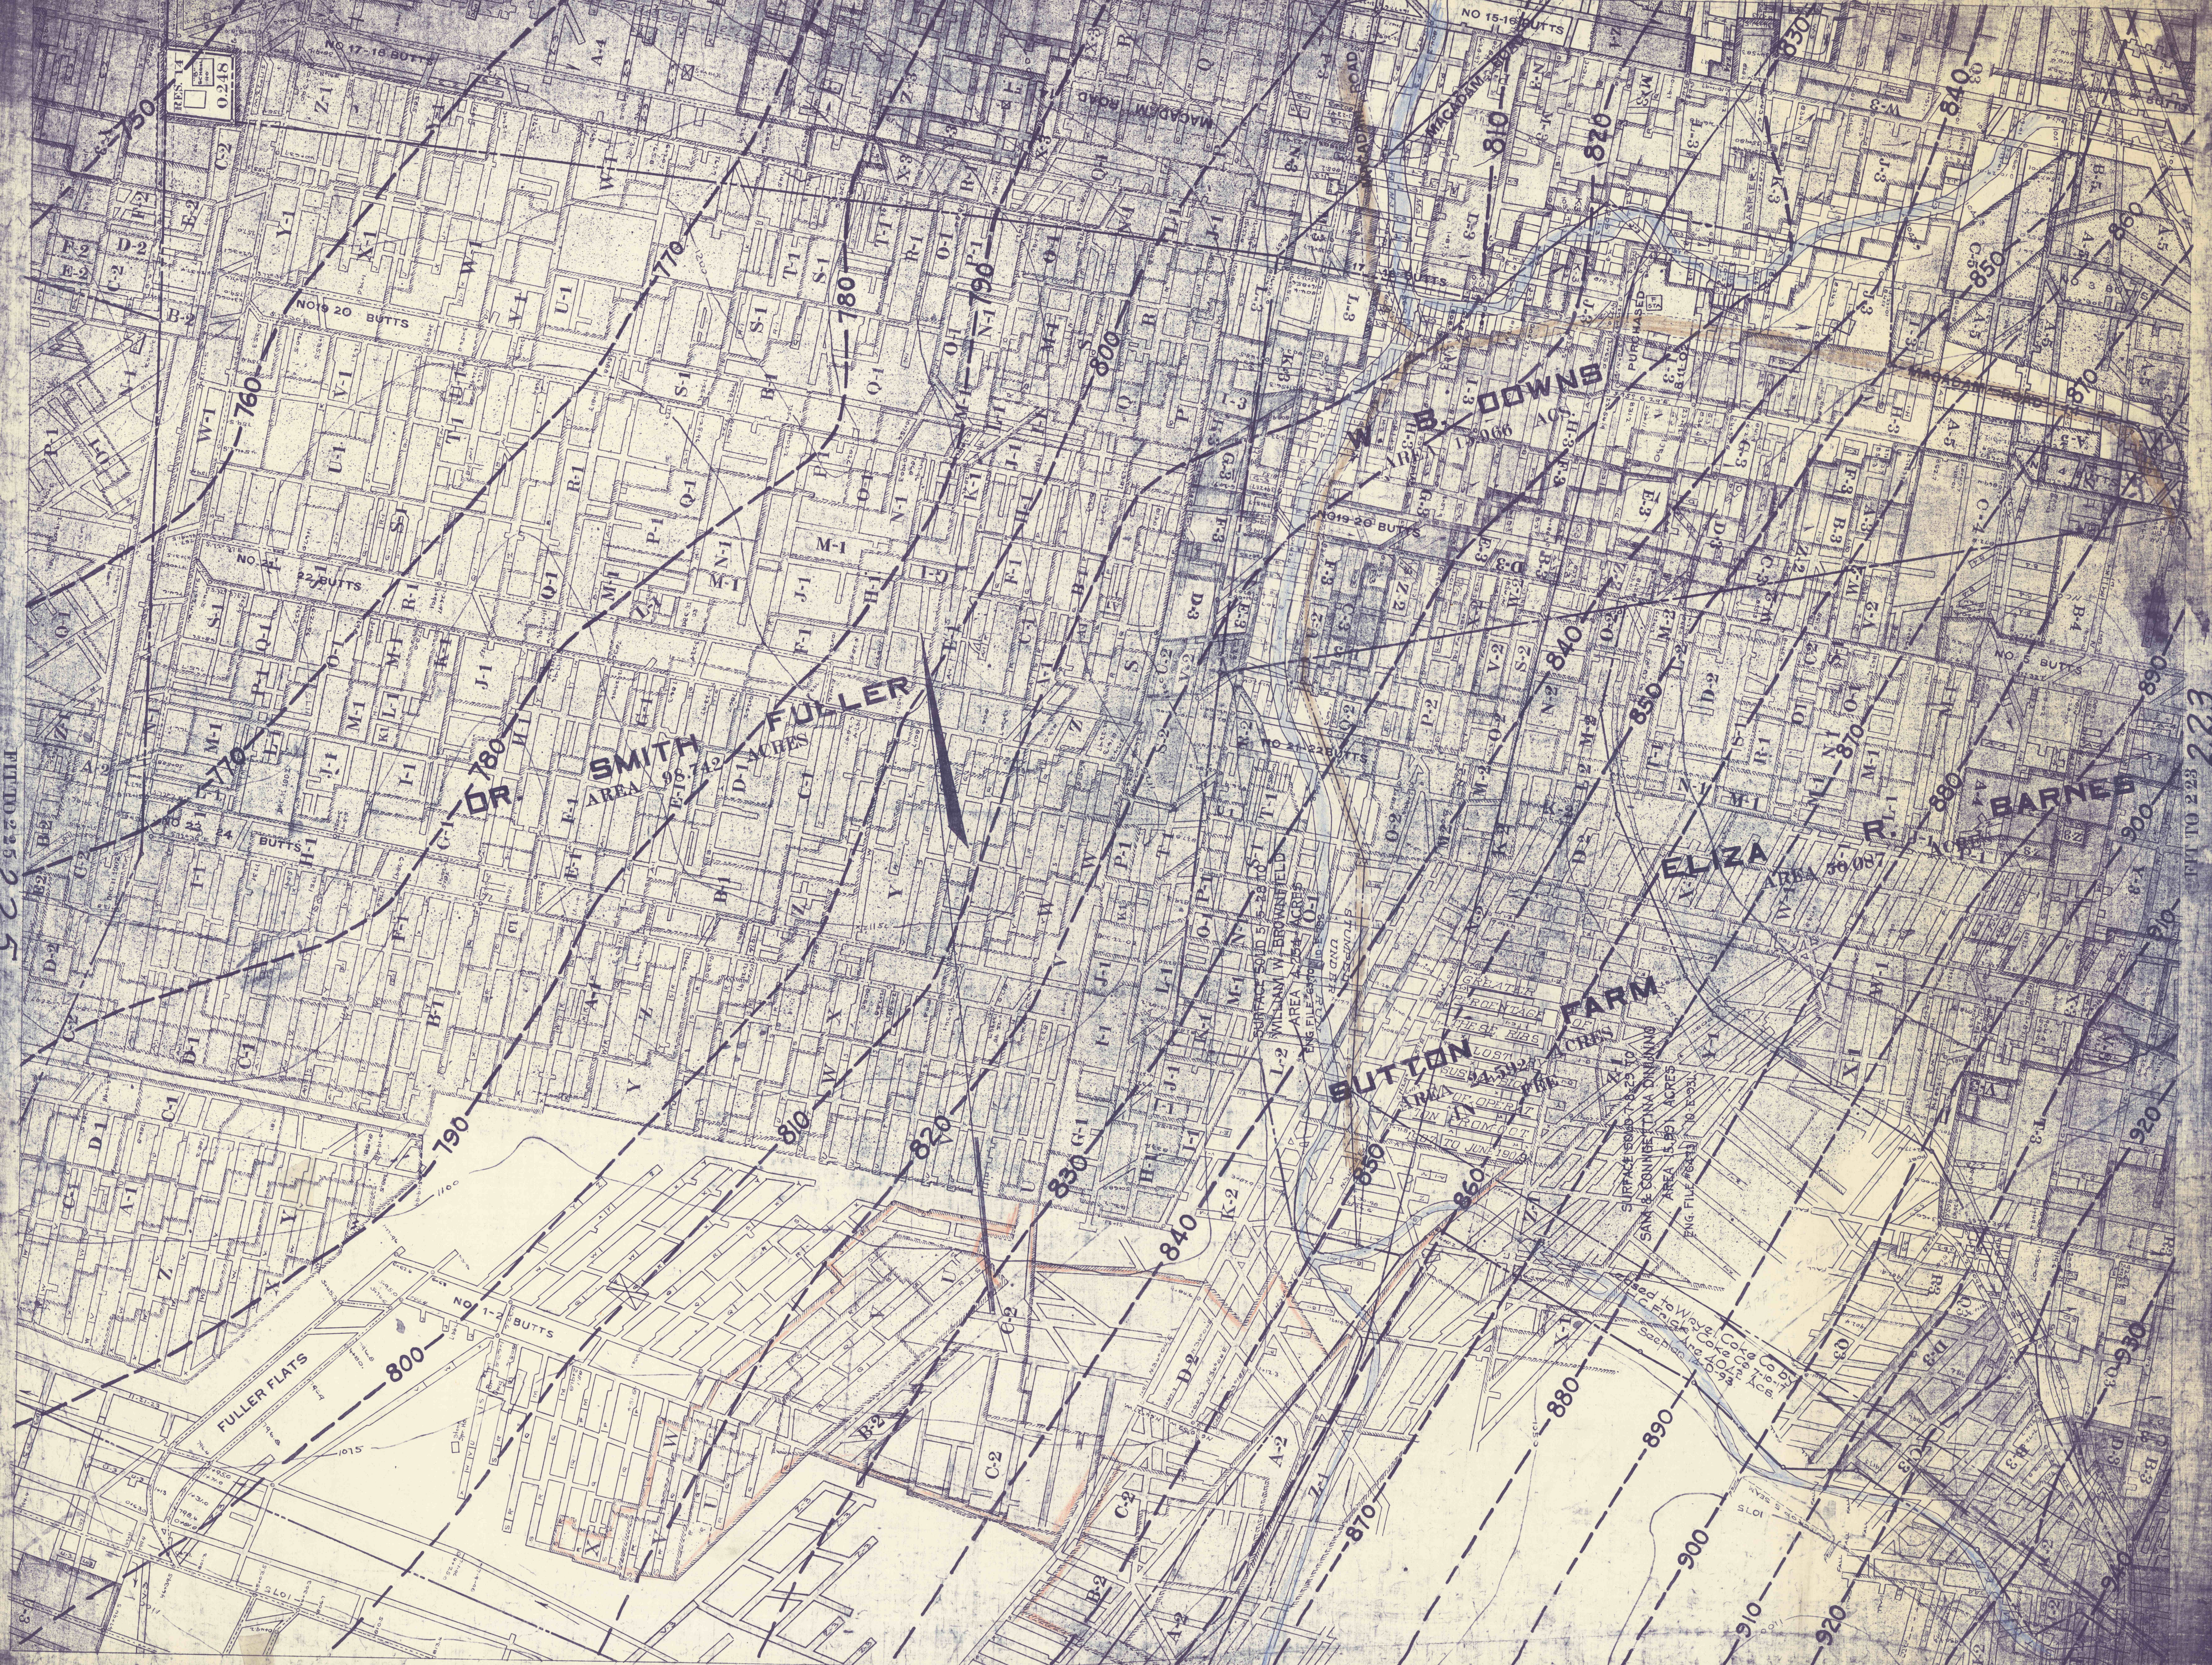

225

222