




SURVEY DATA

A	MAY 3, 1970
B	MAY 10, 1970
C	JUNE 5, 1970
D	JUNE 18, 1970
E	JULY 16, 1970
F	AUG. 10, 1970
G	AUG. 25, 1970
H	SEPT. 10, 1970
I	SEPT. 28, 1970
J	SEPT. 30, 1970
K	NOV. 19, 1970
L	MAY 27, 1971
M	MAY 16, 1971
N	JAN. 16, 1971
O	JAN. 29, 1971
P	FEB. 16, 1971
Q	MAR. 6, 1971
R	MAR. 26, 1971
S	MAY 20, 1971
T	JUNE 8, 1971
U	JULY 20, 1971
V	JULY 23, 1971
W	AUG. 12, 1971
X	AUG. 31, 1971
Y	SEPT. 15, 1971



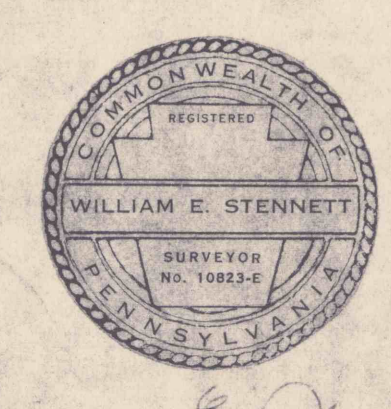

COAL MINE MAP
REEDDALE MINE No. 3
 PROJECT
REEDDALE MINING, INC.
 2011 A. S. REEDDALE RD. WASHINGTON & DUNESBORO TOWNSHIPS, WASHINGTON COUNTY, PENN.
 LOCATION
R. B. SHANNON & ASSOCIATES INC., KITTANNING, PA.
 DRAWN BY W.E.S. CHECKED BY D.J.S. DATE MAY 1970
 SCALE 1 INCH = 100 FEET DRAWING NO. ME. 72