

72  
10000-01-1  
10000-01-1





**SURVEY DATA**

A	MAY 5, 1970
B	MAY 10, 1970
C	JUNE 5, 1970
D	JUNE 18, 1970
E	JULY 22, 1970
F	AUG 10, 1970
G	AUG 25, 1970
H	SEPT 10, 1970
I	SEPT 22, 1970
J	OCT 30, 1970
K	NOV 19, 1970
L	NOV 27, 1970
M	DEC 16, 1970
N	JAN 14, 1971
O	FEB 18, 1971
P	FEB 24, 1971
Q	MAR 5, 1971
R	MAR 24, 1971
S	MAY 20, 1971
T	JUNE 8, 1971
U	JULY 20, 1971
V	JULY 23, 1971
W	AUG 12, 1971
X	AUG 31, 1971
Y	SEPT 15, 1971
Z	SEPT 15, 1971

**BEEZEDALE**


Surveyor

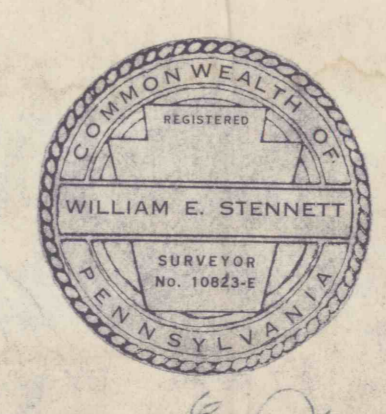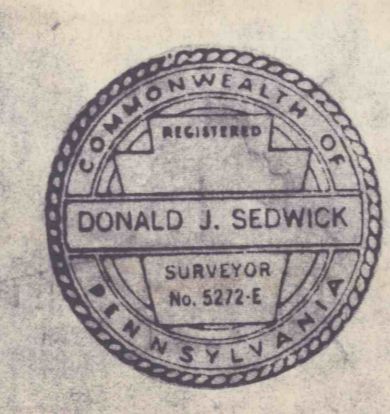

PROJECT	COAL MINE MAP BEEZEDALE MINE No. 3			
FOR	BEEZEDALE MINING, INC. E. D. 31 A. S. 101 AND 101A 101B 101C			
	R. B. SHANNON & ASSOCIATES INC., KITTANNING, PA.			
DRAWN BY	W.E.S.	CHECKED BY	D.J.S.	
DATE	MAY 1970			
SCALE	1 INCH = 100 FEET		DRAWING NO.	M.E. 72