


NE JOHNSON
932

PERMANENT STATIONS
3196 - S. 765.18 W. 20,915.89
3197 - S. 762.21 W. 20,954.78

FAN DATA
DIFFERENTIAL
440V 27AMP
40HP 5 DUCT
1300RPM
FIXED POSITION
W.C. 1.2"

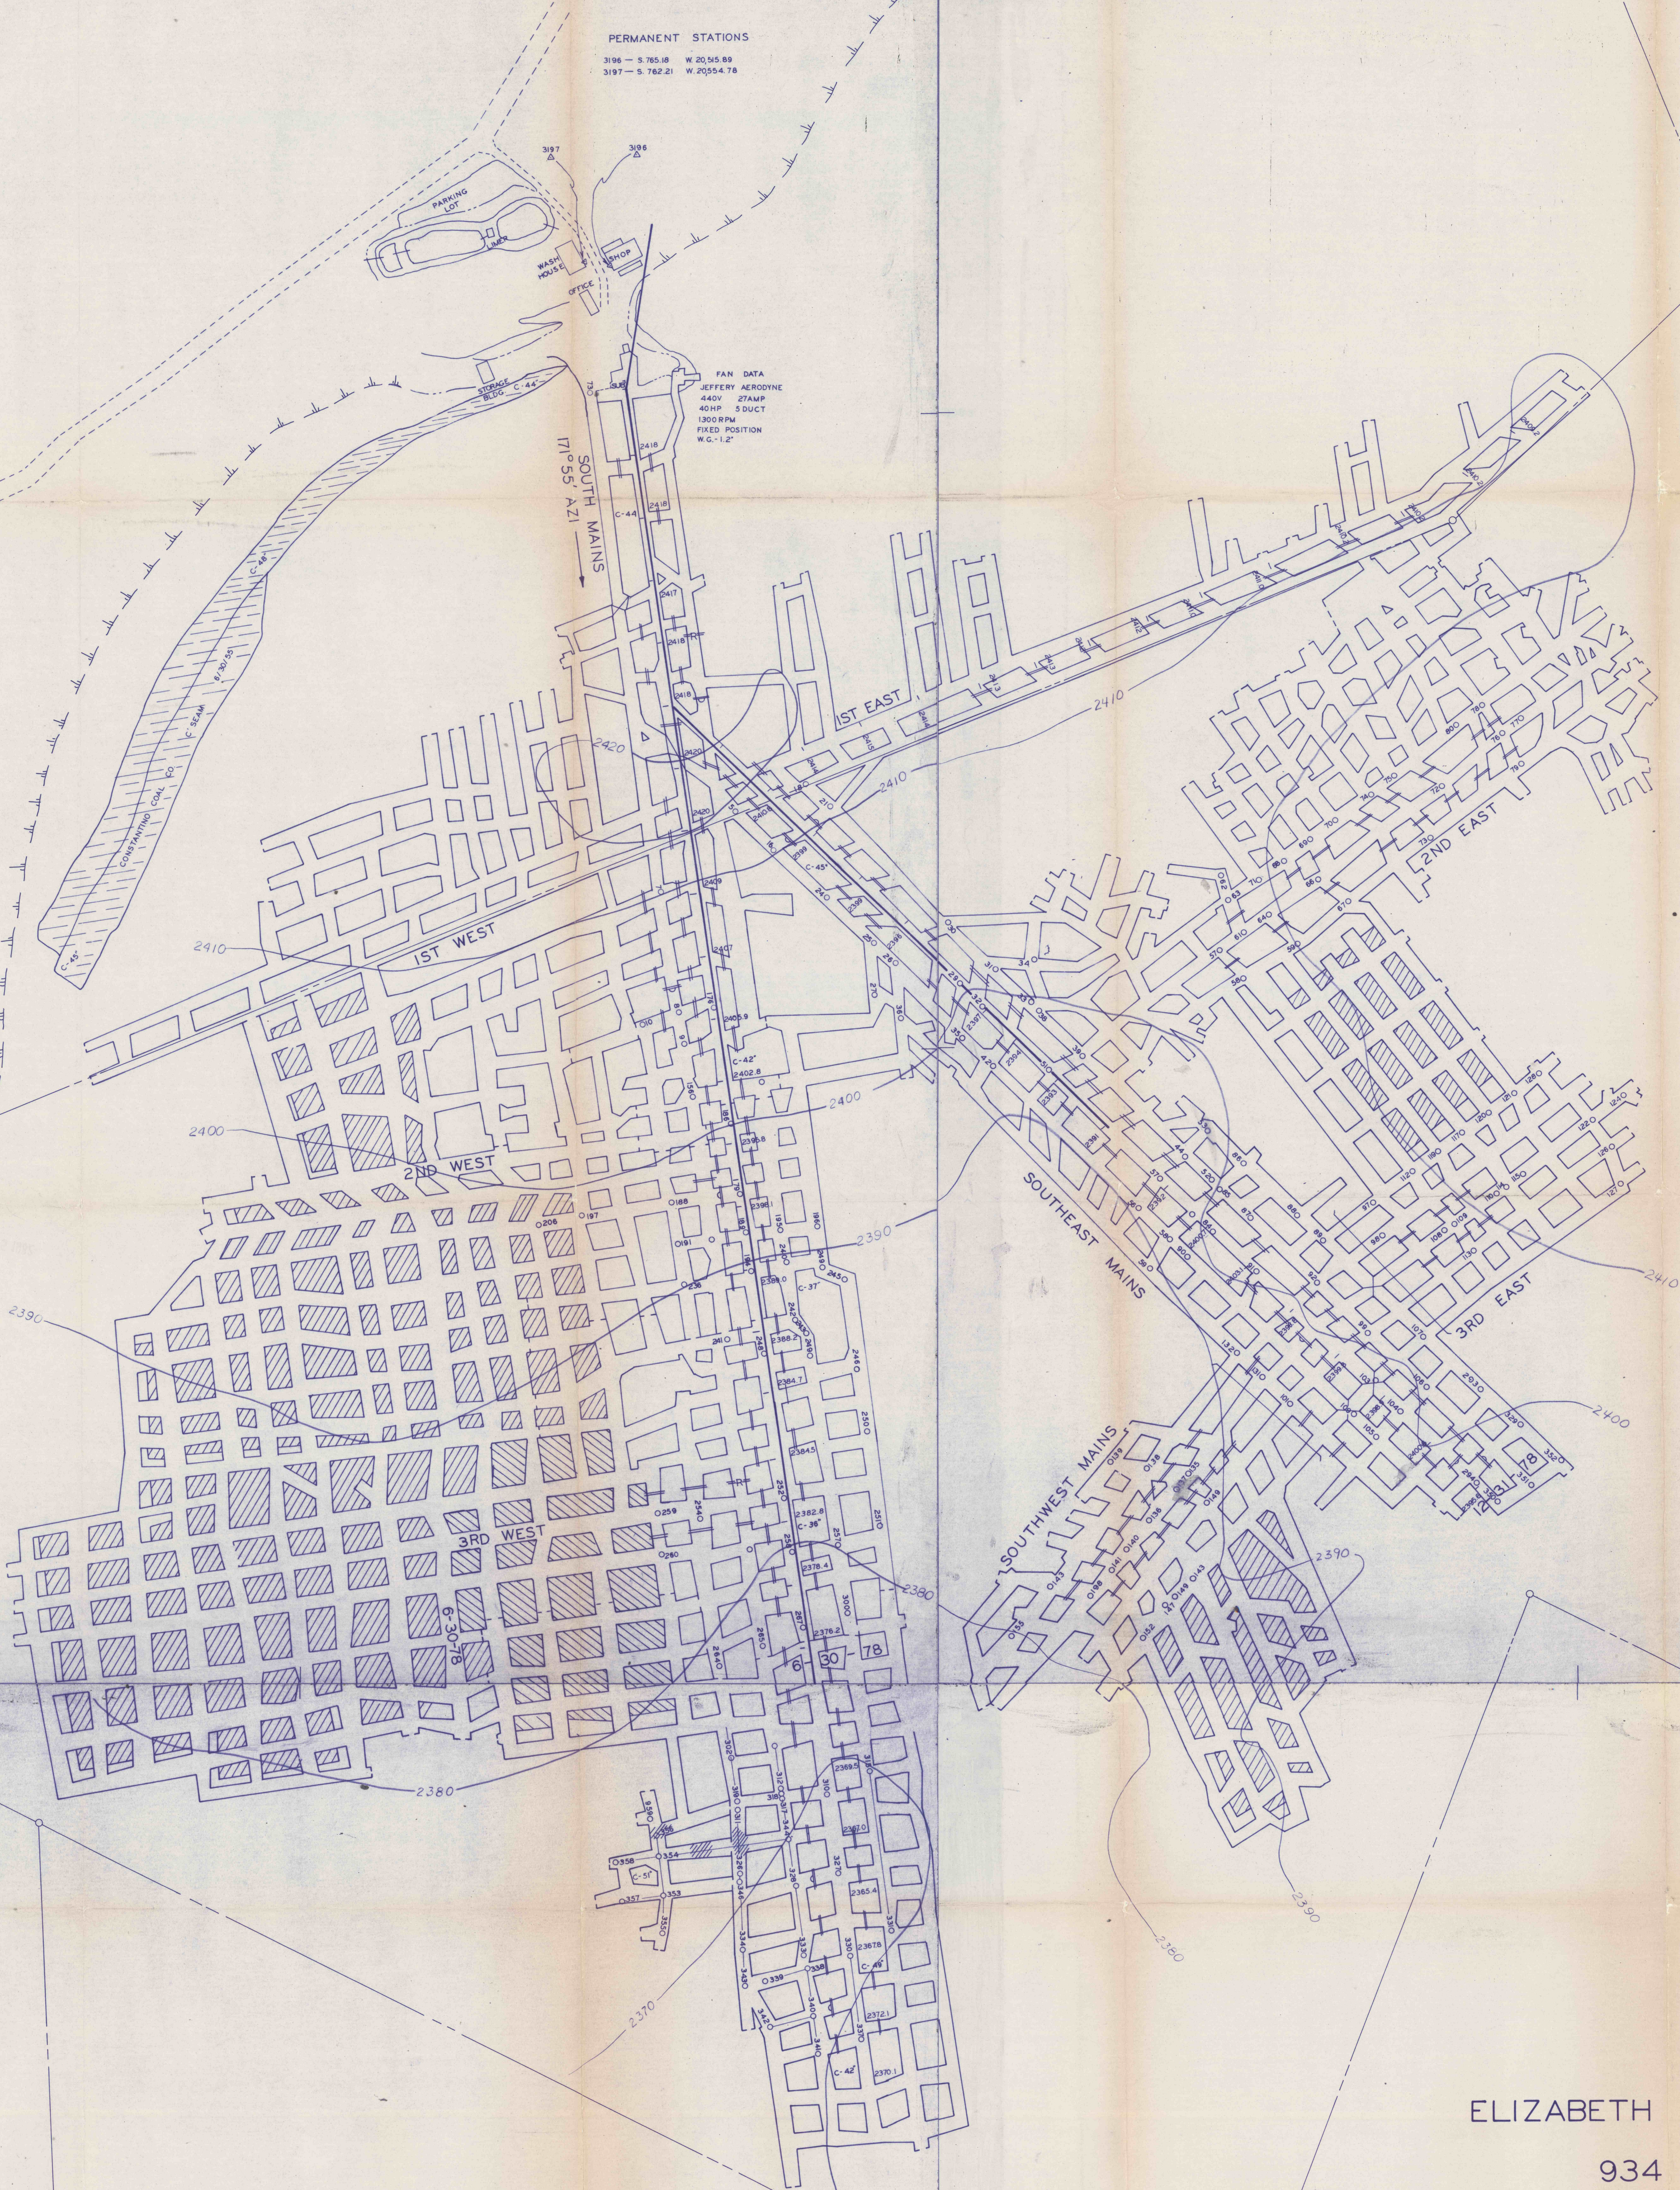

ELIZABETH LAPE
934



REITZ COAL COMPANY
 REITZ NO. 23
 J.T. MINE
 UPPER KITTANNING SEAM
 SHADE TWP. SOMERSET CO.
 SCALE: 1" = 100' SURVEY DATE: 6-26-79

37-17
 BEL-28342
 DEL-28688
 FC-28444
 C-45