

MF CARD 7475

MF CARD 7474

~~#~~ #2285

GILBRAITH BROS.  
C. FRICK COKE CO'S COAL


# RIDER MINE.

OF THE  
WARNER-VOUGHIGHENY COAL COMPANY  
SITUATED IN  
FALLOWFIELD TOWNSHIP WASHINGTON COUNTY  
PA.

Scale = 1" = 100'

DATE OF SURVEY

A.	SURVEY TO DECEMBER 31 1914
B.	" " " AUGUST 4 1919
C.	" " " NOVEMBER 10 1919
D.	" " " DECEMBER 31 1919
E.	" " " 31 1920
F.	" " " 31 1921
G.	" " " 31 1922
H.	" " " 31 1923
I.	" " " 1924
J.	" " " MAY 1924
K.	" " " MAY 1925
L.	" " " DEC 1925
M.	" " " MAY 1926
N.	" " " JAN 15 1927
O.	" " " JUNE 1927
P.	" " " January 1929

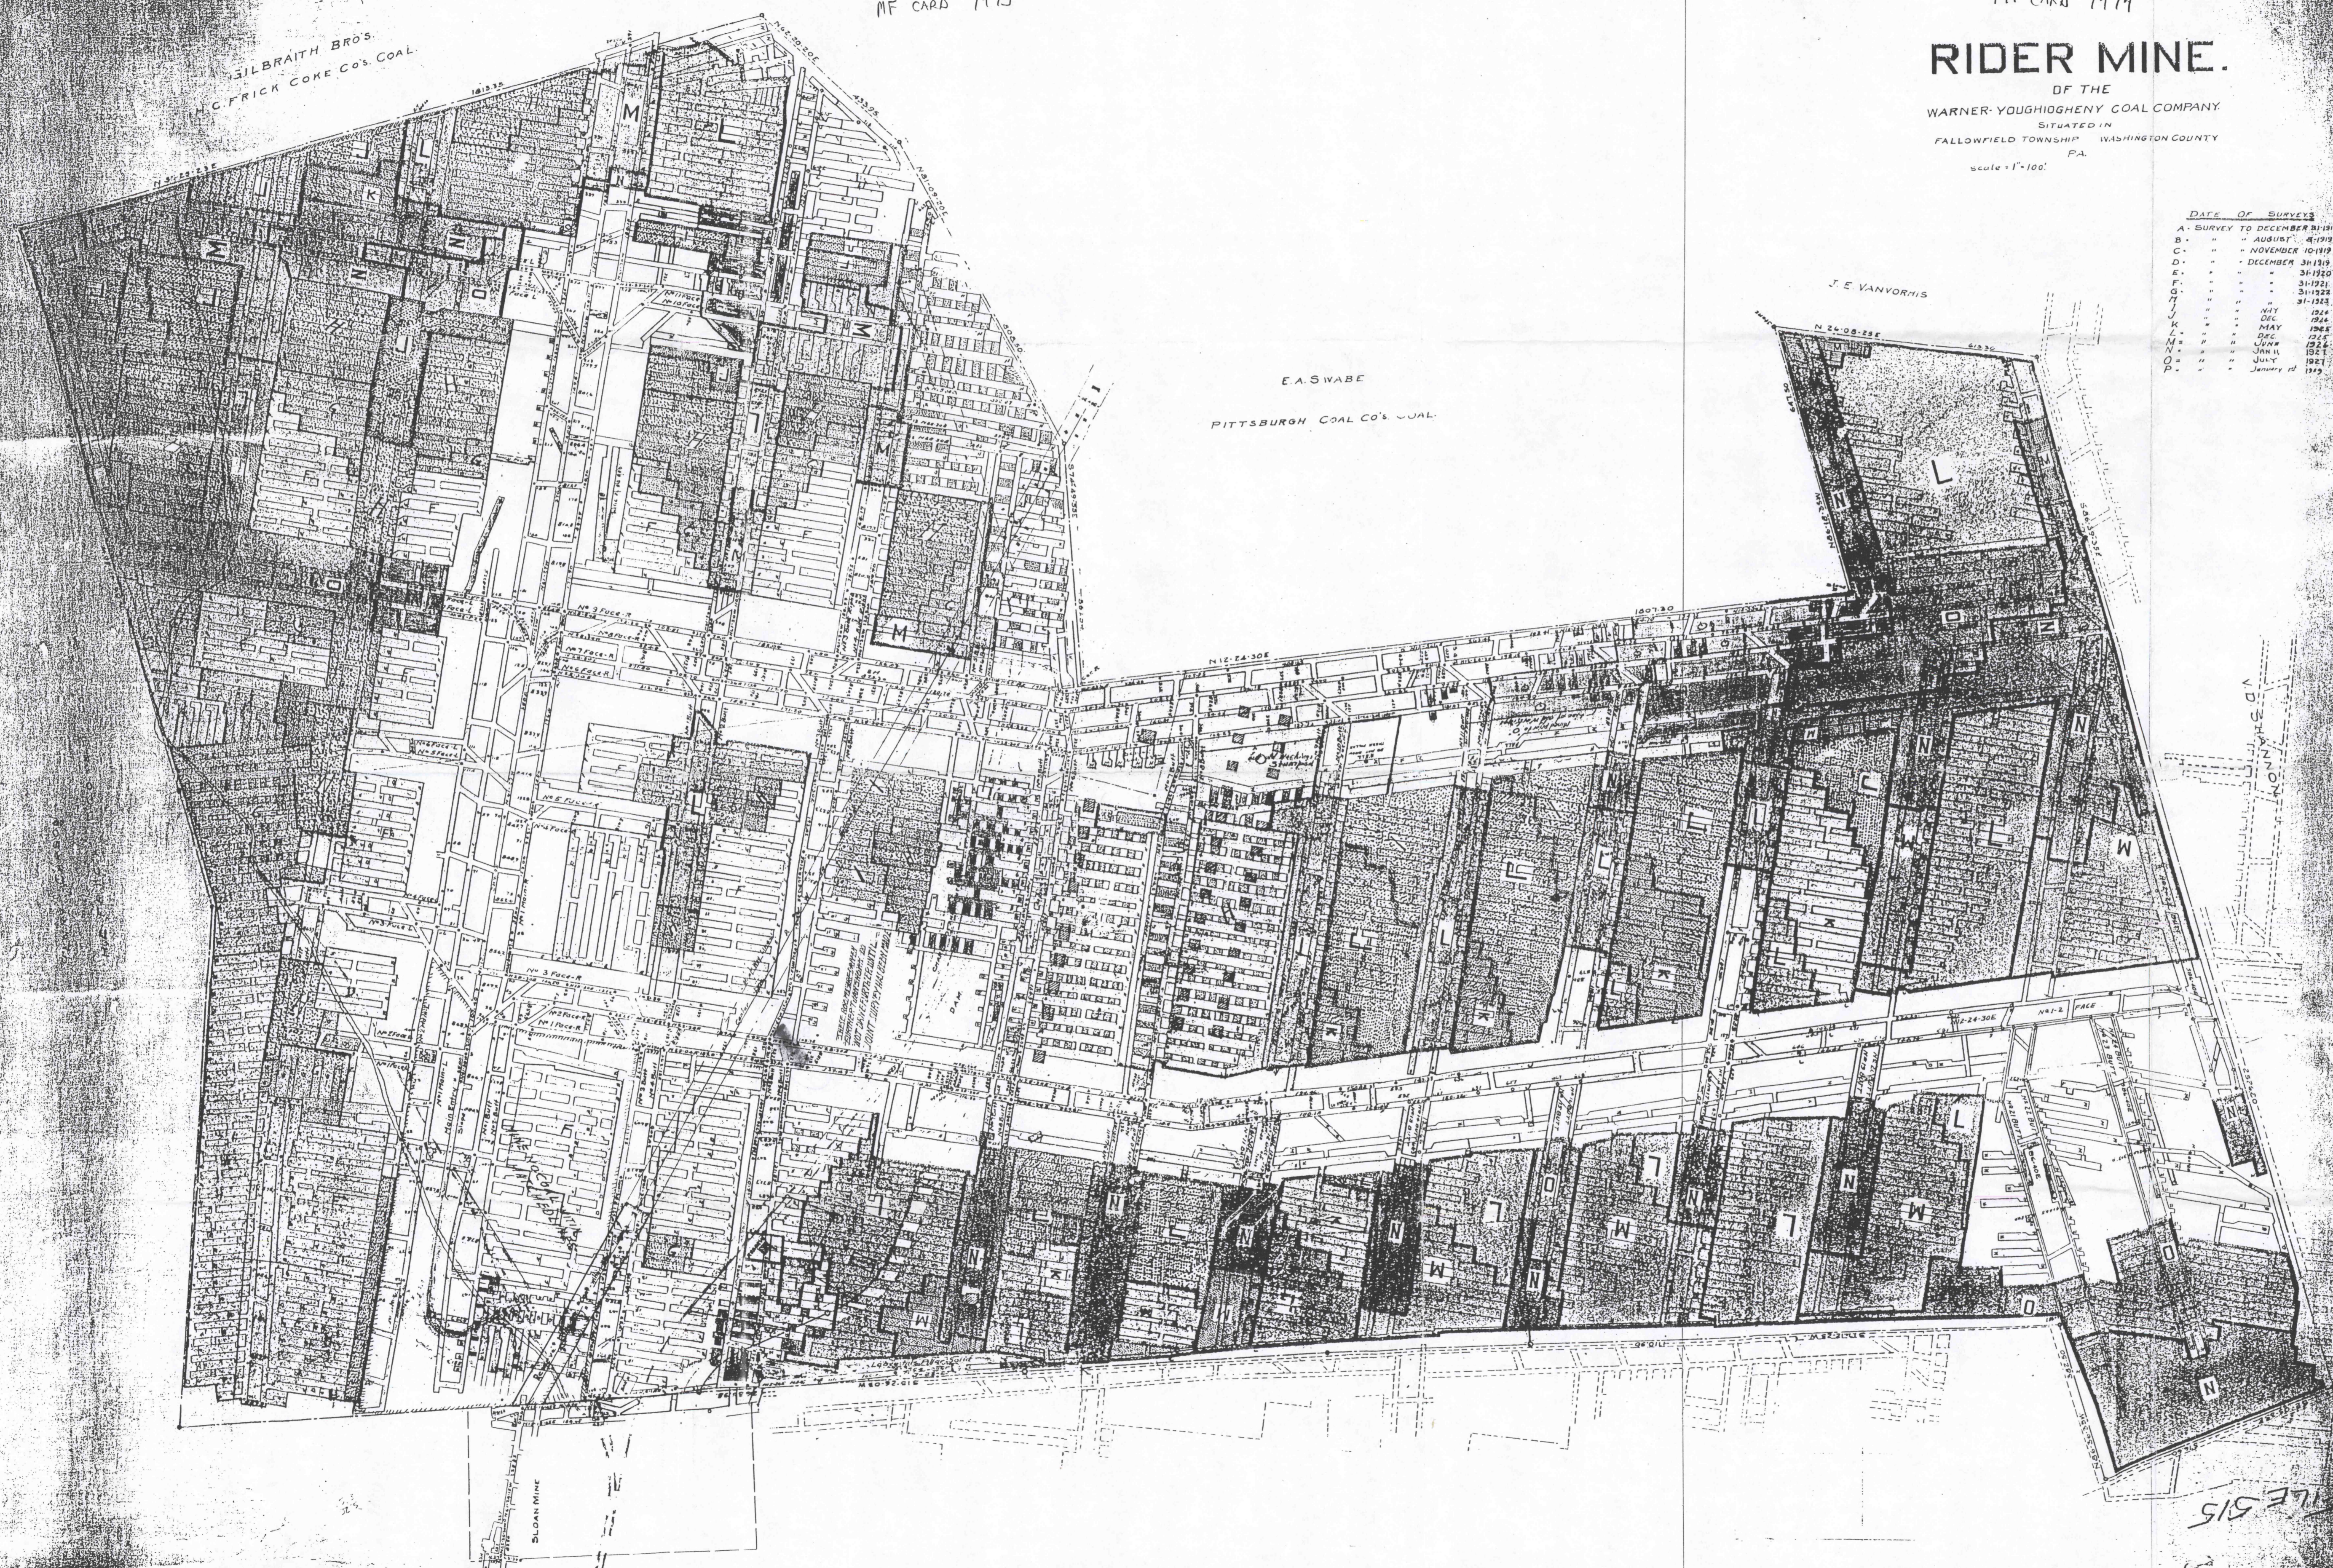

FILE 515