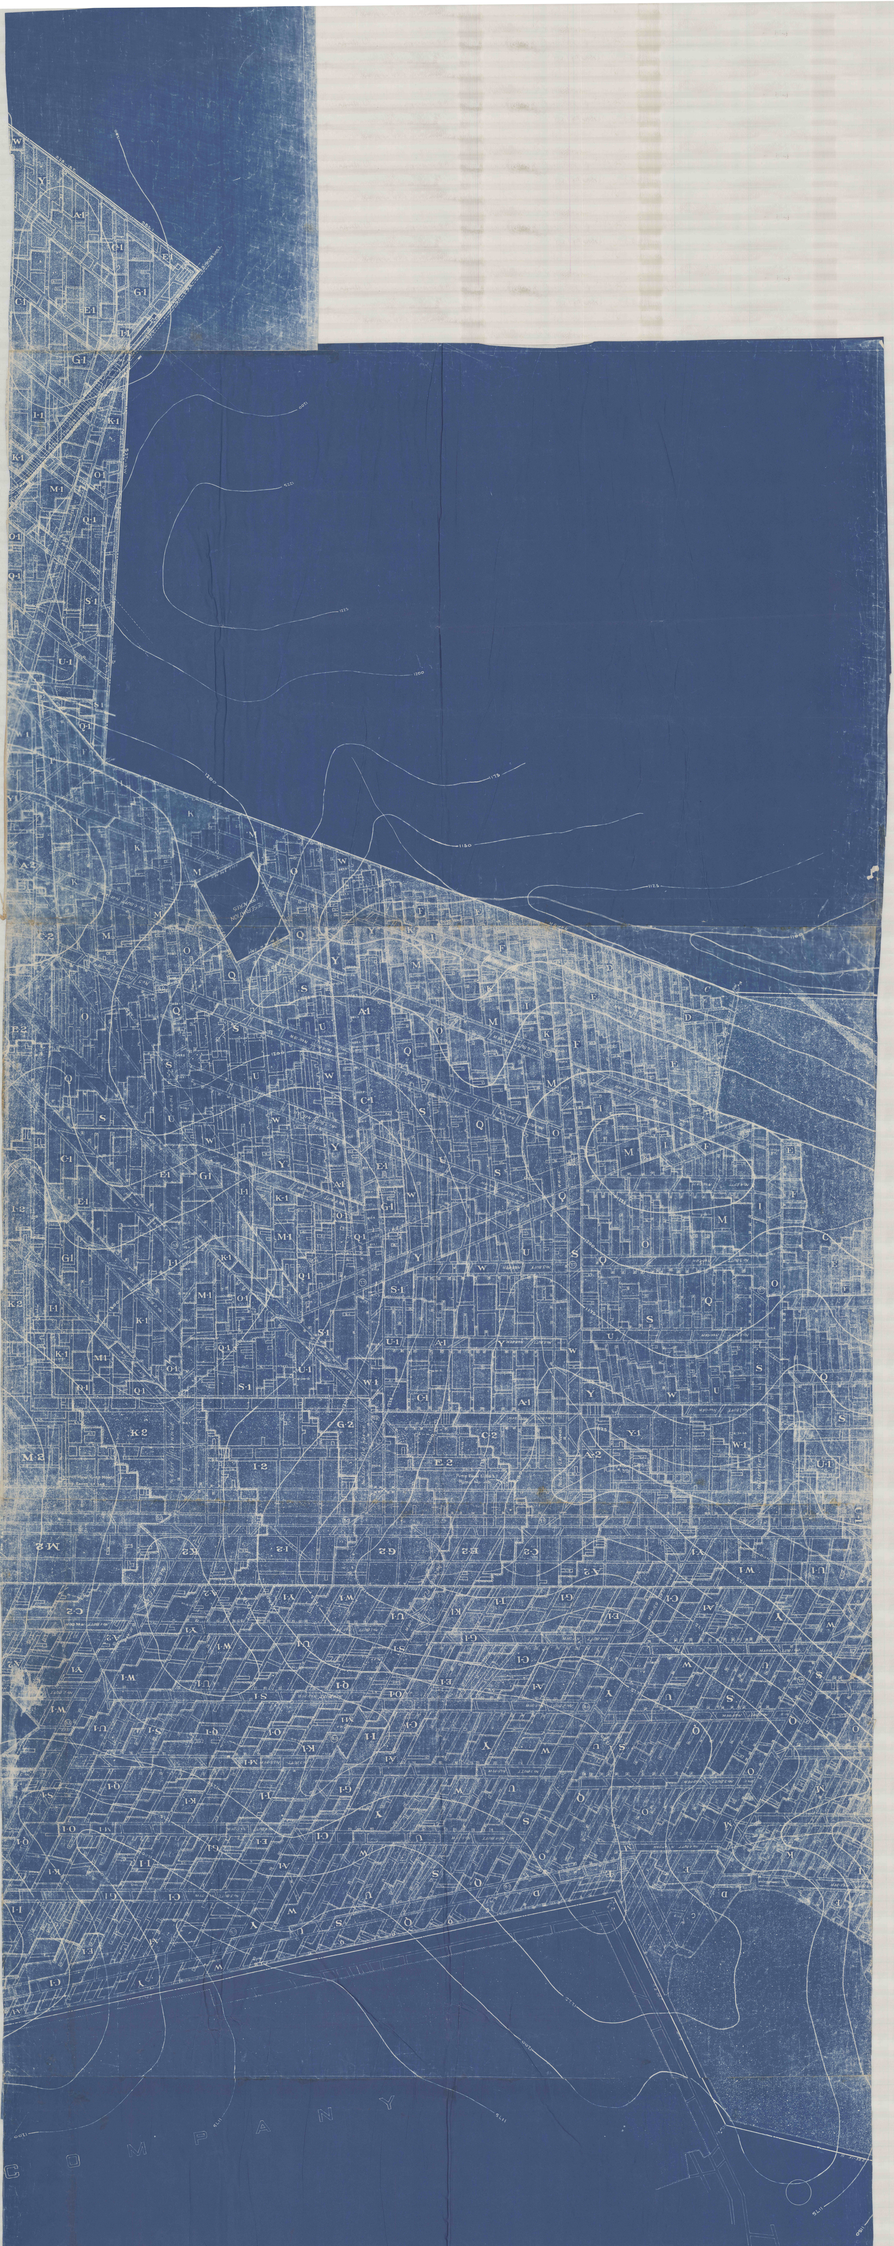


MAP OF
REVERE MINE
BELONGING TO
W. J. RAINEY
SOUTH UNION & GEORGES TWPS.
FAYETTE CO., PA.

Scale – 1 in. = 100 ft.

1913