



Nancy Lehman
Tract 667

Mined out - Reitz Coal Co
No 5 mine

Strip mined
2-10-50

Strip mined
7-1-50

Mary Polly Weaver
Tract 676

Strip mined

Strip mined


I. Heroby certify that
this blue print is a true and
Correct copy of the original
map of the Richard Vogel mine
and that the original map is
a true complete and correct
map and survey of all the
excavations made in said mine

Oliver Lee Hoffman

Samuel Weaver
Tract 659

mine Abandoned
June 15 1962

Richard Vogel mine
C Prime seam.
Point Twp Somerset Co. Pa.
Scale 1"=100' Dec 1947
Lease Assigned to
Herbert Hoffman.

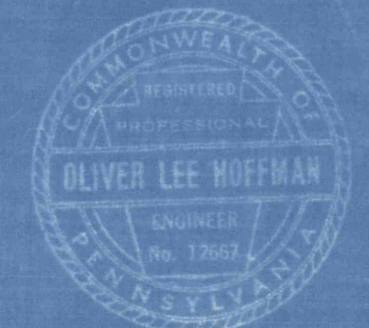

#2293
-G-2000
100

Reitz - Jan 15 1947
Jack L. Mangels Tract 665 - 0.140 Ac
Mary Polly Weaver Tract 676 - 0.122 Ac