


RICH HILL No. 1 MINE
 WORKING AREAS - "E" SEAM
 MINING COMPLETED FEB. 28, 1967
 FINAL MAP
 SCALE 1" = 100'

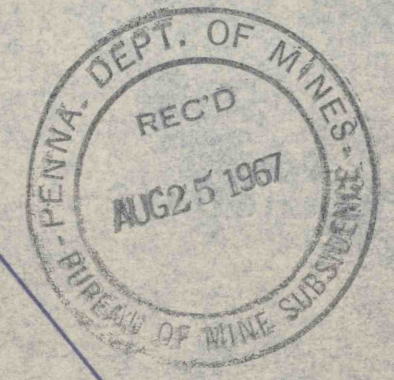

Benjamin R. Auer

#2295
 1-10-2000
 C.C.