

MINING COMPLETED

RESERVATION

ROBERTS NO. 1

ROBERTS NO. 2


N 12,000

N 11,000

N 10,000

RESERVATION

RESERVATION

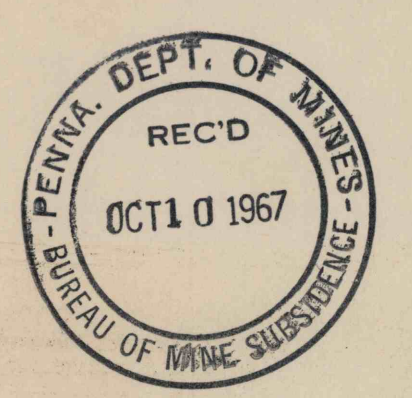

**LEGEND**

- PROJECTED 6 MONTHS WORK
- SURFACE STRUCTURES
- SUPPORT AREA
- MINING COMPLETED AS OF DATE LISTED
- BOUNDARY LINE OF MINE

**THE FLORENCE MINING CO.**  
 SEWARD, PA.  
 RICHARD'S RUN MINE  
 DATE: 9-1-67 SCALE: 1"=100'  
 EAST & WEST WHEATFIELD TWP  
 INDIANA CO.

Benjamin R. Allen  
J.E.F. 74247

#19306  
1-6-67  
C.S.