

RESERVATION

J. M. DUNCAN NO. 1

THIS AREA WORKED OUT FROM ELLEN MINE


RED OUTLINE INDICATES AREA TO BE MINED FROM 9-1-67 TO 9-1-68

DATE OF LAST SURVEY

1-1-61	1-1-62
1-1-63	1-1-64
1-1-65	1-1-66
1-1-67	1-1-68

- LEGEND**
- PROJECTED 6 MONTHS WORK
 - SURFACE STRUCTURES
 - SUPPORT AREA
 - MINING COMPLETED AS OF SET LIGHT
 - BOUNDARY LINE OF MINE

THE FLORENCE MINING CO.
SEWARD, PA.
RICHARD'S RUN MINE
DATE: 9-1-67 SCALE: 1"=100'
EAST & WEST WHEATFIELD TWP.
INDIANA CO.

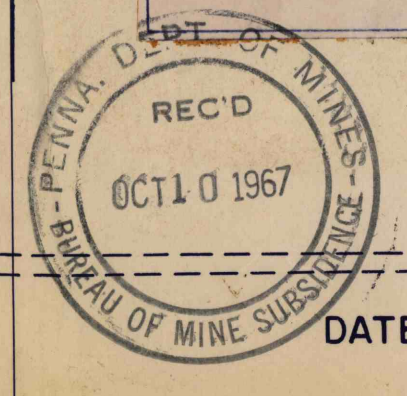

DATE: 12-20-60

WEST WHEATFIELD TWP.

SCALE: 1"=100'