

RINGGOLD MINE  
DOVERSPIKE BROS. COAL CO.  
MINING COMPLETED AS SHOWN 11-30-76

NORTH

DOVERSPIKE BROS.

DOVERSPIKE BROS.

SHEET 2

DOVERSPIKE BROS.

JAMES E. MARTZ

JAMES E. MARTZ

JAMES E. MARTZ

J. I. BULLERS

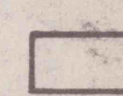
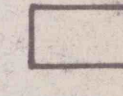

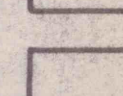

J. I. BULLERS

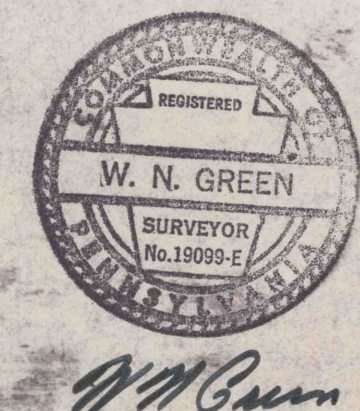
MINING COMPLETED AS SHOWN 11-30-76

RINGGOLD MINE MAP  
DOVERSPIKE BROS. COAL CO.  
RINGGOLD TOWNSHIP, JEFFERSON COUNTY  
PENNSYLVANIA

LEGEND

SCALE: 1"=100'

-  CONTEMPLATED MINING FROM 7-1-74 TO 11-30-76
-  MINING COMPLETED
-  PROTECTED STRUCTURE
-  SUPPORT AREA-NO MINING
-  50% MINING AREA



NORTH

SHEET-1

#208  
1-6-2000  
CC