


5TH PROJECTION  
OFFICE COPY

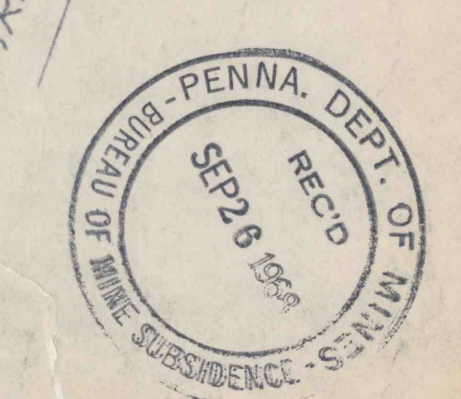

MAP SHOWING A SEAM DEEP MINE NO. 3  
OPERATED BY RIVERHILL COAL COMPANY INC.  
COOPER TOWNSHIP CLEARFIELD COUNTY PENNA.  
SCALE 1/2" = 100' JULY 7, 1966  
BERNARD LUCAS ASSOCIATES

#3381  
6-20-66